

## Lloyd's Register of Shipping.

Ship's Name "SHELL MEX 4."

Official No. 146194.

Memorandum of alterations reported since ship was surveyed for assignment of Load Lines in \_\_\_\_\_

Additional gunners' accommodation erected at fore-castle front.


Steel house 8'-0" x 8'-0" full height of fore-castle.

$\frac{5}{16}$ " plating efficiently stiffened by 3 x 3 x 30 angles spaced 24"

opening in side 47" x 23" closed by hinged wood door operated both sides — coaming 18"

2 portholes fitted with efficient hinged steel deadlights. 1 @ 12" dia. & 1 @ 16" dia.

Down-down mushroom ventilator fitted on top.

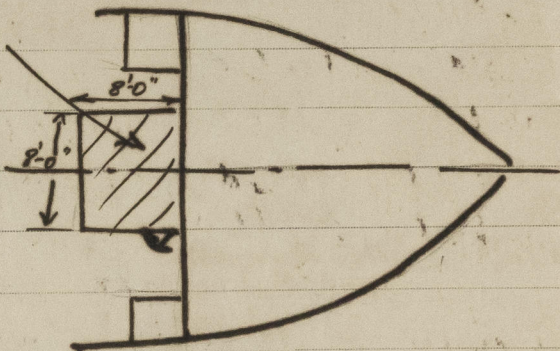

Steel weather screens fitted P.S. from casing of port to bulwork, efficiently connected and stiffened.

Hinged steel watertight doors fitted 1 P.S. operated both sides.

Bulwork plating P.S. abreast forward end of casing carried up to boat deck as additional protection.

Stringer bar crossed P.S. for scupper 7" in length (above gunboard deck) abreast forward end of casing.

Copy of this report placed on board with C11

Noted S.W.B.

Alfred R. H. H.

Birkenhead

22/6/43

23 JUL 1943