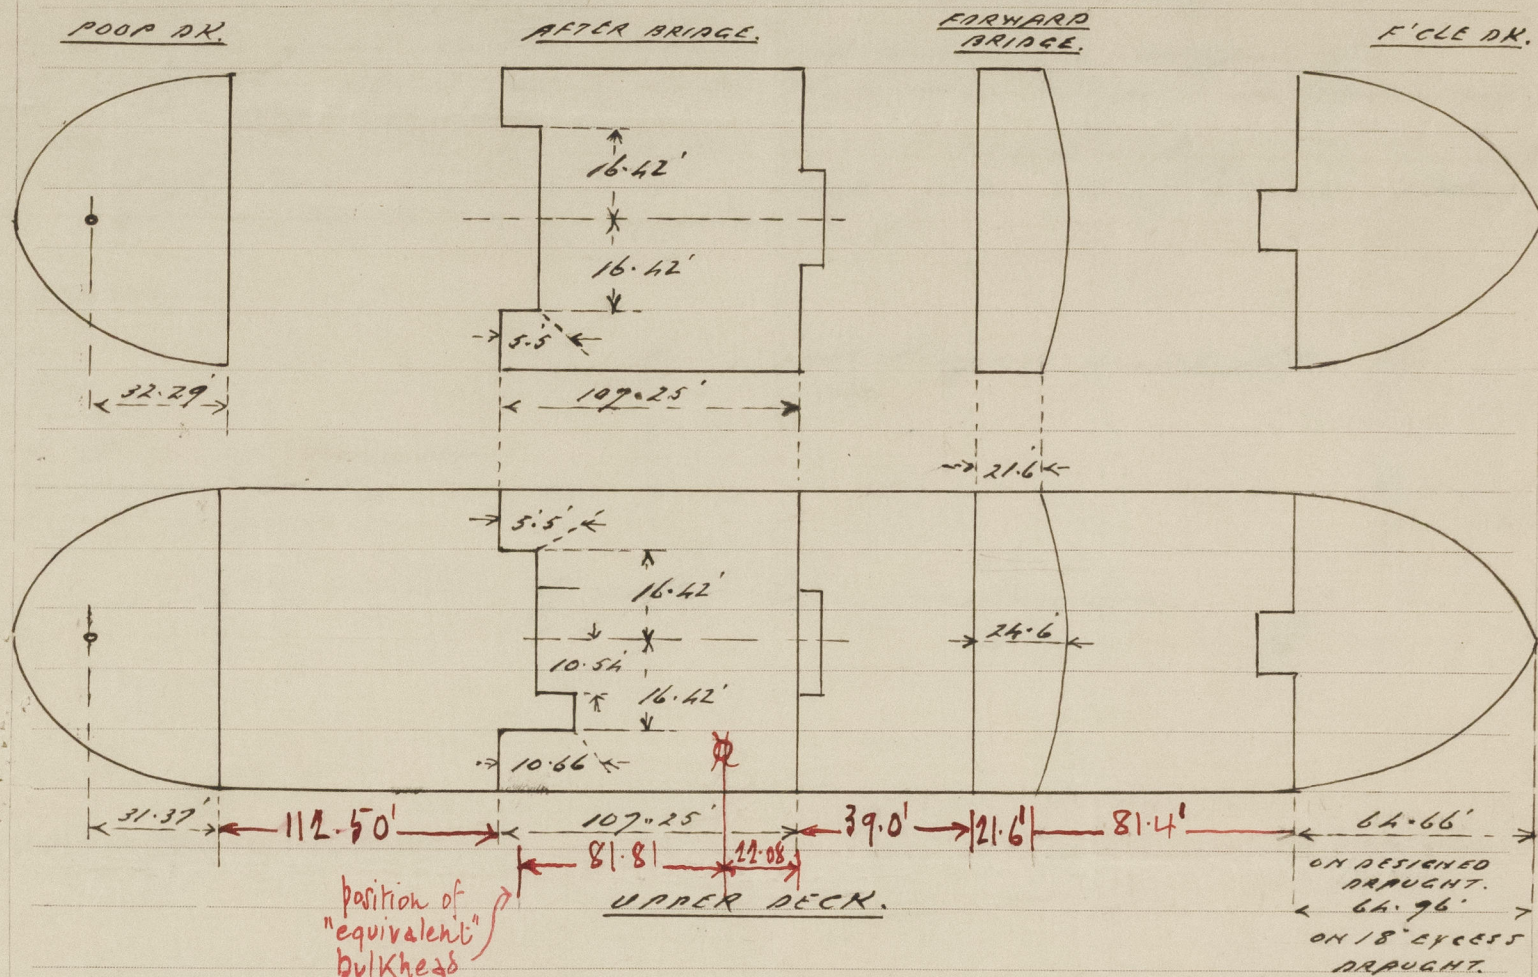


Lloyd's Register of Shipping. 12 JUN 1942

Ship's Name "EMPIRE MIGHT"

Official No.

Memorandum of alterations reported since ship was surveyed for assignment of Load Lines

in Erections on upper deck.

N. L. Swinton

12 June 1942.