

Lloyd's Register of Shipping. SURVEYS FOR FREEBOARD.—STEAM SHIPS.

Index No.
(For London Office only.)

N^o 1297.

PARTICULARS RELATING TO ALL STEAM SHIPS EITHER ~~WITH~~ ^{SHELTER} ~~TOP GALLANT FORECASTLES, SHORT POOPS AND BRIDGE HOUSES DISCONNECTED,~~ ~~WITH TOP GALLANT FORECASTLES HAVING LONG POOPS, OR RAISED QUARTER DECKS~~ ~~CONNECTED WITH BRIDGE HOUSES, OR OTHERWISE.~~

Port of Survey Nagasaki
Date of Survey 12th June '20.
Name of Surveyor R Crawford.

Ship's Name. "ARIZONA MARU"
YARD NO. 280.
Number in Register Book
Port of Registry and Nationality. Osaka Japanese
Official Number.
Gross Tonnage. 9695.77
Date of Build. 1920
Particulars of Classification. +100 A-1 Shelter Dk with freeboard contemplated.

Registered dimensions from ship's Register.	LENGTH.	BREADTH.	DEPTH.	UNDER DECK TONNAGE.
	<u>475</u>	<u>61.26</u>	<u>38</u>	<u>6867.39 U.K.</u> <u>8796.51 S.K.</u>
Length on LOADLINE.	<u>475</u>	Frame Depth <u>12</u> Rule <u>5</u> " <u>4</u> <u>- .66</u>	Ceiling <u>fitted</u> Sheer <u>+ .75</u> <u>= + .21</u> <u>5' drop in tank</u>	Peak } Incl Tanks } <u>such</u>
CORRECTED DIMENSIONS.	<u>475</u> <u>474.6</u>	<u>60.6</u>	<u>38.96</u>	<u>8796.51</u>

Moulded Depth as measured..... 32'-9" Up. Dk.
40'-9" Shelter Dk.
Addition for Keel below base line for draught record... 2.32...inches.

NOTE.—If the depth is measured when vessel is afloat, the details of measurement should be reported.

CORRECTION FOR LENGTH.

Length of Ship on Loadline.....
Length in Table
Difference
Correction for 10ft., Table A.
× Difference divided by 10
If $\frac{1}{10}$ ths length covered divide by 2

Table C.
(if required.)

CORRECTION FOR IRON DECK.

Proportion covered, if less than $\frac{1}{10}$ ths length covered
Thickness of usual wood deck, less stringer
Shelter Dk 3" O.P. Sheathing

CORRECTION FOR ROUND OF BEAM.

Breadth at Gunwale amidships.....
Round of Beam 15 1/4"
Normal round.....
Difference ÷ 2 =
Proportion of Deck uncovered (Para. 19)

NOTE.—The round of beam should be reported on the full breadth of vessel at the gunwale.

Co-efficient of fineness..... .784
Any modification necessary } C 578
[Para. 4 (a) to (e)]*
Co-efficient as corrected76 say .75 to main Dk

Sheer { Stem..... 114 } 162.5 ÷ 2 = 81.25...Mean 84.5
at { Sternpost ... 45.5 } 36 57.5
75
Sheer at $\frac{1}{8}$ of the length from { Stem 68.5 } 93.0 ÷ 2 = 46.5...Mean
Sternpost 24.5 } 55.2 84.5
Gradual mean Sheer
Standard mean Sheer [Table, Para. 18]
Difference..... ÷ 4 =
§ If limited as Para. 18 (f)

Rise in Sheer { At front of bridge house.....
from amidships {
[Para. 18 (e)] { At after end of forecastle

¶ Fall in Sheer }
Para. 18 (d) } ÷ 2 =
Length uncovered
Correction

ALLOWANCE FOR DECK ERECTIONS :—

Freeboard, Table C.....
Correction for Length, if required (Para. 12, 13, and 14)
Freeboard by Table A, corrected for sheer, and for length, }
if required (Para. 12, 13, and 14) }
Difference
Percentage as below.....

Correction for R. Q. Dk. if engine and boiler openings not covered by bridge house (Para. 11)
Allowance for Deck Erections

	Length.	Length allowed.	Height.
Forecastle.....	<u>86.21</u>		<u>7.5</u>
Bridge House	<u>30.00</u>		<u>7.75</u>
Raised Qr. Dk.....			
oop.....	<u>34.79</u>		<u>7.5</u>
Total			

Length of Ship
Corresponding percentage {
(Para. 11, 12, 13, or 14) }

FREEBOARD recommended amidships from centre of Disc to top of Statutory Deck Line, Wood (Iron) Deck :—
Fresh Water Line above centre of Disc ...
Indian Summer Line " " " ...
Winter Line below " " " ...
Winter North Atlantic Line " " " ...

Winter Freeboard
Summer Freeboard
Indian Summer Freeboard
N. A. Winter Freeboard

Correction necessary because clearside amidships, measured in accordance with the Statute is not taken at the intersection of the wood or iron deck with side.

1 1/2" above wood shelter dk at side.

Winter Freeboard from deck line
Summer " " "
Indian Summer " " "
N. A. Winter " " "

13'-1 1/2" for all seasons.

If the frames, skin planking, or ceiling are of unusual thickness the breadth of vessel to inside of ceiling should be reported if possible.
In vessels obtaining an allowance for deck erections under Para. 11 where the sheer drops abaft amidships the height of the R.Q.D. is to be taken from the level of the top of the amidship beam.
In flush-decked vessels the total standard mean sheer means the sheer measured at the stem and stern-post. In vessels having poops and forecastles, it means the sheer measured at points distant one-eighth of the vessel's length from stem and stern-post.

† State dimensions of freeing port area on back of this form.

‡ The Surveyor should state whether the fall in sheer as reported is measured relatively to the straight line of keel or to the water line. If measured relatively to water line the vessel's draft at time of survey, and also the usual load draft forward and aft should be reported.

Do all the Frames extend to the top height in the Poop? *Yes* Raised Quarter Deck? *Yes* Bridge House? *Yes* Forecastle? *Yes*
 To what height do the Reverse Frames extend? *Channel Frames.*
 Has the Poop or Raised Quarter Deck an efficient Iron Bulkhead at the fore end? *Yes*
 Give particulars of the means for closing the openings in Bulkhead *Hinged Steel W.I. Doors.*
 Is the Poop or Raised Quarter Deck connected with the Bridge House? *No* Has the Bridge House an efficient Bulkhead at the fore end? *No.*
 Give particulars of the means for closing the openings in Bulkhead *Hinged Steel W.I. Doors.*
 What is the thickness of the Bridge Front plating? *40"* and Coaming plate? *44"*
 Give scantlings and spacing of the Stiffeners *7 x 3 1/2" x 48" angles, 30" apart.*
 Are bracket plates fitted at each end of the Stiffeners? *Yes.* Are hor'l. brackets fitted connecting Bridge Bulk'd. with Bulwarks? *Yes*
 Has the Bridge House an efficient Iron Bulkhead at the after end? *Yes.*
 How are the openings closed? *Steel hinged doors.*
 Is the Forecastle at least as high as the main or top-gallant rail? *Yes* Has the Forecastle an efficient Iron or Wood Bulk'd. at after end? *Yes.*
 Are the Engine and Boiler openings covered by a Bridge, Poop, Raised Quarter Deck, or enclosed by a Strong Iron or Steel Deckhouse? *Yes. Steel Deckhouse.*
 If the openings are not so protected are the exposed parts of the Casings efficiently constructed? *Yes.*
 Give thickness of plating; scantlings and spacing of Stiffeners *✓*
 What is the height of the exposed Casings? *4' above Basal Dk.* Are suitable means provided for closing all openings in them in bad weather? *Yes.*
 Are the Weather Deck Hatchways efficiently constructed and at least equal to the requirements of Section 28 of the Rules for 1904-5? Give particulars below:— *Yes.*

Position and Size.		No. 1 30' x 18'	No. 2 25' x 20'	No. 3 18' x 20'	No. 4 15' x 20'	No. 6 18' x 16'		
Item.		Ship.	Rule.	Ship.	Rule.	Ship.	Rule.	
COAMING.	Height above top of DECK	24	24	24	24	24	24	
	Thickness {	Sides.....	.44	.44	.44	.44	.44	.44
		Ends.....	.44	.44	.44	.44	.44	.44
SHIFTING BEAMS OR WEB PLATES.	Number	4	6	3	2	3		
	Section and Scantlings	14' x 34' A	14 1/2' x 36' A	16 1/2' x 36' A	18" x 36' A	13' x 34' A		
	Material	Steel	4 x 3 x 44	4 x 3 x 44	4 x 3 x 44	3 1/2' x 3 x 42		
* FORE AND AFTERS.	Number							
	Section and Scantlings	None						
	Material							
HATCHES Thickness		3"						
Remarks.....		Good						

* The depth of Fore and Afters should be stated from the underside of the hatches in all cases.

(If the sill of the lowest side scuttle will be less than 6 inches above the Indian Summer Load Line if assigned under the tables, state vertical distance from top of deck at side amidships to lower edge of lowest side scuttle.)

The following information is to be given in all Cases of vessels dealt with under Paras. 11, 12 (under 15 feet Moulded depth) and under Shelter Deck Rules.

What is the thickness of the Bridge Sheerstrake? *1.067.86* Strake between Main and Bridge Sheerstrakes? *78*


Delete the words { The Crew ~~are~~ are not, berthed in the bridge house.
 that do not apply { The arrangements to enable them to get backwards and forwards from their quarters are, ~~are~~ not satisfactory.

Length of Bulwarks in well *228'*

Area of Freeing Ports required by Para. 11 (e) each side of vessel = *46.5* Sq. ft.

Ft. Tenths. Ft. Tenths. No. } Freeing Ports (each side of vessel) = *56.9* Sq. ft.

3.58 x 1.66 x 4 }
 3.81 x 1.66 x 4 }
 2.5 x 1.5 x 2 }
 Total deficiency or excess = *10.4* Sq. ft.

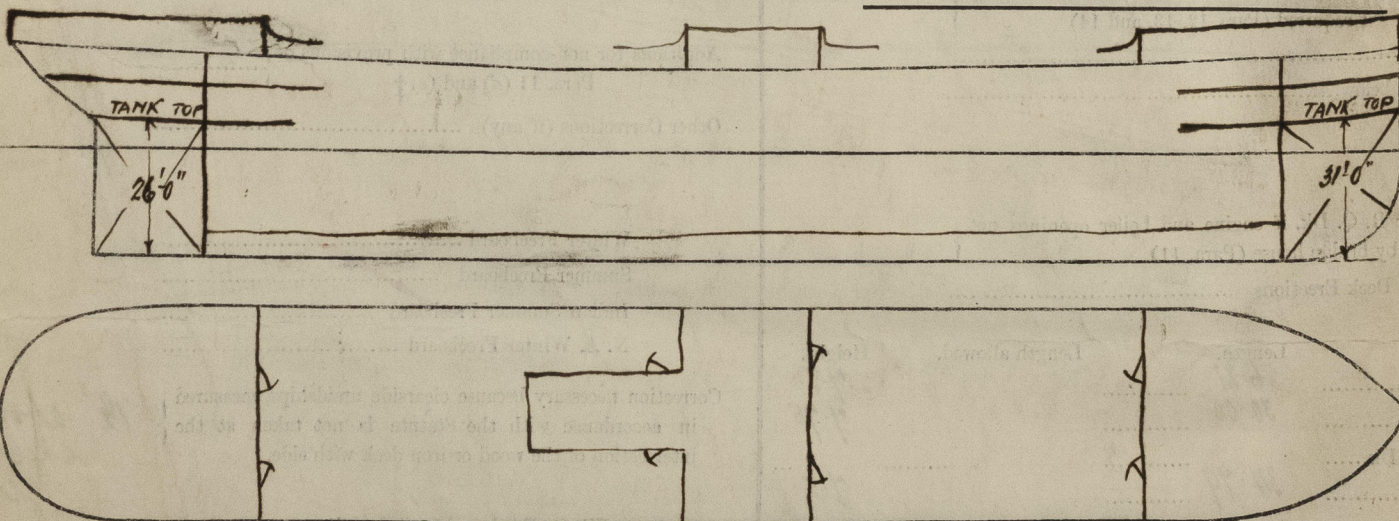

Show hereon line of Floors or Tank Top with position of any Breaks in same; also height of Peak Tank tops, &c., &c.

State any special features in the construction of the Vessel

Sister vessel to S.S. 'Arabia Maru'
Report No 1178. 1st Class passengers in Deckhouse 39.
Storage below Shelter Dk 336.

Owners *Osaka Shosen Kaisha*

Address

Fee & Yen: 160⁰⁰

Received by me

R. Crawford.



© 2020

Lloyd's Register Foundation