


“RESCUE” TYPE .

MURDOCH & MURRAY
SHIPBUILDERS
26/11/49
DRAWING OFFICE
W. H. H. H.
PORT-GLASGOW

ADMIRALTY:

SCALE $\frac{1}{2} = 1$ FOOT

SECTION THRO BOILER ROOM AT FRAME 37.

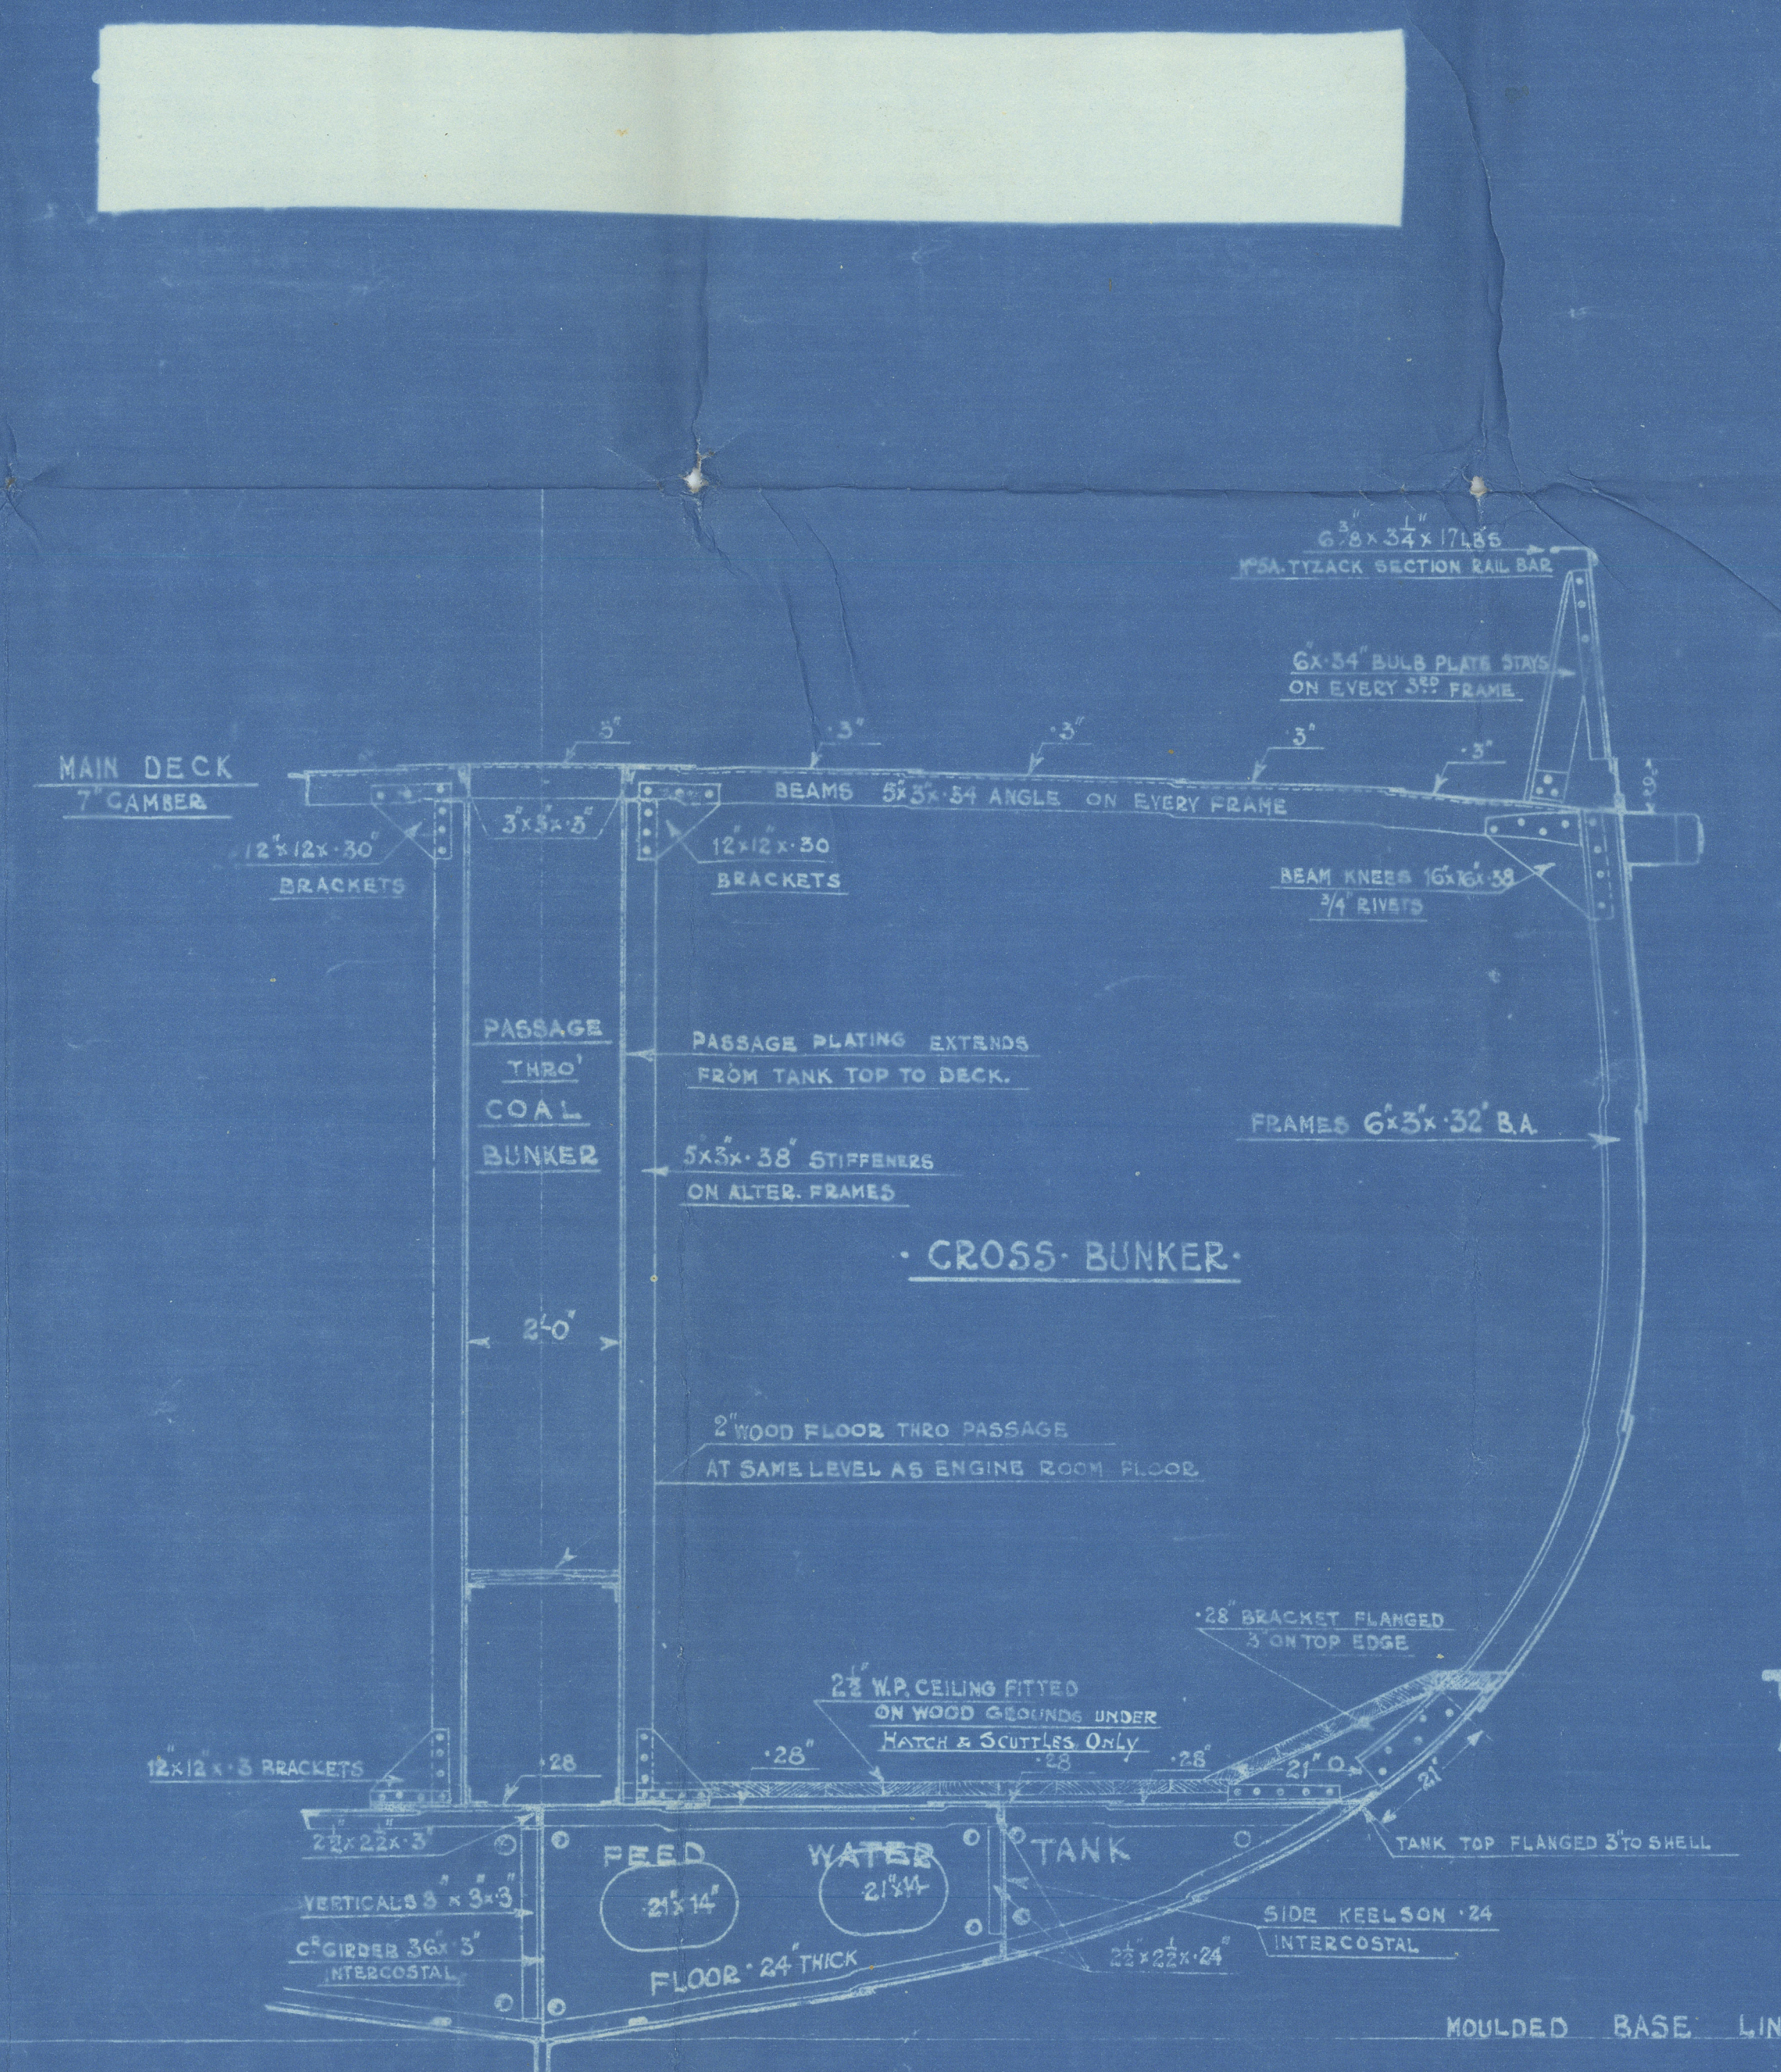


Messrs Murdock & Murray Ltd
No 295.

* S. S. St Kitts

Midship Section (as built)

Grk Rep No 14574.

DB 94T
" " "
NN. lko

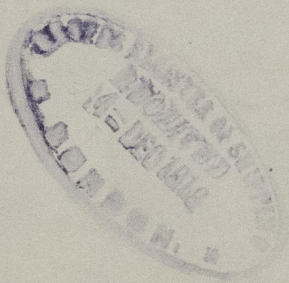

© 2020

Lloyd's Register
Foundation

005443-005452-0030