

MIDSHIP SECTION
1/4" SCALE

EQUIPMENT

1	ANCHOR	40 LBS. EX. STOCK
1	120 FATHOMS 1" STOD CHAIN	SPECIAL TEST
60	2	DEEL NIRS
60	4 1/2	HAULLIN

CN 11/10/24
123x21.5x14.5x7.5 = 328
40.5x14.5x7x.5 = 22
350

"SOUTHERN CHIEF" No 827
"SOUTHERN FORM" No 828

PROFILE & DECK PLANS

STEEL SHEEN WHALERS



1/4" SCALE

TO CLASS BRITISH CORPORATION B.S. (WHALER)
MINIMUM FREEBOARD REQUIRED IS 2' 3" TO CENTER OF DISC




BLACK INK ALTERATIONS TO PLAN
SHOW VESSEL AS BUILT

THESE ADDITIONS HAVE BEEN FITTED
TO GIVE EXTRA STRENGTH FOR WORKING
AT THE SOUTH SHETLANDS AMONGST ICE

9 OCT. 1924

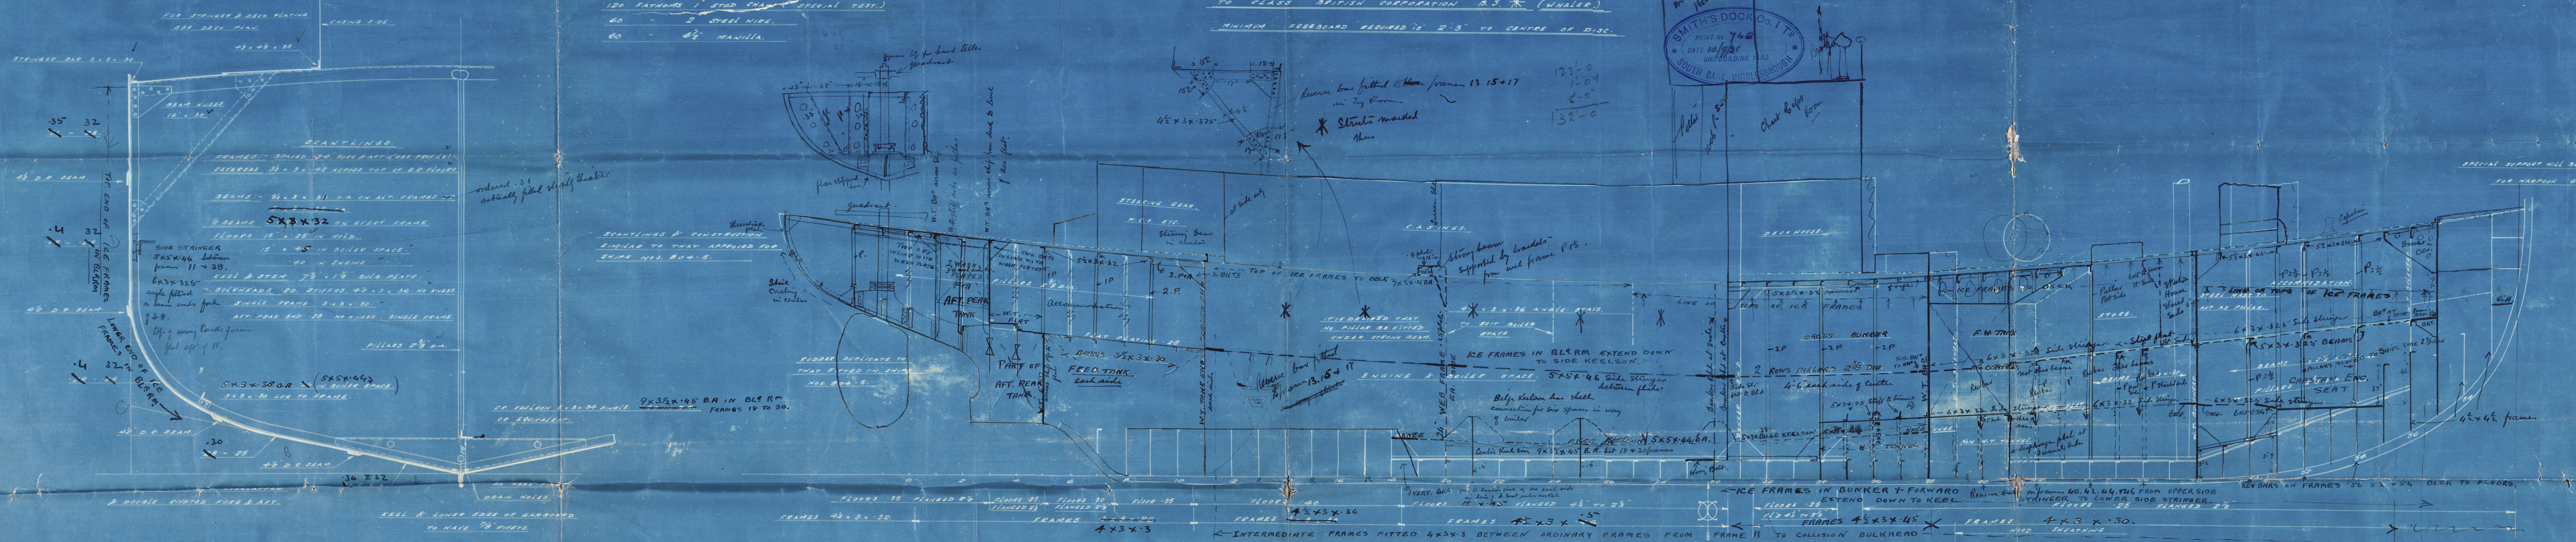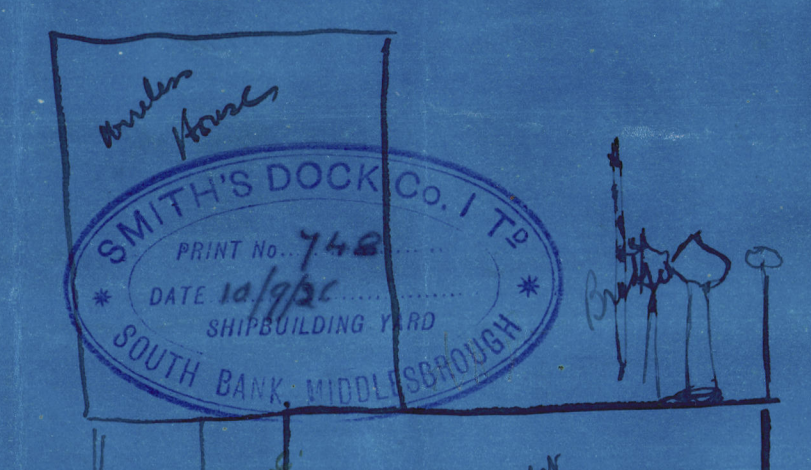

Chief

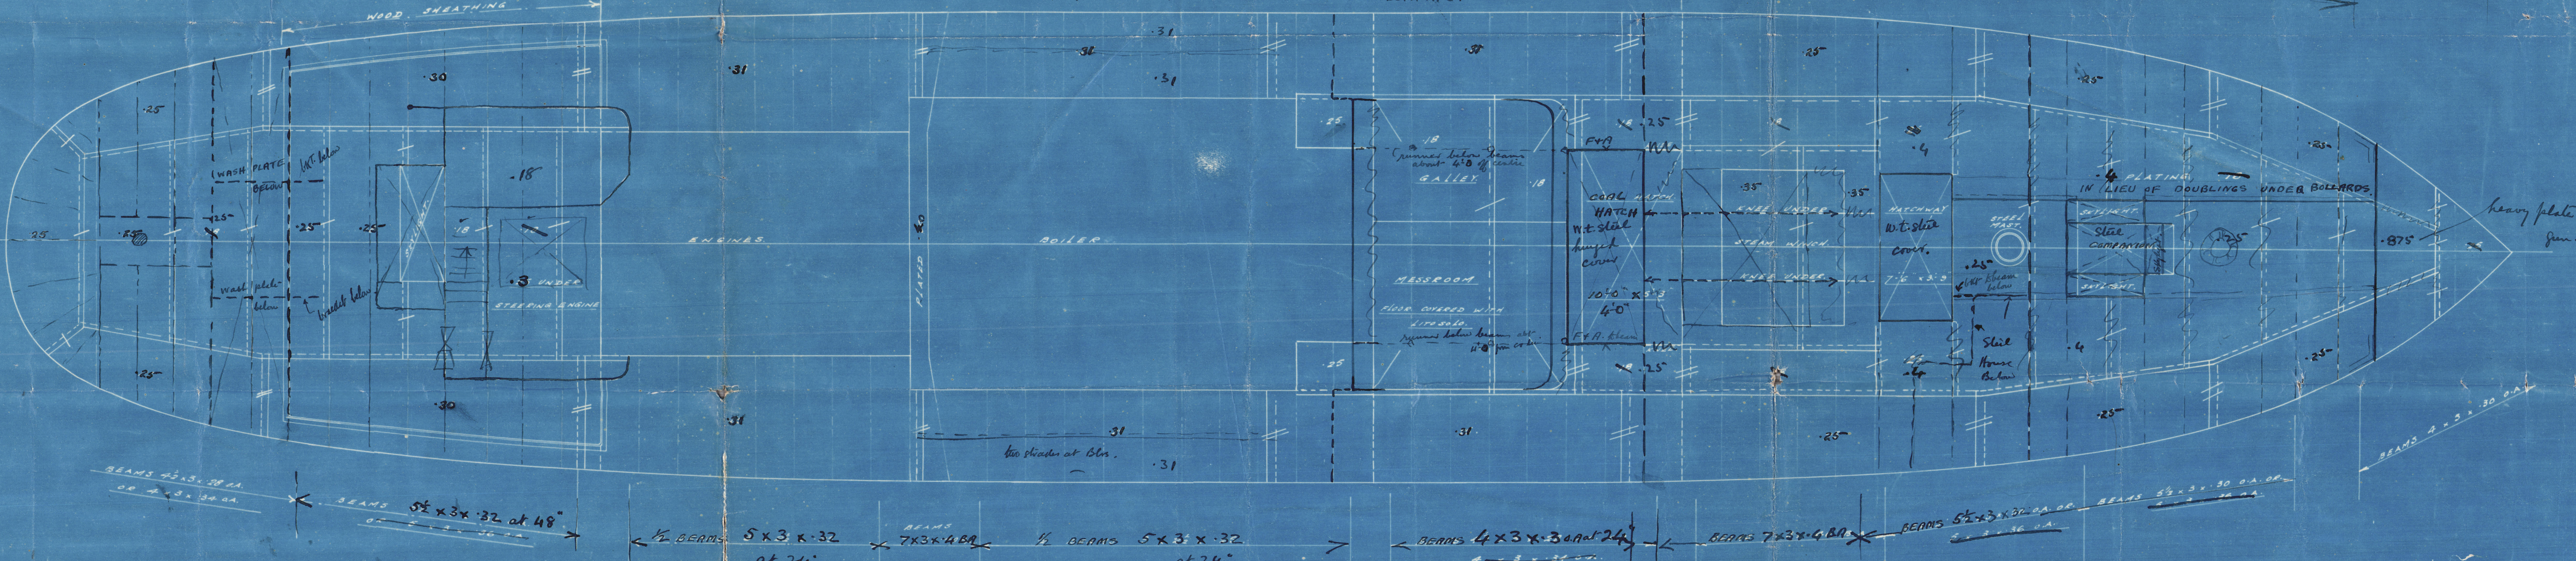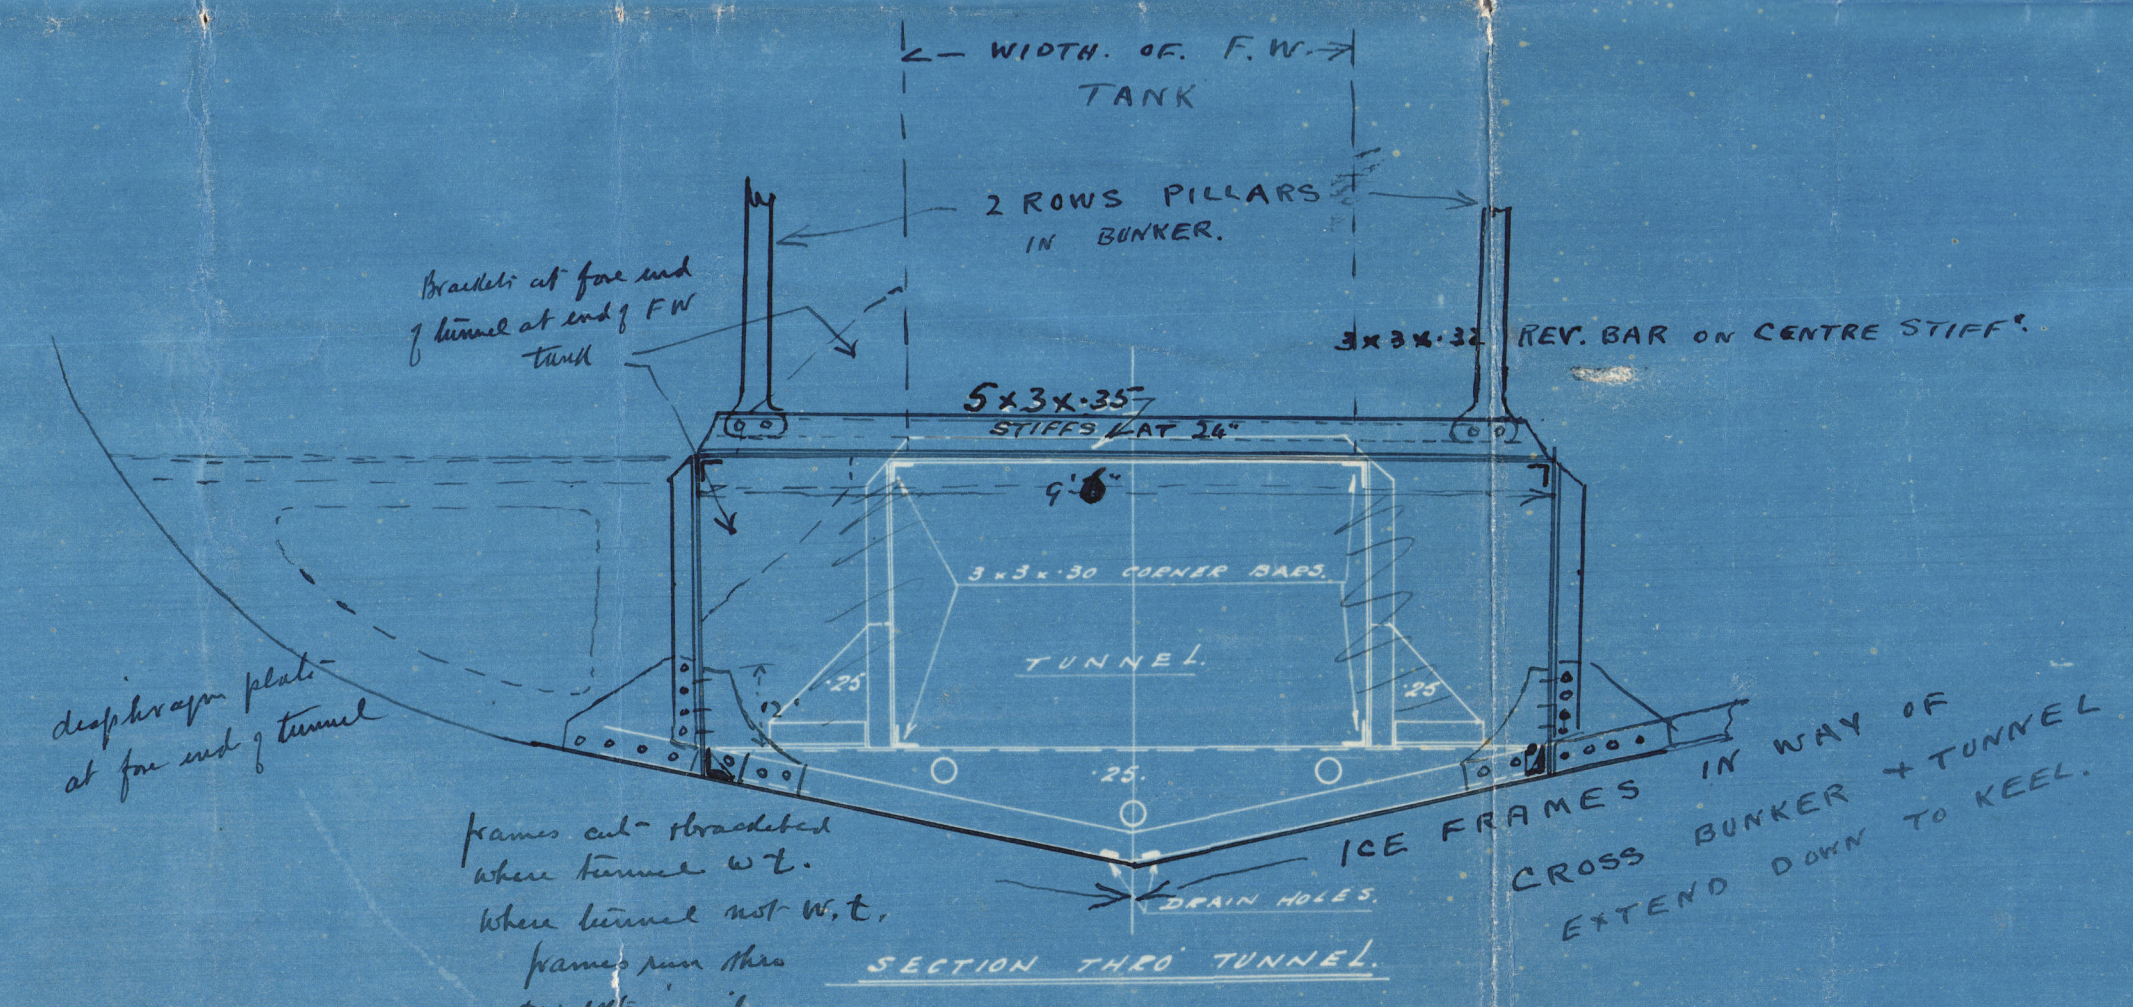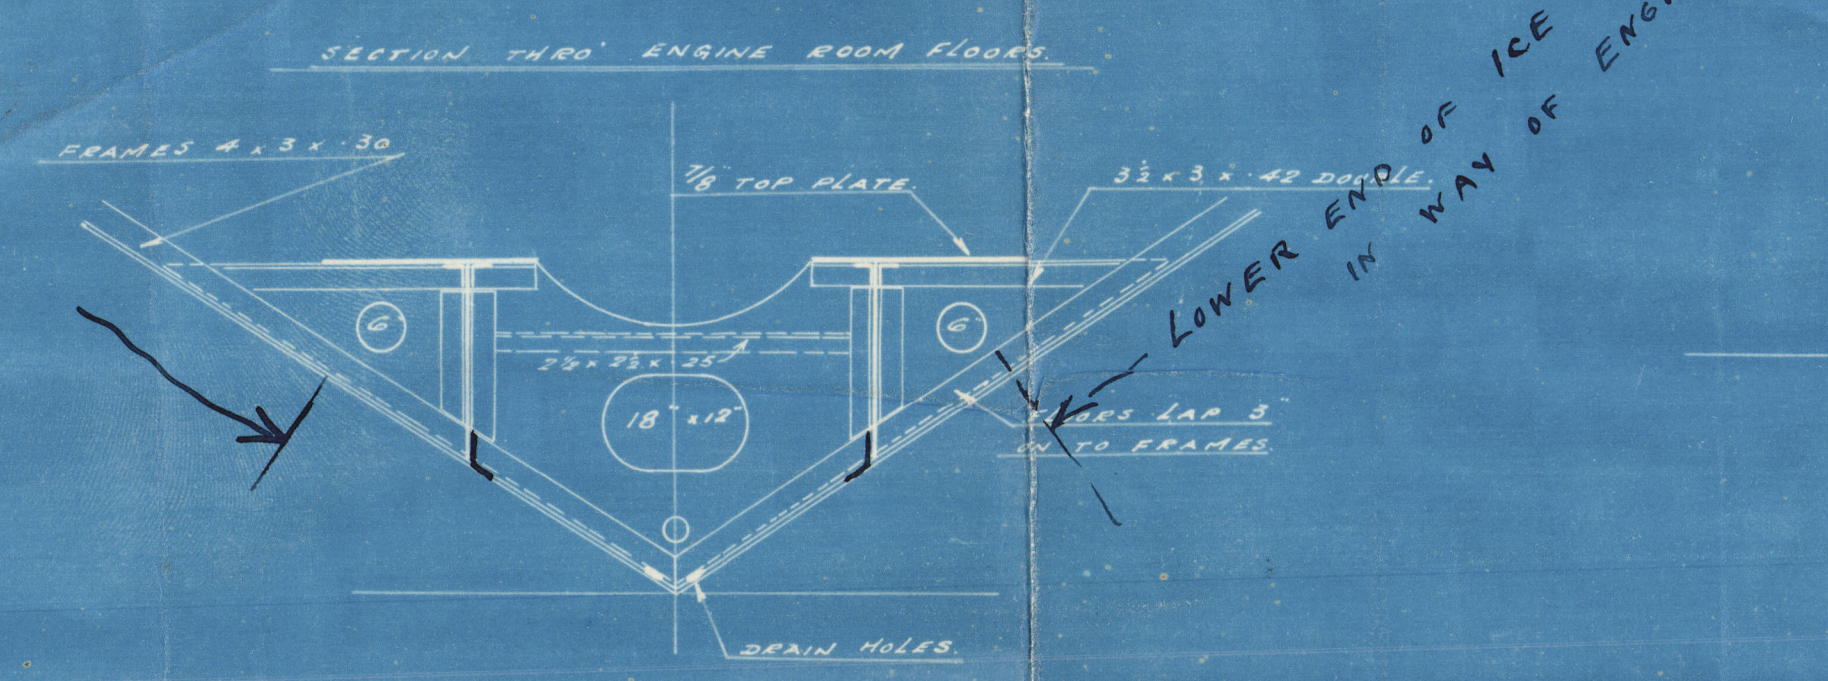

SHIPS DOCK & CO. LTD.
SHIPBUILDERS & ENGINEERS
SOUTH BAY - ON - TRES

2

Midship Section, Profile Deck [AS BUILT.]

Smiths Dock Co. Ltd

N^{os} 827-8

Reference.

827 "Southern Chief" *

828 "Southern Steam".

Shool



© 2021

Lloyd's Register
Foundation

005453-005461-0043