


# SHIP N<sup>o</sup> 251. PROFILE & DECKS

DIMENSIONS - LENGTH LWL 242'-9" ; BREADTH MLD 39'-4" ; DEPTH MLD 18'-6" TO U.Dk, 22'-6" TO R.Q.Dk  
TO LLOYDS SURVEY CLASS +100.A.I. WITH FREEBOARD CORRESPONDING TO A SUMMER  
MOULDED DRAFT OF 16'-7 1/2" (NEW LOAD LINE RULES)

ALL BULB ANGLES SHOWN ARE N.B.S.

MASTS, WINDLASS, WINCH, STEERING GEAR & DECKHOUSES  
SUPPORTED TO SURVEYORS SATISFACTION.

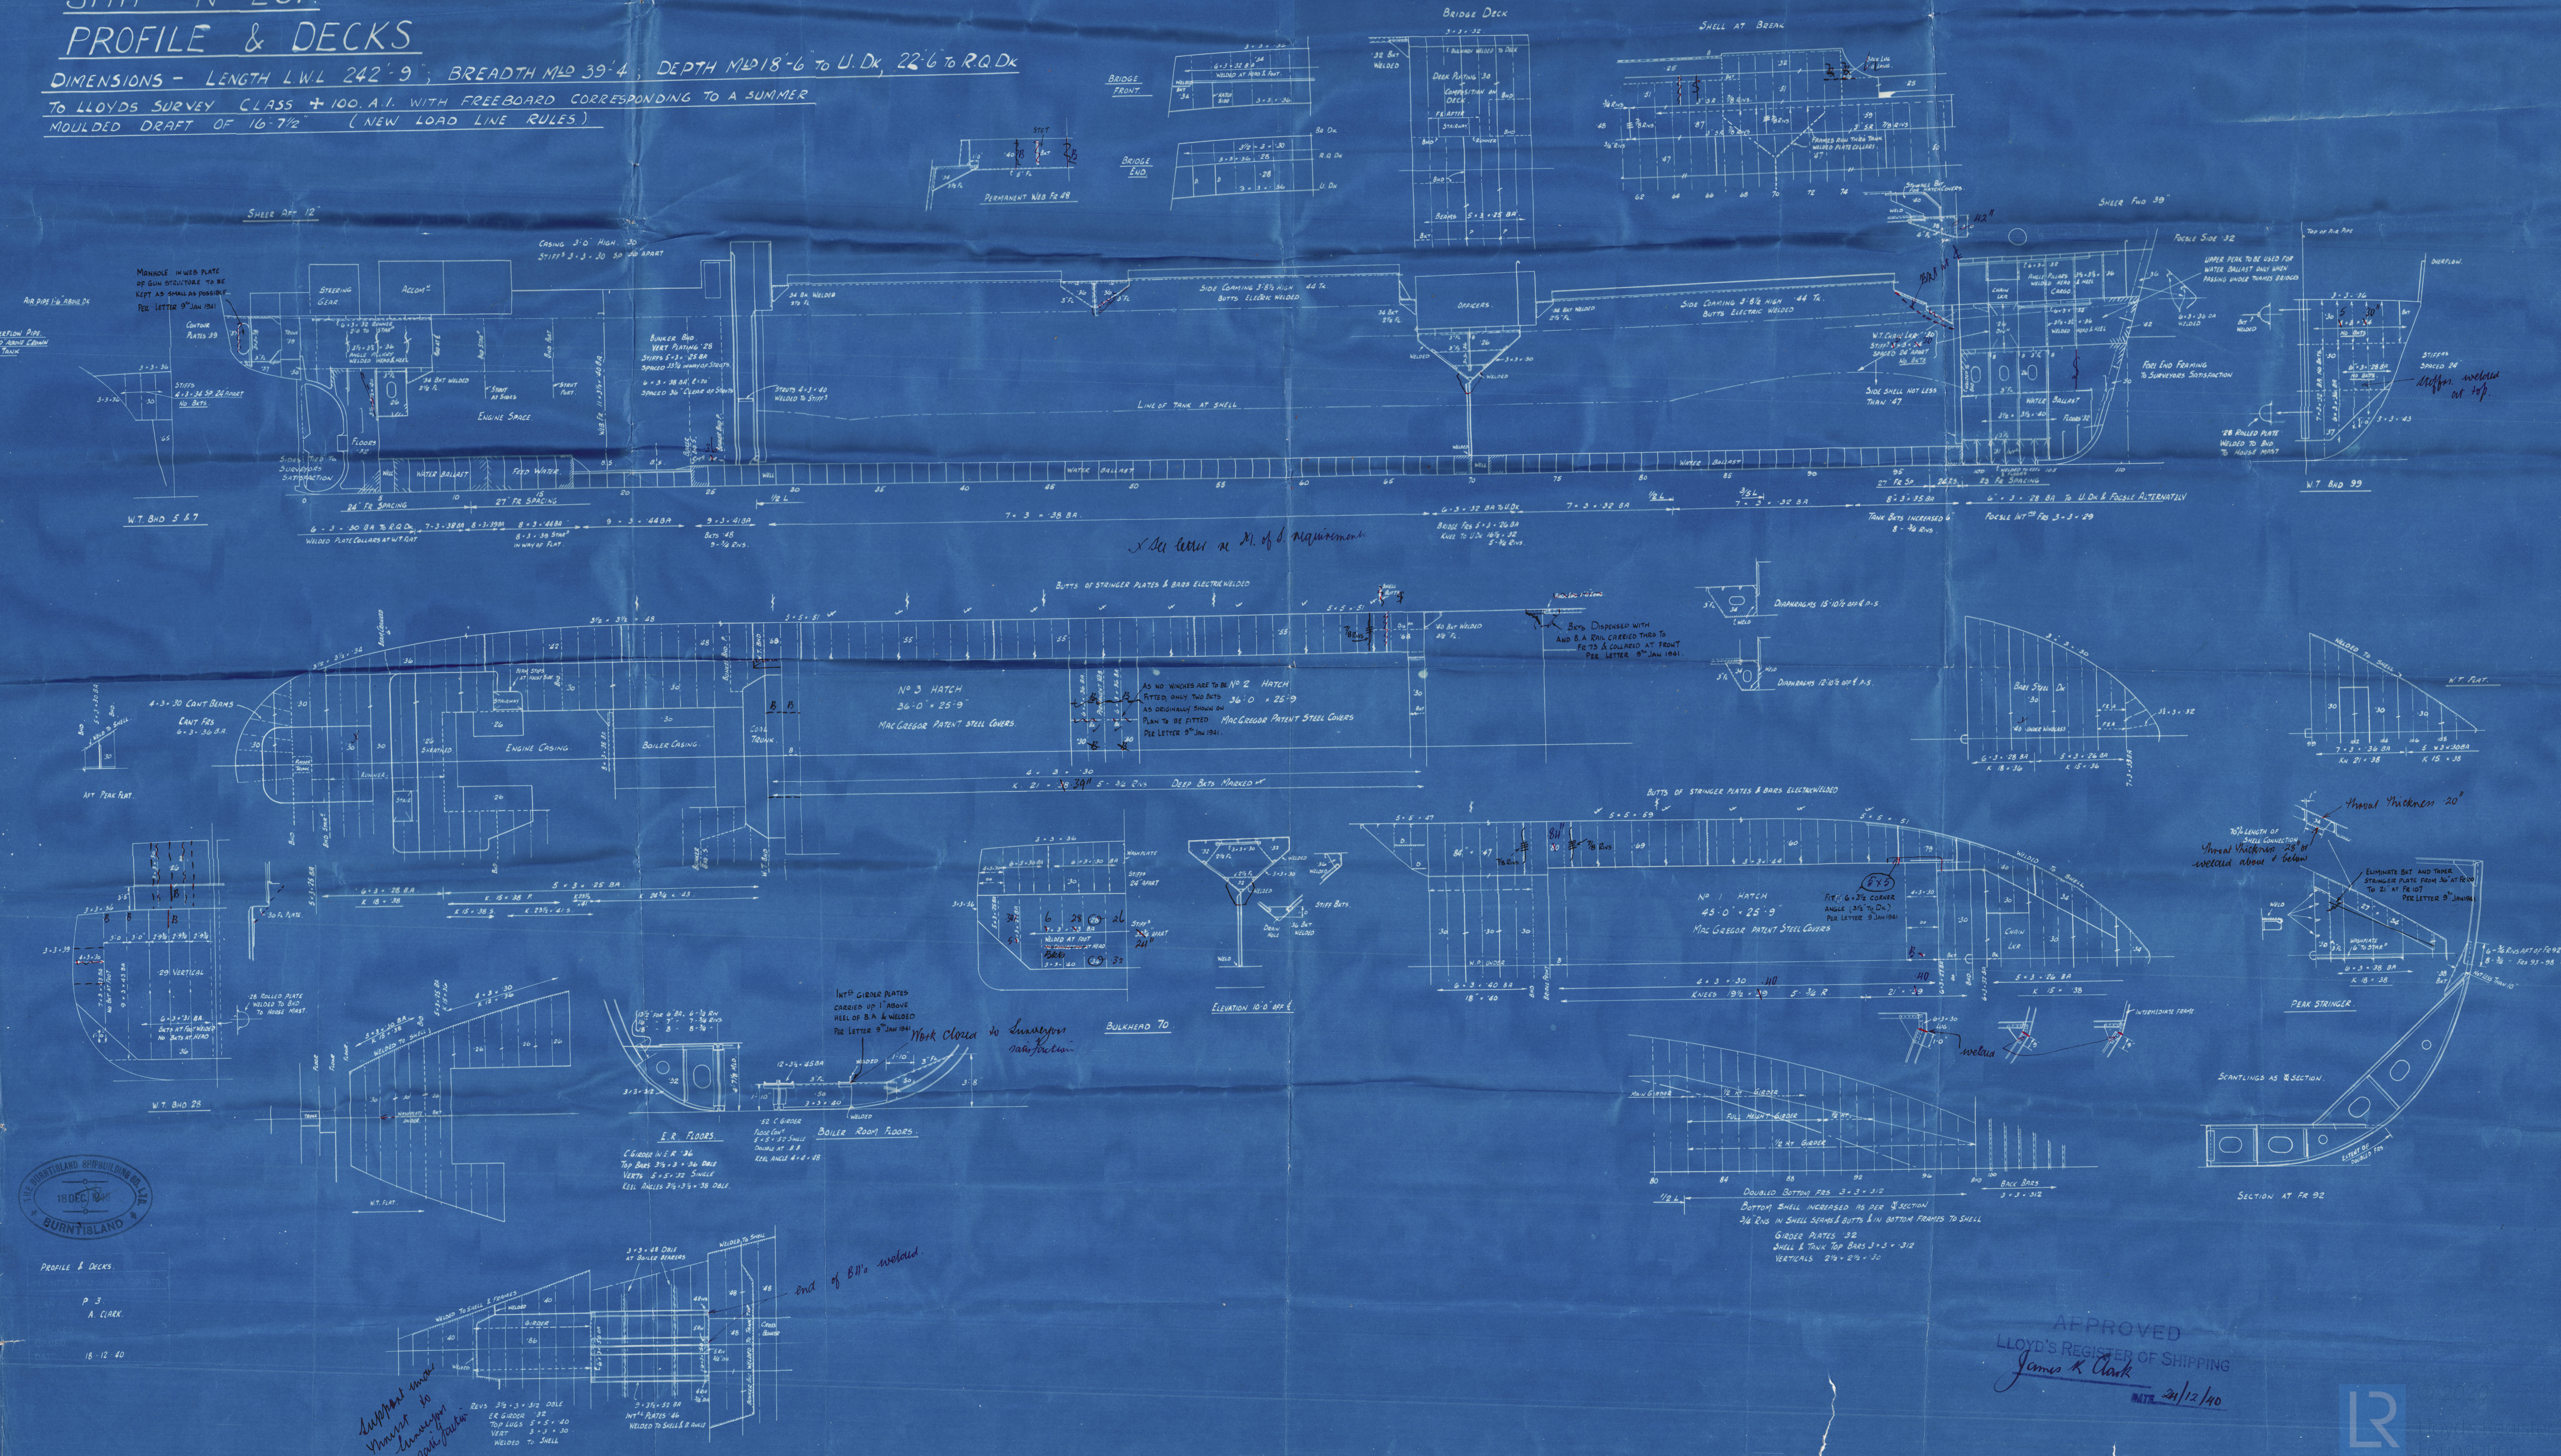



Burntisland P.B. Co. Ltd

---

Yard N<sup>o</sup> 251

---

Profile & Decks.

---

"SIR LEONARD PEARCE"

---

Lth Report N<sup>o</sup> 20514.

---



© 2020

Lloyd's Register  
Foundation

005470-005479-0189