

24.1.77

SCALE $\frac{1}{2}" = 1$ FOOT.

$$L(B+D) = 395(53.75 + 31.50) = 33673$$

PROPELLER POST $10\frac{1}{2}" \times 7\frac{3}{4}"$, RUDDER POST $9" \times 7\frac{3}{4}"$




$$A \times D = 152 \times 3.60 = 548$$

RUDDER HEAD 10 1/2" DIAM. PINTLES 5 1/4" DIAM.

VEGSEL'S SPEED NOT EXCEEDING 10 KNOTS.

Two double twisted angles.
See Sec 4. Para 7(b)

1" RIVETS SPACED ^{6"} APART 2 Rows

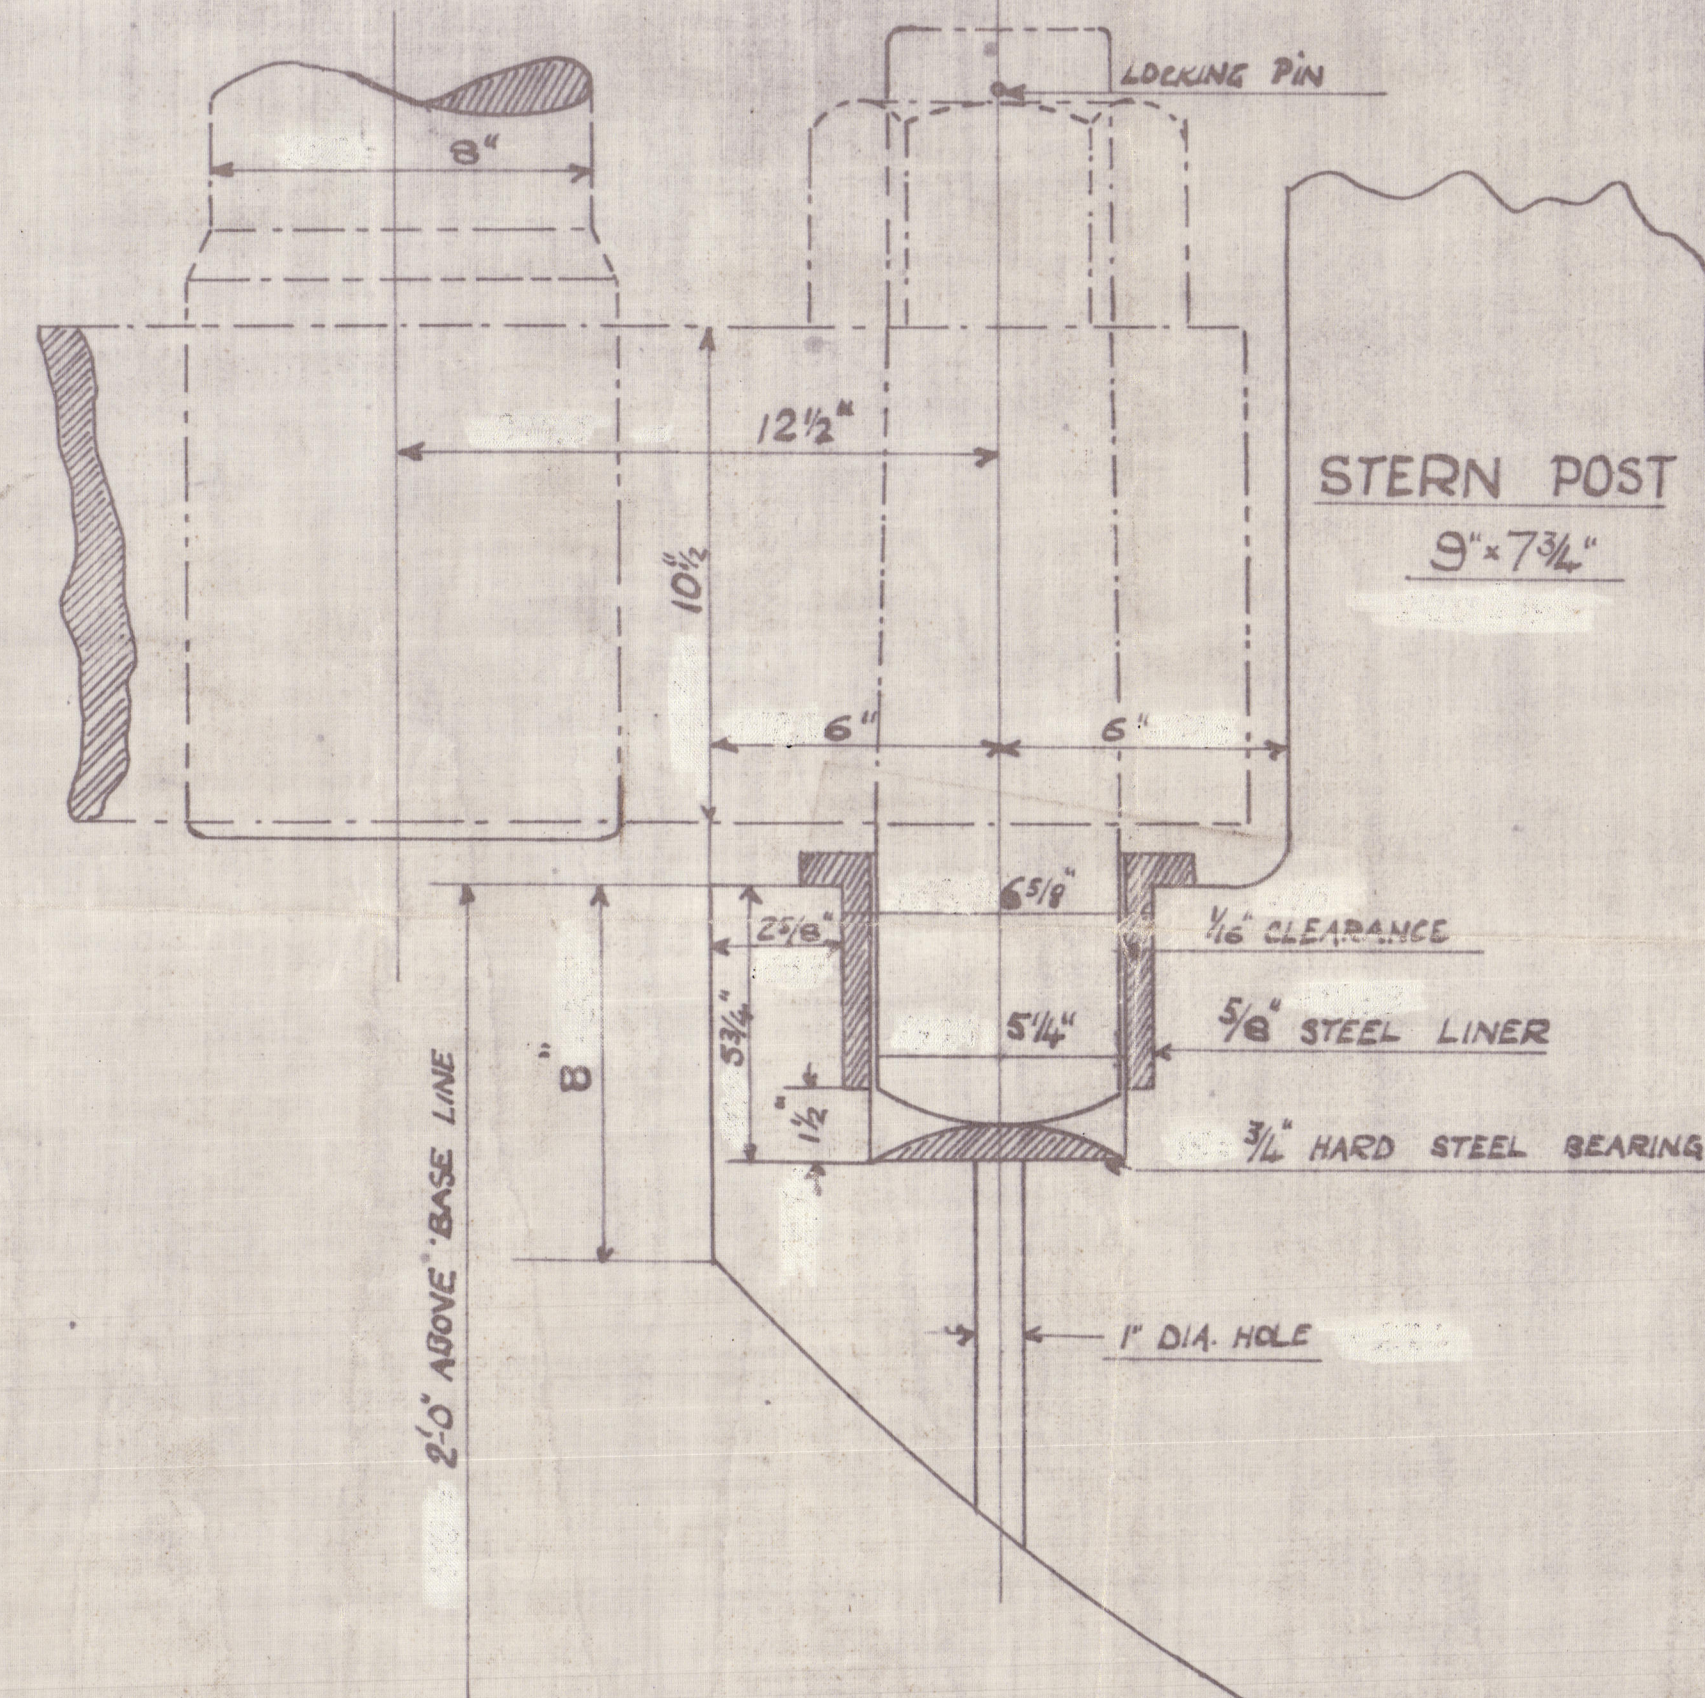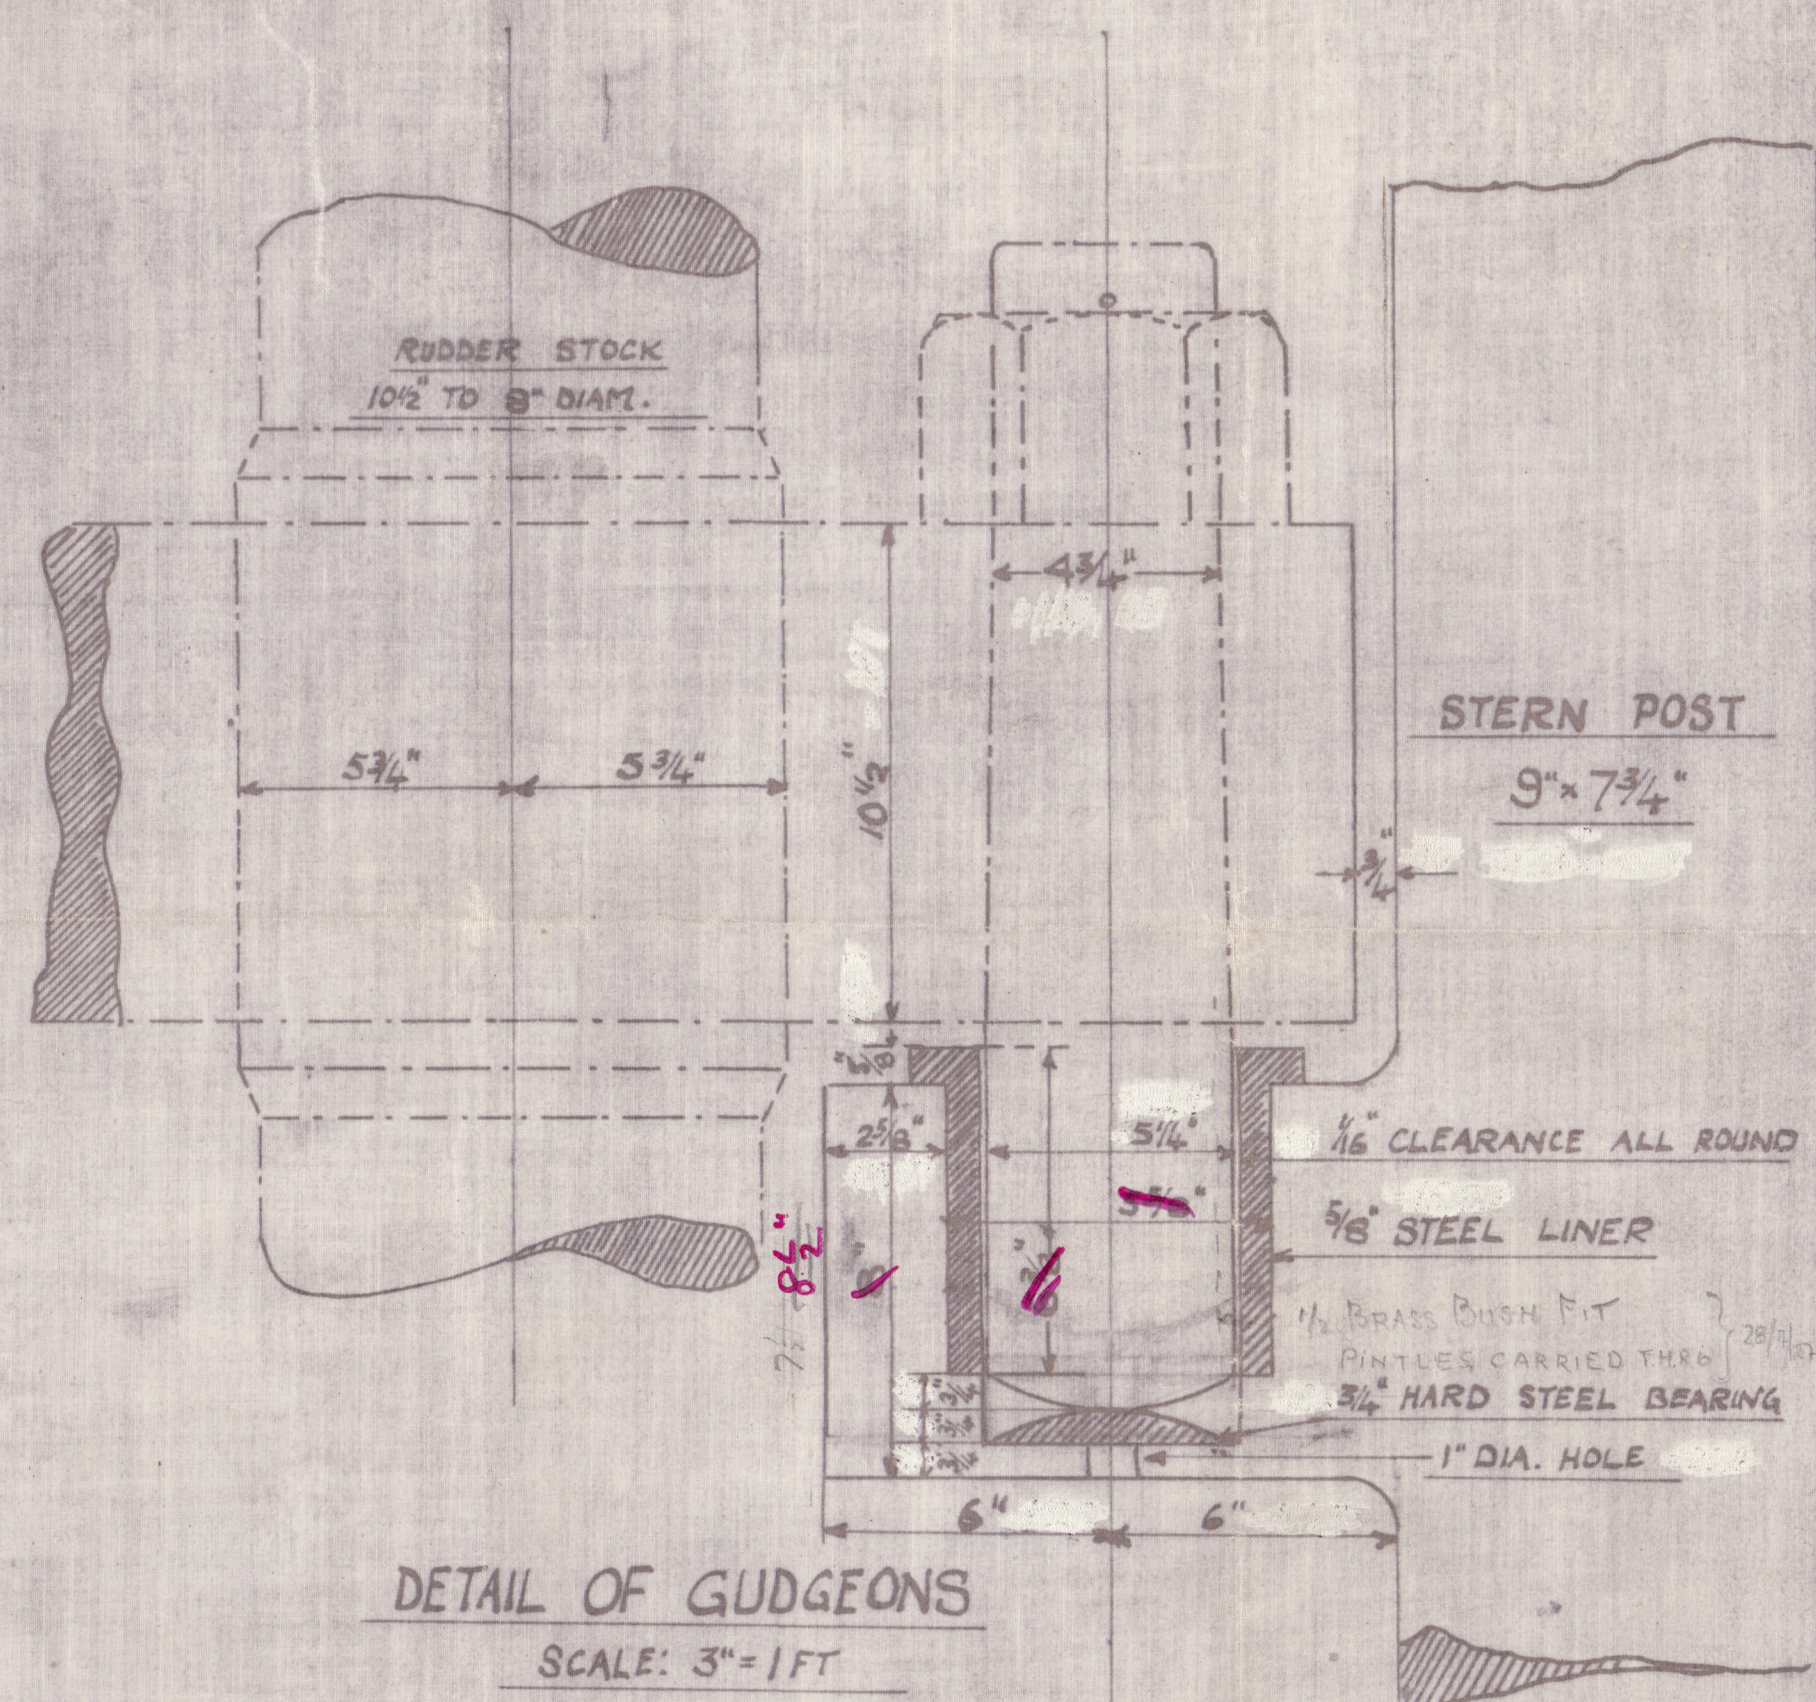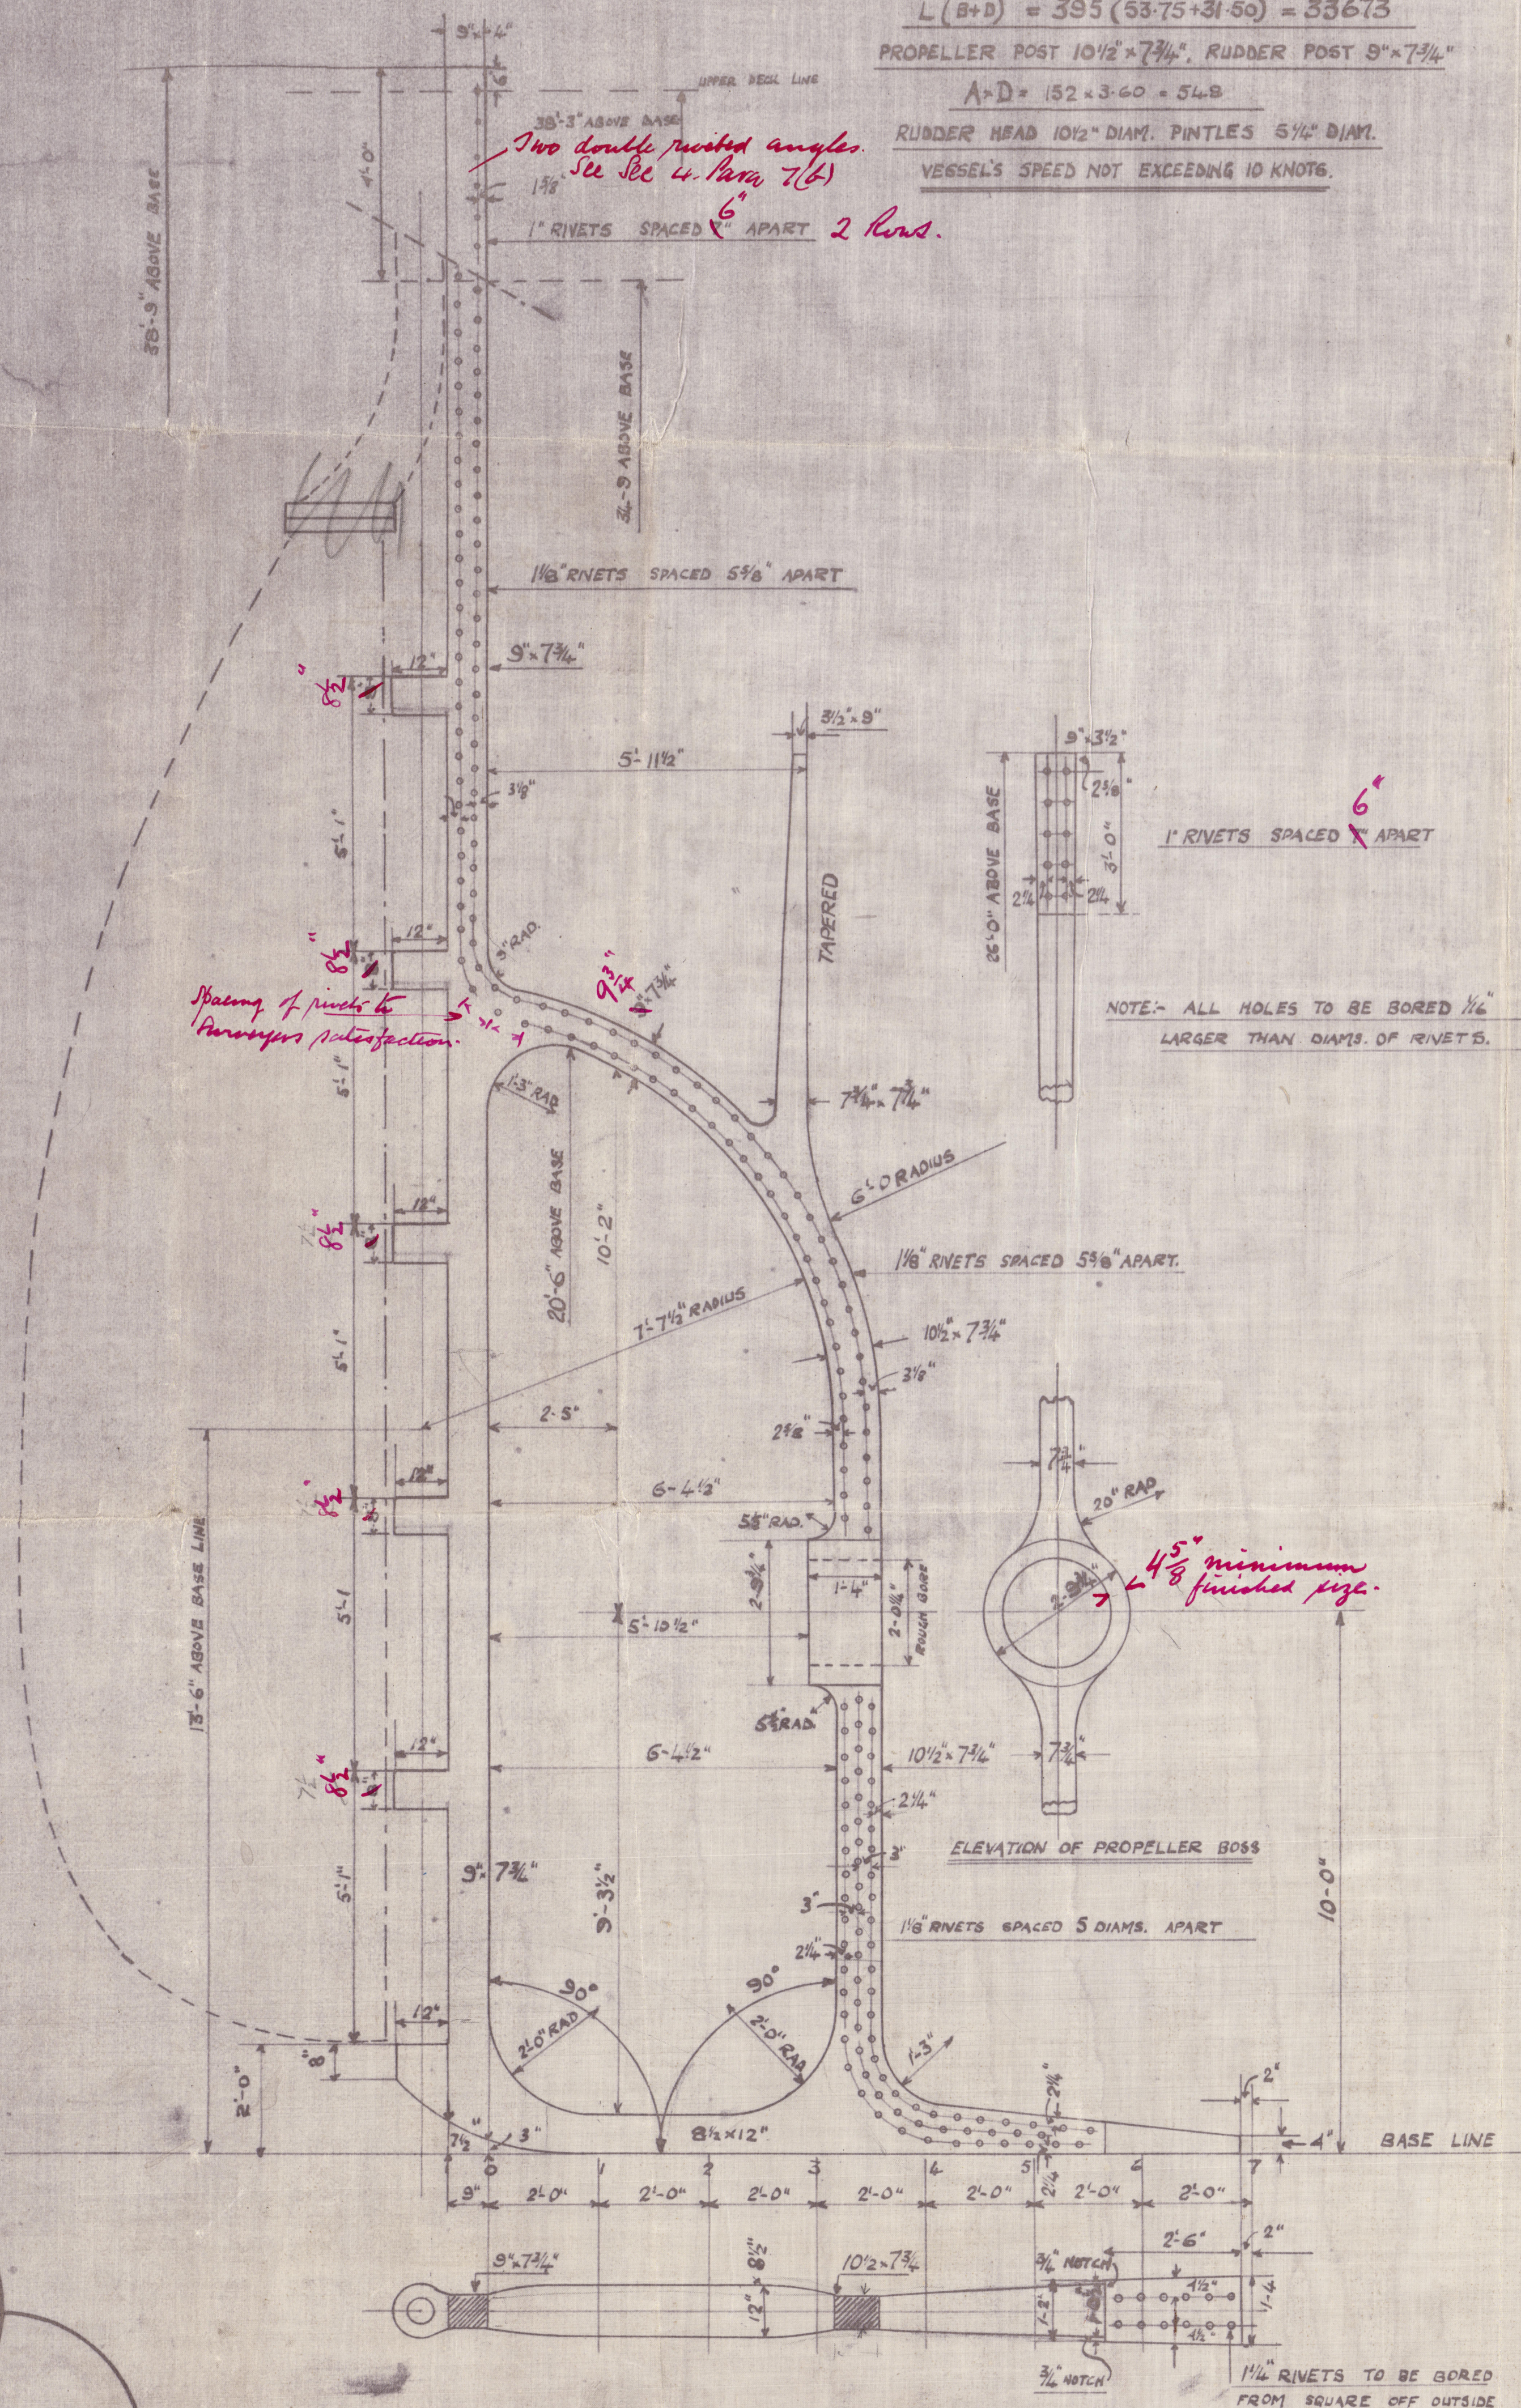

DETAIL OF BOTTOM GUDGEON
SCALE: 3" = 1 FOOT.

BARTRAM & SONS LTD
SHIPBUILDERS
SUNDERLAND

Sunderland

Messrs Bartram & Sons N^o 260

Stem Frame

"SOMAEGRA".

S. S. "BEDFORDIAN"
^{ex}

See later plan.

SUNDERLAND SHIP. NO. 29691.



© 2020

Lloyd's Register
Foundation

005480-005488-0041