

PARTICULARS RELATING TO ALL STEAM SHIPS EITHER FLUSH DECKED, OR WITH TOP GALLANT FORECASTLES, SHORT POOPS AND BRIDGE HOUSES DISCONNECTED, OR WITH TOP GALLANT FORECASTLES HAVING LONG POOPS, OR RAISED QUARTER DECKS CONNECTED WITH BRIDGE HOUSES, OR OTHERWISE.

Date of Survey While building

Name of Surveyor Gas. Kennie

Ship's Name.	Port of Registry and Nationality.	Official Number.	Gross Tonnage.	Date of Build.	Particulars of Classification.
<b>BADJESTAN</b> Number in Register Book <u>39984</u>	Newcastle British	149451 ✓	✓	1927.	+100A1 contemplated

Registered Dimensions from p's Register.	LENGTH.	BREADTH.	DEPTH.	UNDER DECK TONNAGE.
	395.5	54.0	29.10	5138.35
th on LOADLINE.	395.0-	Frame Depth 15" Rule „ 67 8 R-2 = -1.335 spar ceiling fixed. ✓	<sup>No</sup> Ceiling } + 20. Sheer + 1.34 } Level Tank.	Peak } Included Tanks } + 3.73 tons for raised tank aft
RD	395.0-	52.6750	30.64-	5142.08-

Moulded Depth as measured.....3'-6"

Addition for Keel below base line  
for draught record..... $1\frac{3}{4}$ ...inches.

NOTE. — If the depth is measured when vessel is afloat, the details of measurement should be reported.

### CORRECTION FOR LENGTH

Length of Ship on Loadline.....	395.0 -	
Length in Table .....	378.0 -	
Difference .....	17.0 -	
Correction for 10ft., Table A. ....	1.6 -	Table C. .8 -
× Difference divided by 10 .....	2.72 -	(if required,) 1.36 -
If $\frac{6}{10}$ ths length covered divide by 2	+ 2 $\frac{3}{4}$	+ 1 $\frac{1}{4}$

CORRECTION FOR IRON DECK.

Proportion covered, if less than $\frac{7}{10}$ ths length covered .....	44 <sup>1</sup> / <sub>2</sub>
Thickness of usual wood deck, less stringer .....	3 <sup>1</sup> / <sub>2</sub>
	- 1 <sup>1</sup> / <sub>2</sub>

## CORRECTION FOR ROUND OF BEAM.

Breadth at Gunwale amidships.....  $53' - 2\frac{3}{4}"$  round of beam should be reported on the full breadth of vessel at the gunwale,  
Round of Beam ..... 15  
Normal round.....  $13' 3\frac{1}{2}"$   
Difference .....  $1' 69" \div 2 = \dots 84"$   
Proportion of Deck uncovered (Para. 19) .....  $53' 85" \div 2 = \dots 464" - \frac{1}{2} \checkmark$

NOTE. — The round of beam should be reported on the full breadth of vessel at the gunwale.

Freeboard, Table A .....	$8-3\frac{1}{2}$
Correction for Sheer .....	$-11\frac{3}{4}$
	$7-3\frac{3}{4}$
Correction for Length .....	$+2\frac{3}{4}$
	$7-6\frac{1}{2}$
Allowance for Deck Erections .....	$-8$
	$6-10\frac{1}{2}$
Correction for Round of Beam.....	$-\frac{1}{2}$
	$6-10$
Correction for fall in Sheer (if any).....	✓
Correction for Steel Deck (if required) .....	$-\frac{1}{2}$
	$6-8\frac{1}{2}$
Additions for non-compliance with provisions of } Para. 11 (d) and (e) ‡ }	✓
Other Corrections (if any) .....	✓
$(\frac{85.25}{27.0})^2 \times \frac{15}{1}$	
Winter Freeboard .....	$6-8\frac{1}{2}$
Summer Freeboard .....	$6-2\frac{3}{4}$
Indian Summer Freeboard .....	$5-9$
N. A. Winter Freeboard .....	

Correction necessary because clearside amidships, measured  
in accordance with the Statute is not taken at the  
intersection of the ~~water~~ steel deck with side.

$$\left(\frac{25.26}{27.0}\right)^2 \times \frac{15}{1} = 18.1 = 1.90$$

Winter Freeboard from deck line .....	6-10½ -
Summer " " " " .....	6-4¾
Indian Summer " " " " .....	5-11 -
N. A. Winter " " " " .....	✓

D recommended amidships from centre of Disc to top of Statutory Deck Line, ~~Wood~~ (Steel) Deck :— ... .. 6'-4½" ✓

Fresh Water Line		top of Saddle; Deck Line,	(Steel) Deck :	... ..	6' - 7 1/2"
Indian Summer Line		above centre of Disc	...	...	7 "
"	"	"	...	...	5 1/2 "
Winter Line		below	"	...	6 "
Winter North Atlantic Line		"	"	...	6 "

† State dimensions of freeing port area on back of this form.

The Surveyor should state whether the fall in sheer as reported is measured relatively to the straight line of keel or to the water line. If measured relatively to water line the vessel's draft at time of survey, and also the usual load draft forward and aft should be reported.

of ceiling should be reported if possible.

§ In vessels obtaining an allowance for deck erections under Para. 11 where the sheer drops abaft amidships the height of the R.Q.D. is to be taken from the level of the top of the main ship beam.

post. In vessels having poops and forecastles, it means the sheer measured at the stern and stern-one-eighth of the vessel's length from stem and stern-post.

1,2<sup>d</sup>. T.

005480-005488-0094

$$FW = \frac{12320}{43.8 \times 40} = \underline{70.3}$$

RECEIVED 9 DEC 1927

© 2020

Lloyd's Register  
Foundation




Do all the Frames extend to the top height in the Poop? *Yes.* Raised Quarter Deck? *Yes.* Bridge House? *Yes.* Forecastle? *Yes.*  
 To what height do the Reverse Frames extend? *Channel framing.*  
 Has the Poop ~~Raised Quarter Deck~~ an efficient Iron Bulkhead at the fore end? *Yes.*  
 Give particulars of the means for closing the openings in Bulkhead *No openings.*  
 Is the Poop ~~Raised Quarter Deck~~ connected with the Bridge House? *No.* Has the Bridge House an efficient Bulkhead at the fore end? *Yes.*  
 Give particulars of the means for closing the openings in Bulkhead *No openings.*  
 What is the thickness of the Bridge Front plating? *40"* and Coaming plate? *44" x 3'-0" high*  
 Give scantlings and spacing of the Stiffeners *9 x 3" x .50" bulk angles spaced 30" apart.* Are hor'l. brackets fitted connecting Bridge Bulk'd. with Bulwarks? *Yes.*  
 Are bracket plates fitted at each end of the Stiffeners? *Yes.*  
 Has the Bridge House an efficient Iron Bulkhead at the after end? *Yes.*  
 How are the openings closed? *With shifting boards full height in rivetted channels.* Has the Forecastle an efficient Iron ~~Web~~ Bulk'd. at after end? *Yes.*  
 Is the Forecastle at least as high as the main or top-gallant rail? *Upper Deck*  
 Are the Engine and Boiler openings covered by a Bridge, ~~Poop, Raised Quarter Deck, or enclosed by a Strong Iron or Steel Deckhouse?~~ *Yes.*  
 If the openings are not so protected are the exposed parts of the Casings efficiently constructed? *Yes.*  
 Give thickness of plating; scantlings and spacing of Stiffeners. *7'-9" to 7'-6"* Are suitable means provided for closing all openings in them in bad weather? *Yes.*  
 What is the height of the exposed Casings? *7'-9" to 7'-6"*

Are the Weather Deck Hatchways efficiently constructed and at least equal to the requirements of Section 28 of the Rules for 1904-5? Give particulars below:—

Position and Size.	N°1. 31'-6" x 20'-0"		N°2. 32'-6" x 20'-0"		N°3. (on Bridge Deck) 22'-6" x 20'-0"		N°4. 32'-6" x 20'-0"		N°5. 30'-0" x 20'-0"	
Item.	Ship.	Rule.	Ship.	Rule.	Ship.	Rule.	Ship.	Rule.	Ship.	Rule.
COAMING. Height above top of DECK	46 1/2"	46" approved	49 1/2"	49" approved	30"	approved.	39 1/2"	39" approved	39 1/2"	39" approved
Thickness { Sides..... Ends.....	.44 .44	.44	.44 .44	.44	.44 .44	.44	.44 .44	.44	.44 .44	.44
SHIFTING BEAMS OR WEB PLATES. Number.....	6	Approved	6	Approved	2 x Trunk 17" x 3/16 plate	Approved.	6	Approved	5	Approved.
Section and Scantlings.....	17" x 3/16 plate 4 x 3" x 1/4 angles	Approved	17" x 3/16 plate 4 x 3" x 1/4 angles	Approved	17" x 3/16 plate 4 x 3" x 1/4 angles	Approved.	17" x 3/16 plate 4 x 3" x 1/4 angles	Approved	17" x 3/16 plate 4 x 3" x 1/4 angles	Approved.
Material.....	Steel		Steel		Steel		Steel		Steel	
* FORE AND AFTERS. Number.....										
Section and Scantlings.....	✓		✓		✓		✓		✓	
Material.....										
HATCHES Thickness.....	3"	2 1/2" approved	3"	2 1/2" approved	3"	2 1/2" approved	3"	2 1/2" approved	3"	2 1/2" approved
Remarks.....	Good.		Good		Good.		Good		Good.	

\* The depth of Fore and Afters should be stated from the underside of the hatches in all cases.  
 (If the sill of the lowest side scuttle will be less than 6 inches above the Indian Summer Load Line if assigned under the tables, state vertical distance from top of deck at side amidships to lower edge of lowest side scuttle.)  
 The following information is to be given in all Cases of vessels dealt with under Paras. 11, 12 (under 15 feet Moulded depth) and under Shelter Deck Rules.  
 What is the thickness of the Bridge Sheerstrake? *✓* Strake between Main and Bridge Sheerstrakes? *✓*

Delete the words { The Crew are, are not, berthed in the bridge house.  
 that do not apply { The arrangements to enable them to get backwards and forwards from their quarters are, are not satisfactory.  
 Length of Bulwarks in well Forward 102.5' x 3.5' Aft 117.5' x 3.5'  
 Area of Freeing Ports required by Para. 11 (e) each side of vessel = { Ford. 20.50 } Sq. ft. = 44.00  
 { Aft. 23.50 }  
 Ft. Tenths. Ft. Tenths. No. } Freeing Ports = { Ford. 27.60 } Sq. ft. = 55.20  
 (each side of vessel) { Aft. 27.60 }  
 { Forward 4.0 x 1.5 x 5 }  
 { Aft. 4.0 x 1.5 x 5 }  
 Total deficiency or excess = 11.20 Sq. ft. ✓

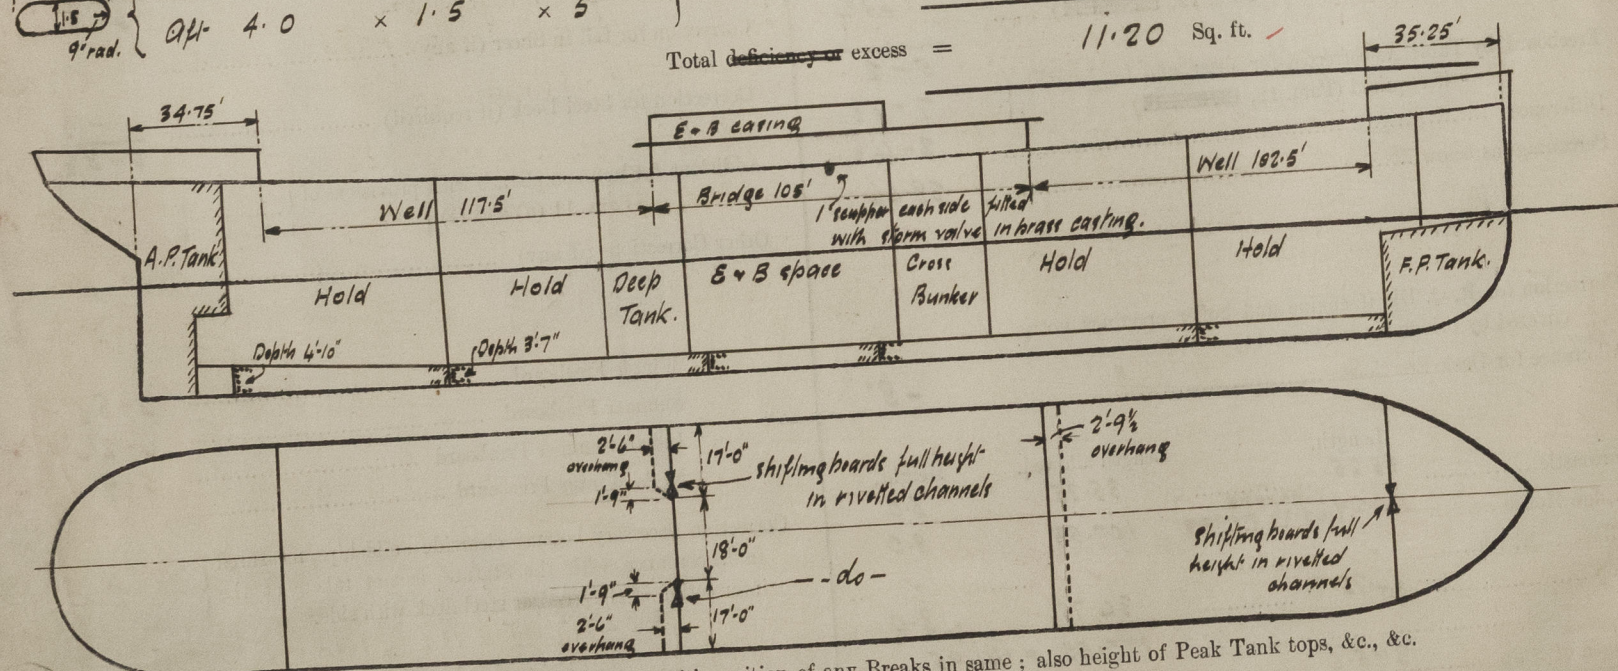

Show hereon line of Floors or Tank Top with position of any Breaks in same; also height of Peak Tank tops, &c., &c.  
 State any special features in the construction of the Vessel *There are no special features.*  
 Builder's name and yard number *Barham & Sons Ltd. No 260*  
 Names of sister vessels *✓*  
 Owners *The Hindustan Steam Shipping Co. Ltd. (Common Bros. Managers)*  
 Address *Exchange Buildings, Quay-side, Newcastle on Tyne.*  
 Fee £ 10 : 1 : 8 Received by me *The Builder state that the load displacement is 12320 tons, & the tons per inch 43.8*  
*will be charged on completion* *See F.B. Report.*