


STRUCTURAL ELEVATION - R.Q.D CARGO STEAMER - 150' x 25' x 12' mld. - LLOYDS CLASS 100 A1.

Scale: - 1/4 inch = 1 foot.

(16'-0" to R.Q.D.)

No 179-180

30.10.19

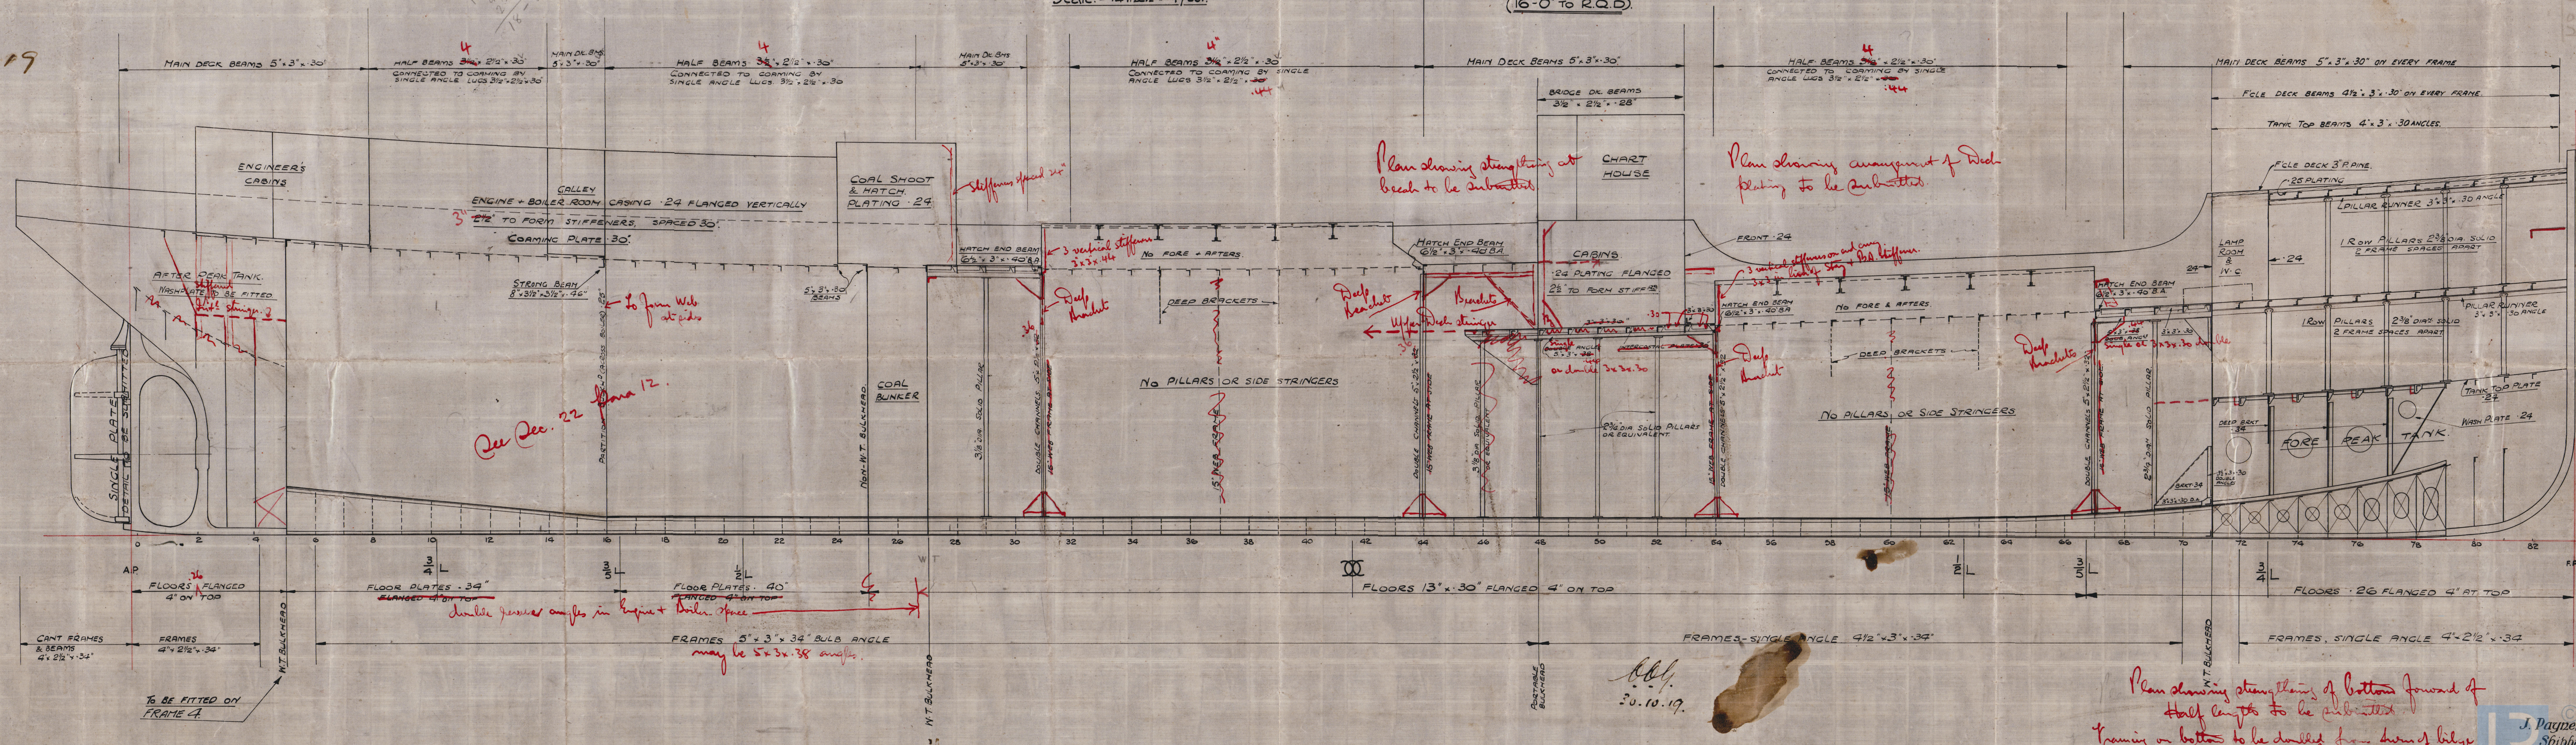

Plan showing strengthening at beam to be submitted

Plan showing arrangement of Deck plating to be submitted

Plan showing strengthening of bottom forward of half length to be submitted

J. Payne, Ltd., Shipbuilders, BRISTOL.

Dec. 17/19

005480-005488-0162

~~J. Payne Ltd~~

9/ 179 & 180

Profile Bristol
25.10.49

James Towers (Shipbuilding) Co Ltd

nos 179 & 180

SS Dorset Coast

First Entry Report

no 11440

Lloyd's Register
Foundation

005480-005488-0162