


7.4.20.

SHIPS Nos 179-180.

CLASS 100.A.1. LLOYDS.

DECK PLATING.

Scale: 1/4 inch to a foot.

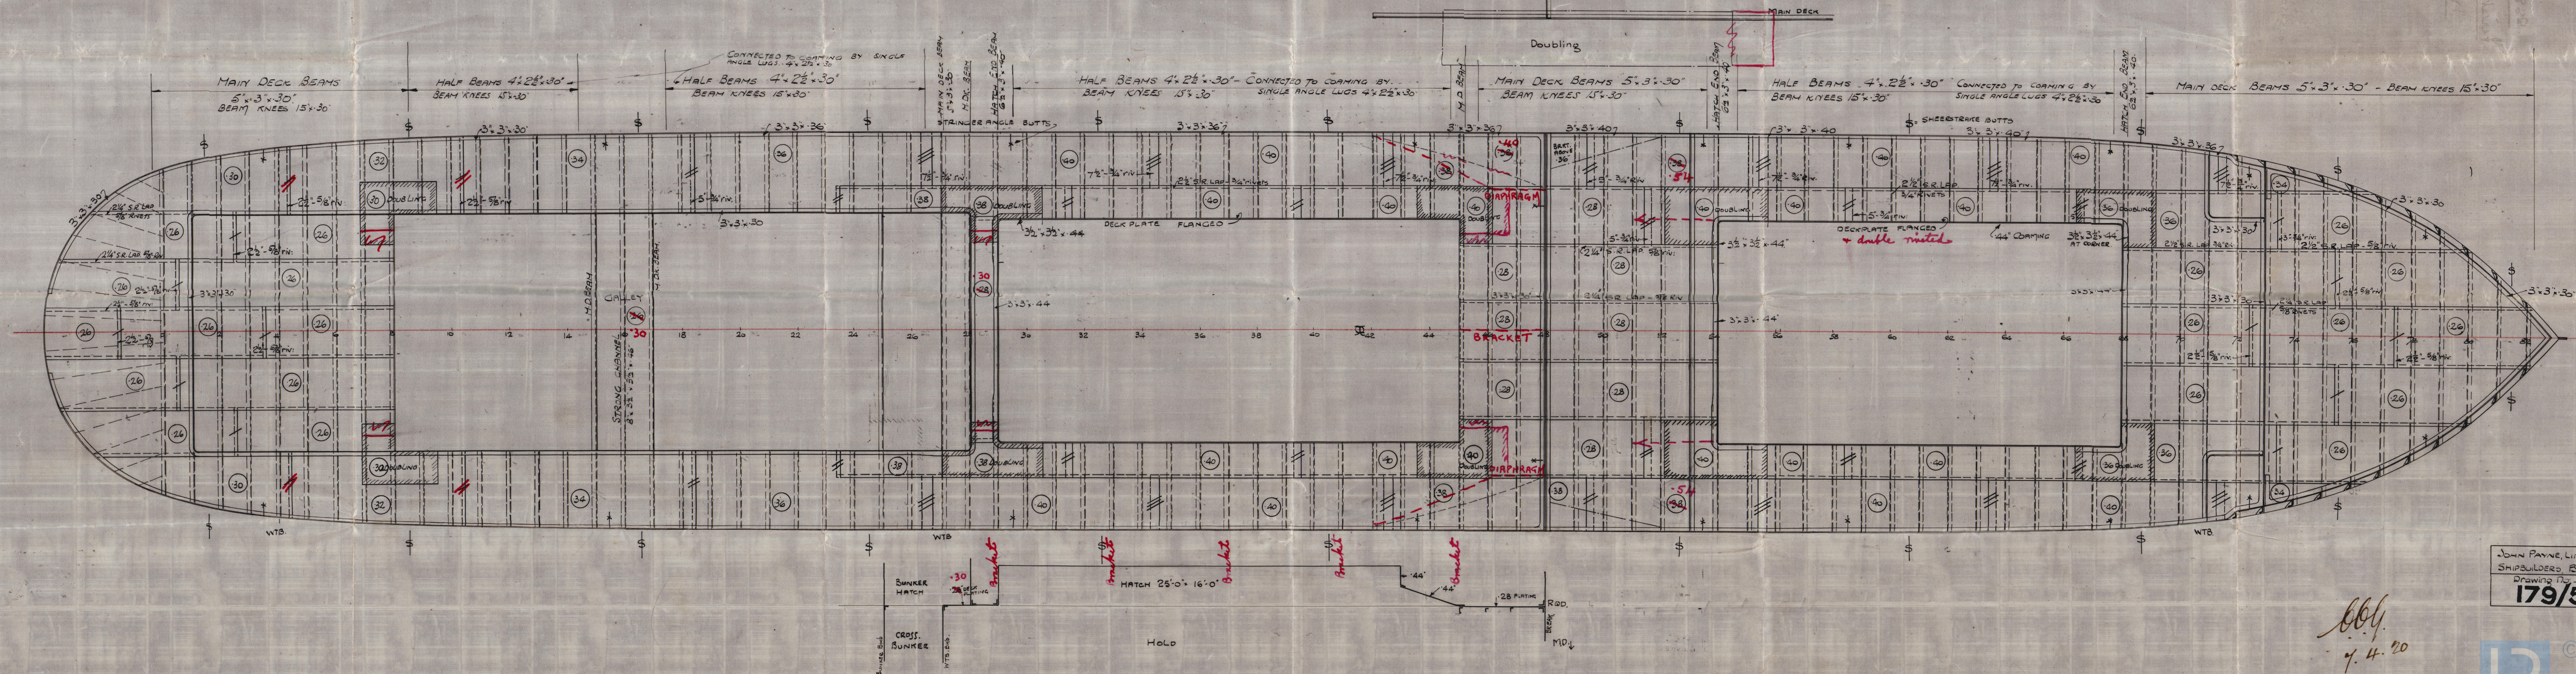

SKETCH OF AFTER HATCHWAY ON E.

JOHN PAYNE, LIMITED
SHIPBUILDERS, BRISTOL
Drawing No.
179/5.

Daynes Towers (S13) Co Pa.

~~J. Payne Ltd~~

No 179x180

Deck Plan

SS Dorset Coast

First Entry Report

no 11440

Bristol

G.A.D.

1/4/20

LR

005450-005488-0163

Lloyd's Register
Foundation