


30.6.09

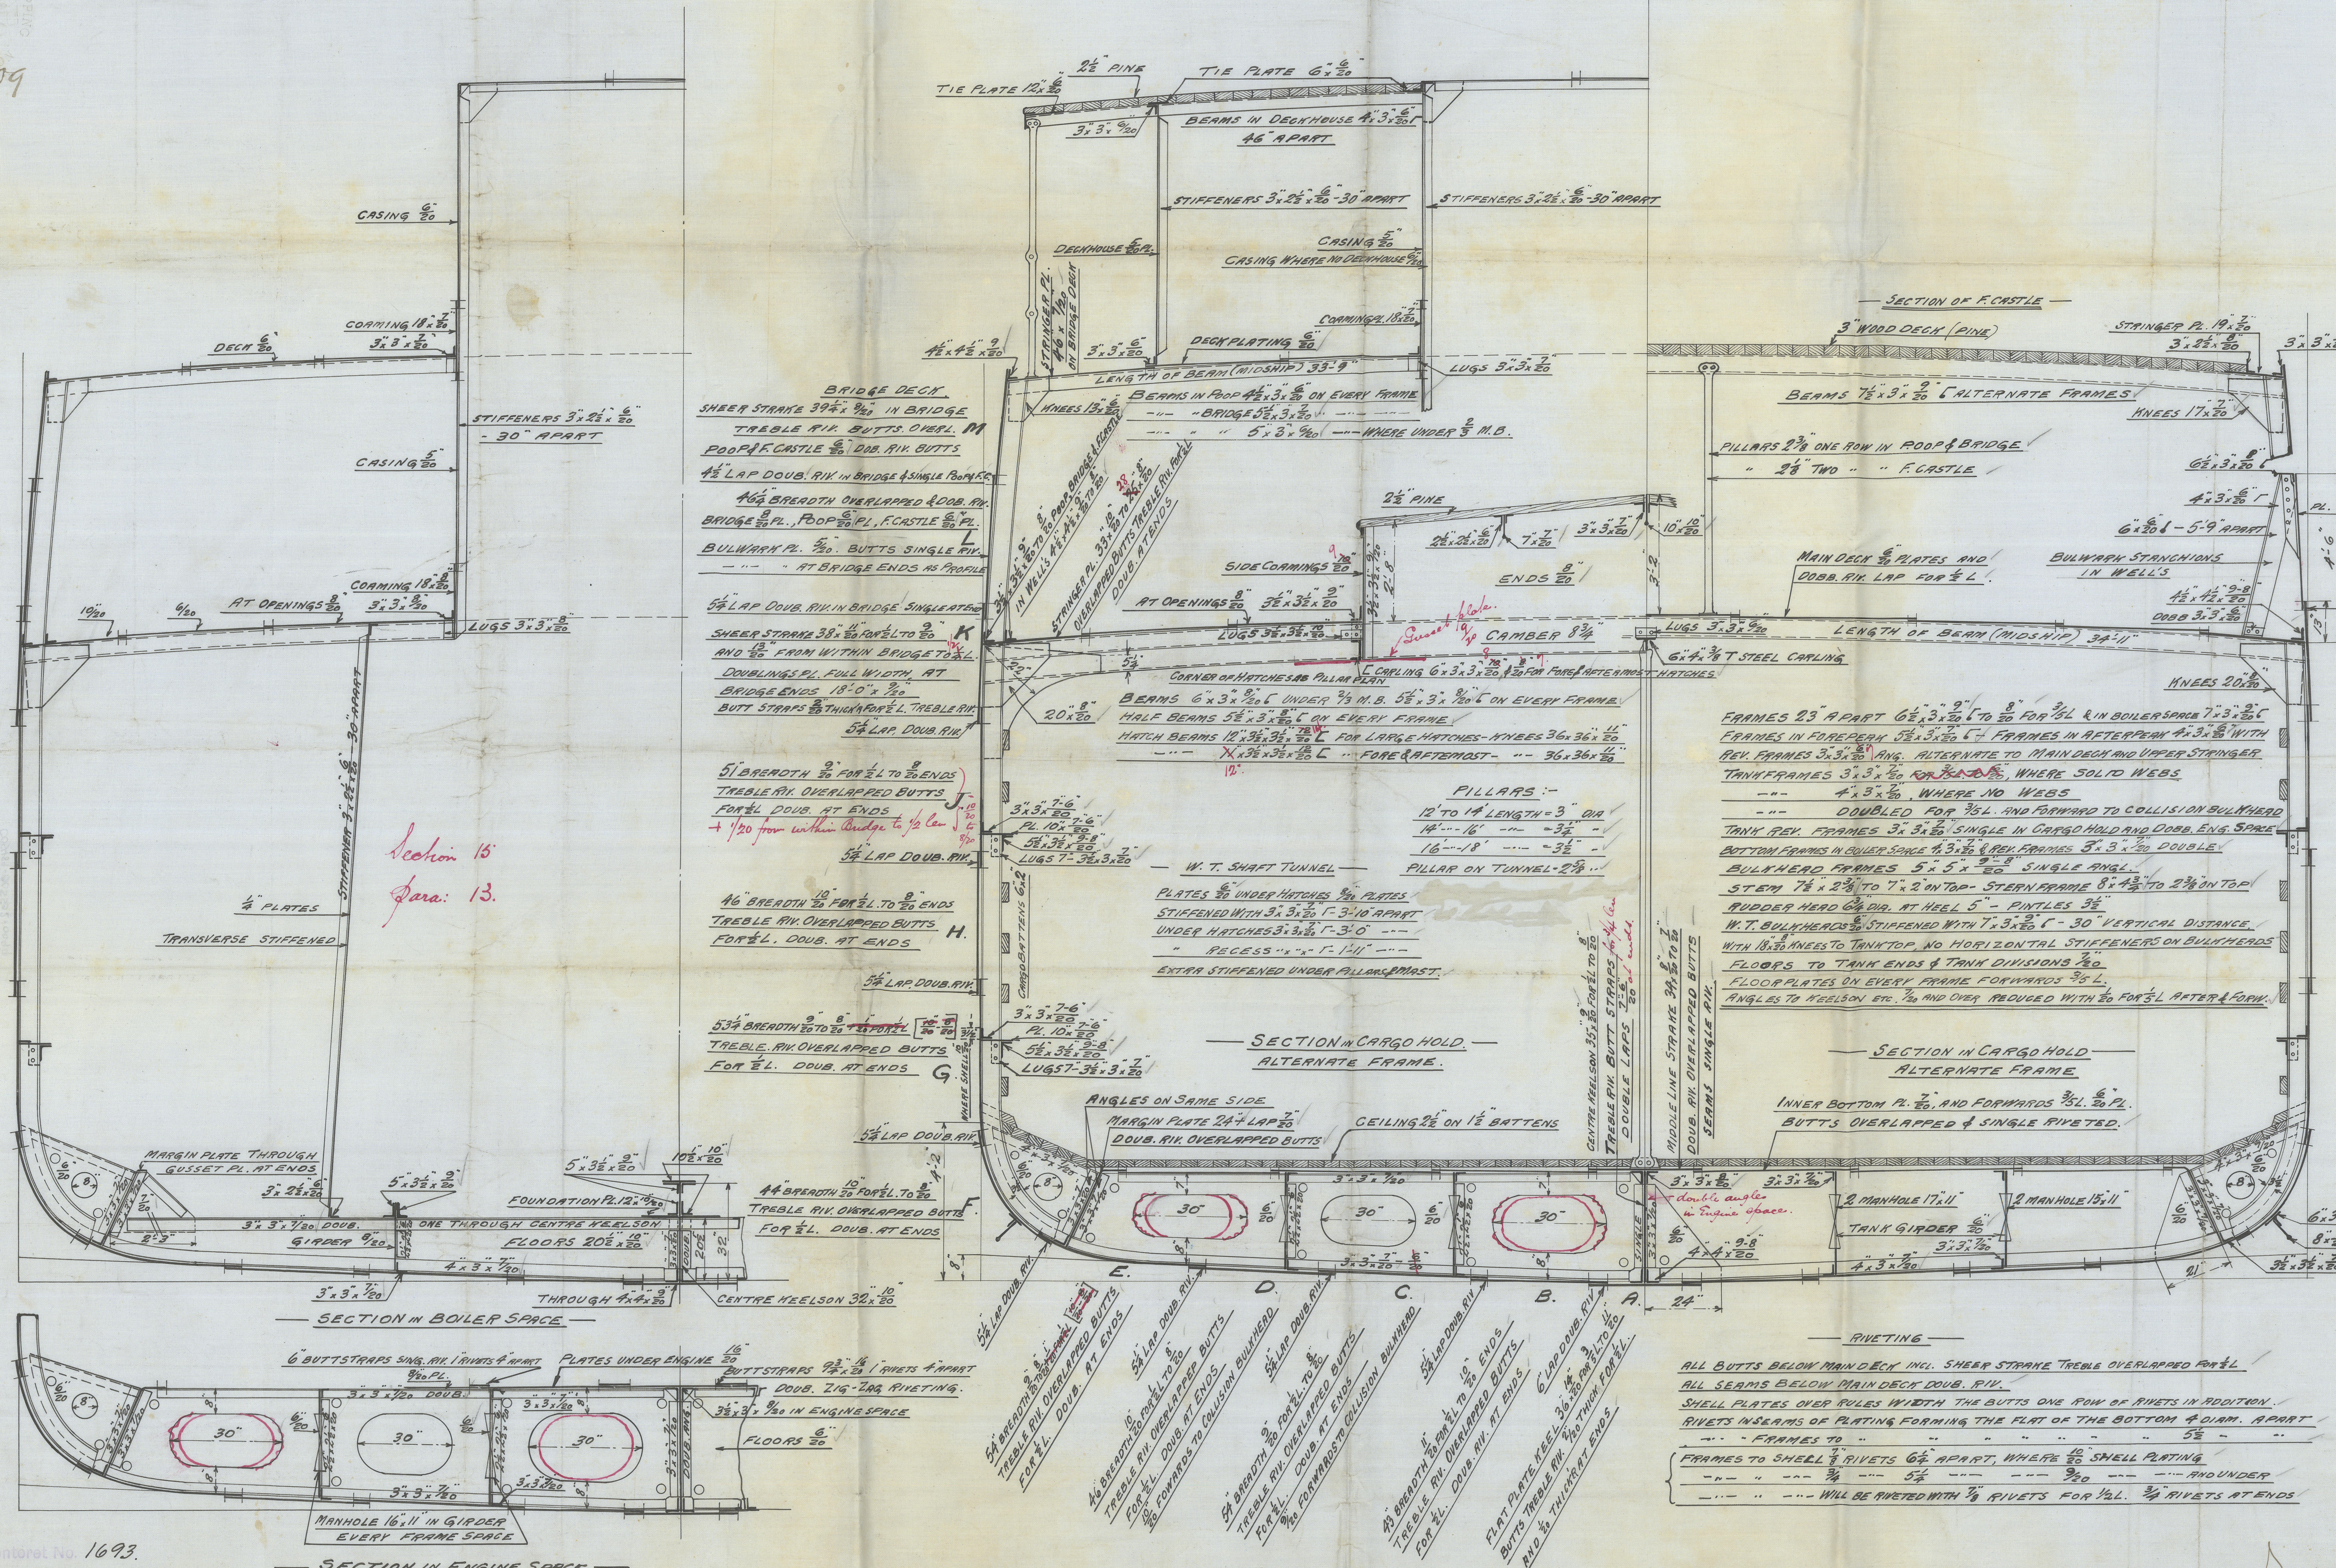

LLOYD'S DIMENSIONS:-
LENGTH INSIDE R.P. 227'9"
BREADTH MOULDED 35'0"
DEPTH TO MAIN DECK 17'6"

1/2 BREADTH 17'6"
DEPTH 17'6"
1/2 GIRTH 32'1 1/2"
67'2 1/2"

1ST NUMBER 67,2135
2ND NUMBER 15307,81

1/2 = 12.96 1/2 = 6.50

LENGTH OF ERECTIONS ON DECK
FROM INSIDE R.P.

LENGTH OF POOP 9'7"
" BRIDGE 37'6" 41'4"
" F. CASTLE 24'7"
" TOTAL = 91'8"

EQUIPMENT NUMBER 16565

1 STOCKLESS ANCHOR 26 CWT'S
1 " " " 25 "
1 " " " 22 "
1 STEAM " " 6 1/2 " ex stock
1 KEOG " " 3 1/2 "
210 FATHOMS 1 1/2" STUD LINKED CHAIN
75 " 3 1/2" STEEL WIRE FOR STEAM
90 " 3 1/2" " " OF 10" HAMP (TOWLINE)
90 " 2 1/2" " " 6" (HANSER)
90 " 2 " " 5" (WRAPS)

CLASS 100 A LLOYD'S RULES

ALL MATERIAL STEEL

DIMENSIONS:-

LENGTH B.A. OUTSIDE STEM 229'0"
BREADTH MOULDED 35'0"
DEPTH " 16'10"
" OF HOLD 15'10 1/2"
HEIGHT BETWEEN DECK'S 7'0"

MIDSHIP SECTION.

5/5 N° 159.

SCALE 1/2" = 1 FOOT ENGLISH

BERGENS M.H. VERFABT 22-6-1909.

005489-005502-0099

W O B C F






yc
in

20
d's
da

Re
ati

eg
or

115

ter

© 2020
Lloyd's Register
Foundation