


A circular purple ink stamp. The outer ring contains the text "GRANGEMOUTH DOCKYARD CO." at the top and "GRANGEMOUTH" at the bottom, separated by two small stars. In the center, the words "Ship Builders" are written in a cursive script.

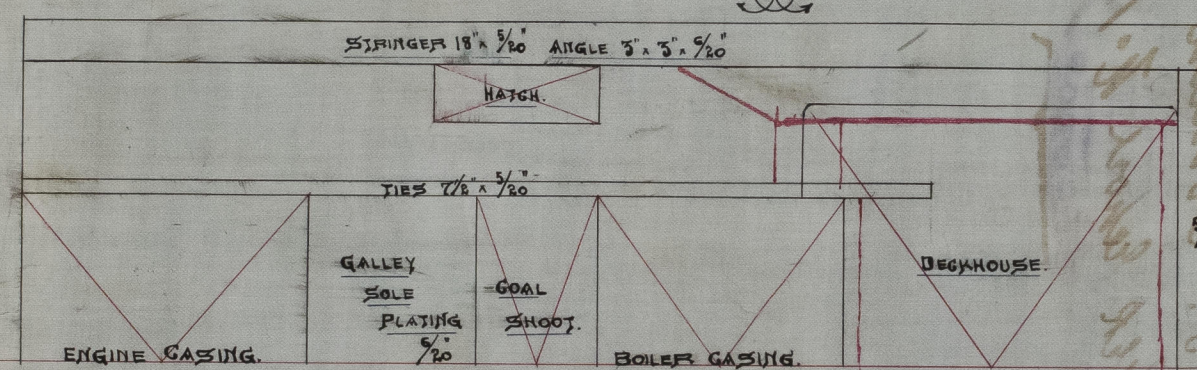


— No. 213 —

PROFILE & DECK PLAN

DIMENSIONS 185'-0" B.P. x 31'-0" x 14'-9" MLD.

— SCALE 1/8" = 1 FOOT. —

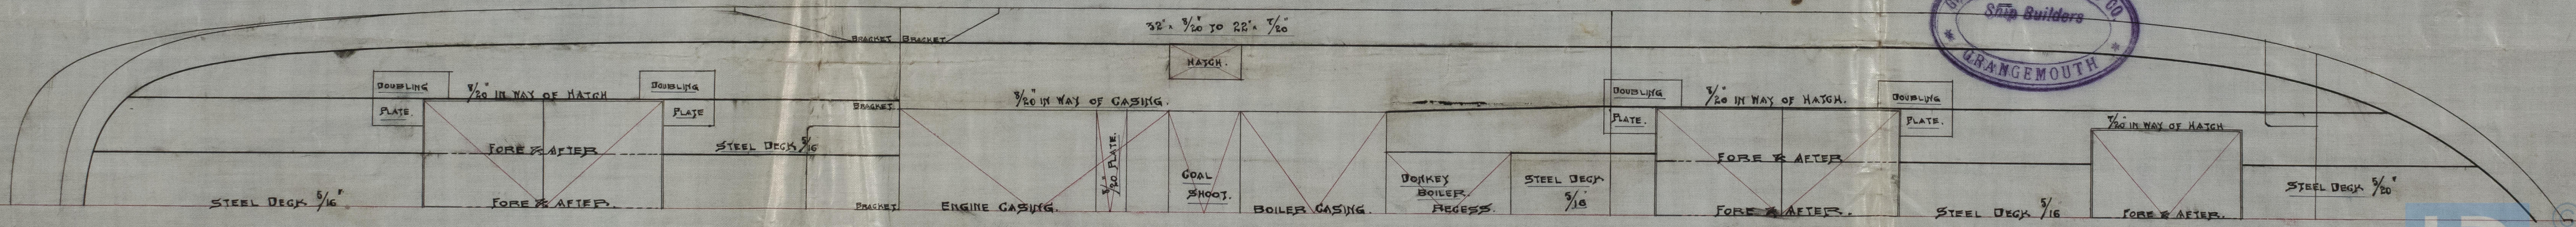

EGH 5/20"

© 2020

Lloyds Register Foundation

7/6/00

7/6/00

7/6/00

Profile & E.H. Plan
Grangemount DYC

No 213

S.S. "Ionian"

Gen Report No. 12934



© 2020

Lloyd's Register
Foundation