


24.11.09.

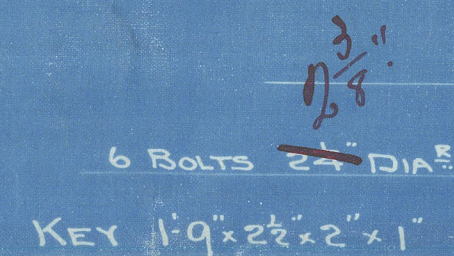

RIVETS IN RUDDER ARMS  $1\frac{1}{2}$ " DIA.  
SPACED 5" PART C<sup>RS</sup> REELER.  
HOLES DRILLED  $1\frac{1}{16}$ " & COUNTERSUNK  
ON SIDE OPPOSITE TO PLATE




- Stern + Pudder Frames  
Charles S. & Co's  
No 564

of Darlingtoun  
Hull Report No. 22965

"Sora"

Rpt. No. 22965

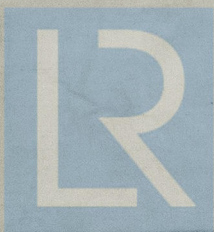

© 2020

Lloyd's Register  
Foundation

005489-005502-0184