

Lloyd's Register of Shipping.

(Report on Vessel No. _____ Port Hull)

No. _____ SHIP FORGINGS OR CASTINGS.

I have to report that the undermentioned Iron or Steel Forgings or Castings, manufactured by M^{rs} J. S. Forster & Son Ltd of Sunderland, for the Vessel No. 453, being built by Cook, Kelton & Gemmill Ltd of Beverly have been inspected by me as set forth below and found to be, so far as can be seen, Sound.

Report on Forgings or Castings.

Lloyd's

No. 4146

8-2-26



D. D. Williamson

Sunderland, 10-2-26



	STERN FRAME.	RUDDER FRAME.	STEM.
Material* ...	<u>Scrap Iron</u>		
made † ...	<u>Forged</u>		
Dimensions ...	<u>6" x 3 1/4"</u>		
Progress on Inspection ...	<u>Forged & Finished</u>		
When Inspected ...	<u>25-1-26 to 8-2-26</u>		
CASTINGS.			
Tests on Standard Test Pieces.			
Tensile Test—			
Tons per square inch ...			
Extension per cent. ...			
180° Bending Test—			
Angle before fracture ...			
Drop Test—			
Height from ground ...			
Numbering Test—			
If made according to Rules and found satisfactory ...			

SKETCHES OF FRAMES SHOWING POSITION AND DESCRIPTION OF WELDS OF FORGINGS.

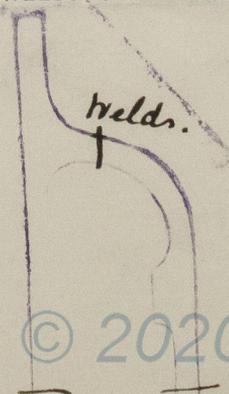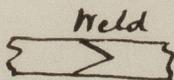

Fee (if any chargeable) £

To be paid at

If of Iron, state whether scrap or puddled Iron. If of Steel, state whether made on the Open Hearth process.

† State if annealed



© 2020

Lloyd's Register Foundation