

Lloyd's Register of Shipping.

(Report on Vessel No. _____ Port Hull)

No. _____ SHIP FORGINGS OR CASTINGS.

I have to report that the undermentioned Iron or Steel Forgings or Castings, manufactured by Messrs L. S. Forster & Sons Ltd of Sunderland, for the Vessel No. 483, being built by Cook, Welton & Gemmill Ltd of Beverley have been inspected by me as set forth below and found to be, so far as can be seen, Sound.

Mark on Forgings or Castings.

Lloyd's
No. 4146
18-2-26



D. D. Williamson

Sunderland, 18-2-26



	STERN FRAME.	RUDDER FRAME.	STEM.	
Material* ...	/	Scrap Iron Forged	/	
How made † ...		5" dia 5x5" to 4x3"		
Dimensions ...		Forged & Finished		
Progress on Inspection ...		11-2-26 to 18-2-26		
Date when Inspected ...				
CASTINGS.				
Tests on Standard Test Pieces.				
Tensile Test—				
Tons per square inch ...				
Extension per cent. ...				
Old Bending Test—				
Angle before fracture ...				
Drop Test—				
Height from ground ...				
Hammering Test—				
If made according to Rules and found satisfactory ...				

SKETCHES OF FRAMES SHOWING POSITION AND DESCRIPTION OF WELDS OF FORGINGS.

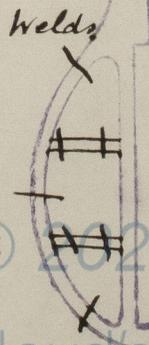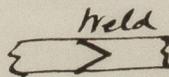

Fee (if any chargeable) £ : :

To be paid at _____

* If of Iron, state whether scrap or puddled Iron. If of Steel, state whether made on the Open Hearth process.