

# S.S. NALPA.

## MIDSHIP SECTION.

SCALE 1/2" = ONE FOOT.

CLASS—NORSKE VERITAS 1A1 MATERIAL TESTED TO RULE.  
LENGTH 179'-10". BREADTH 28'-6". DEPTH 14'-4 1/2" + 3'-6" RQ DECK.

SHEER: AT STEM 5'-0" AT 2L FROM STEM 1'-11" AT STERNPOST 3'-0"

Tonn. COEFF. = .80. FORECASTLE 24'-0". BRIDGE 11'-0" RAISED QUART DECK 85' LONG.

1/2 BREADTH 14'-3". 1/4 = 12.51. 1/8 = 1006

DEPTH = 14'-4 1/2". TOPSIDE NUMBER UPPER DECK 9983 (12.51)<sup>2</sup> = 15603.


1/8 GIRTH = 26'-10 1/2"

R.Q. DECK 9983 (10.06)<sup>2</sup> = 10103.

TRANSVERSE N° = 55'-6"

LENGTH 179'-10"

LONGITUDINAL N° = 9983.

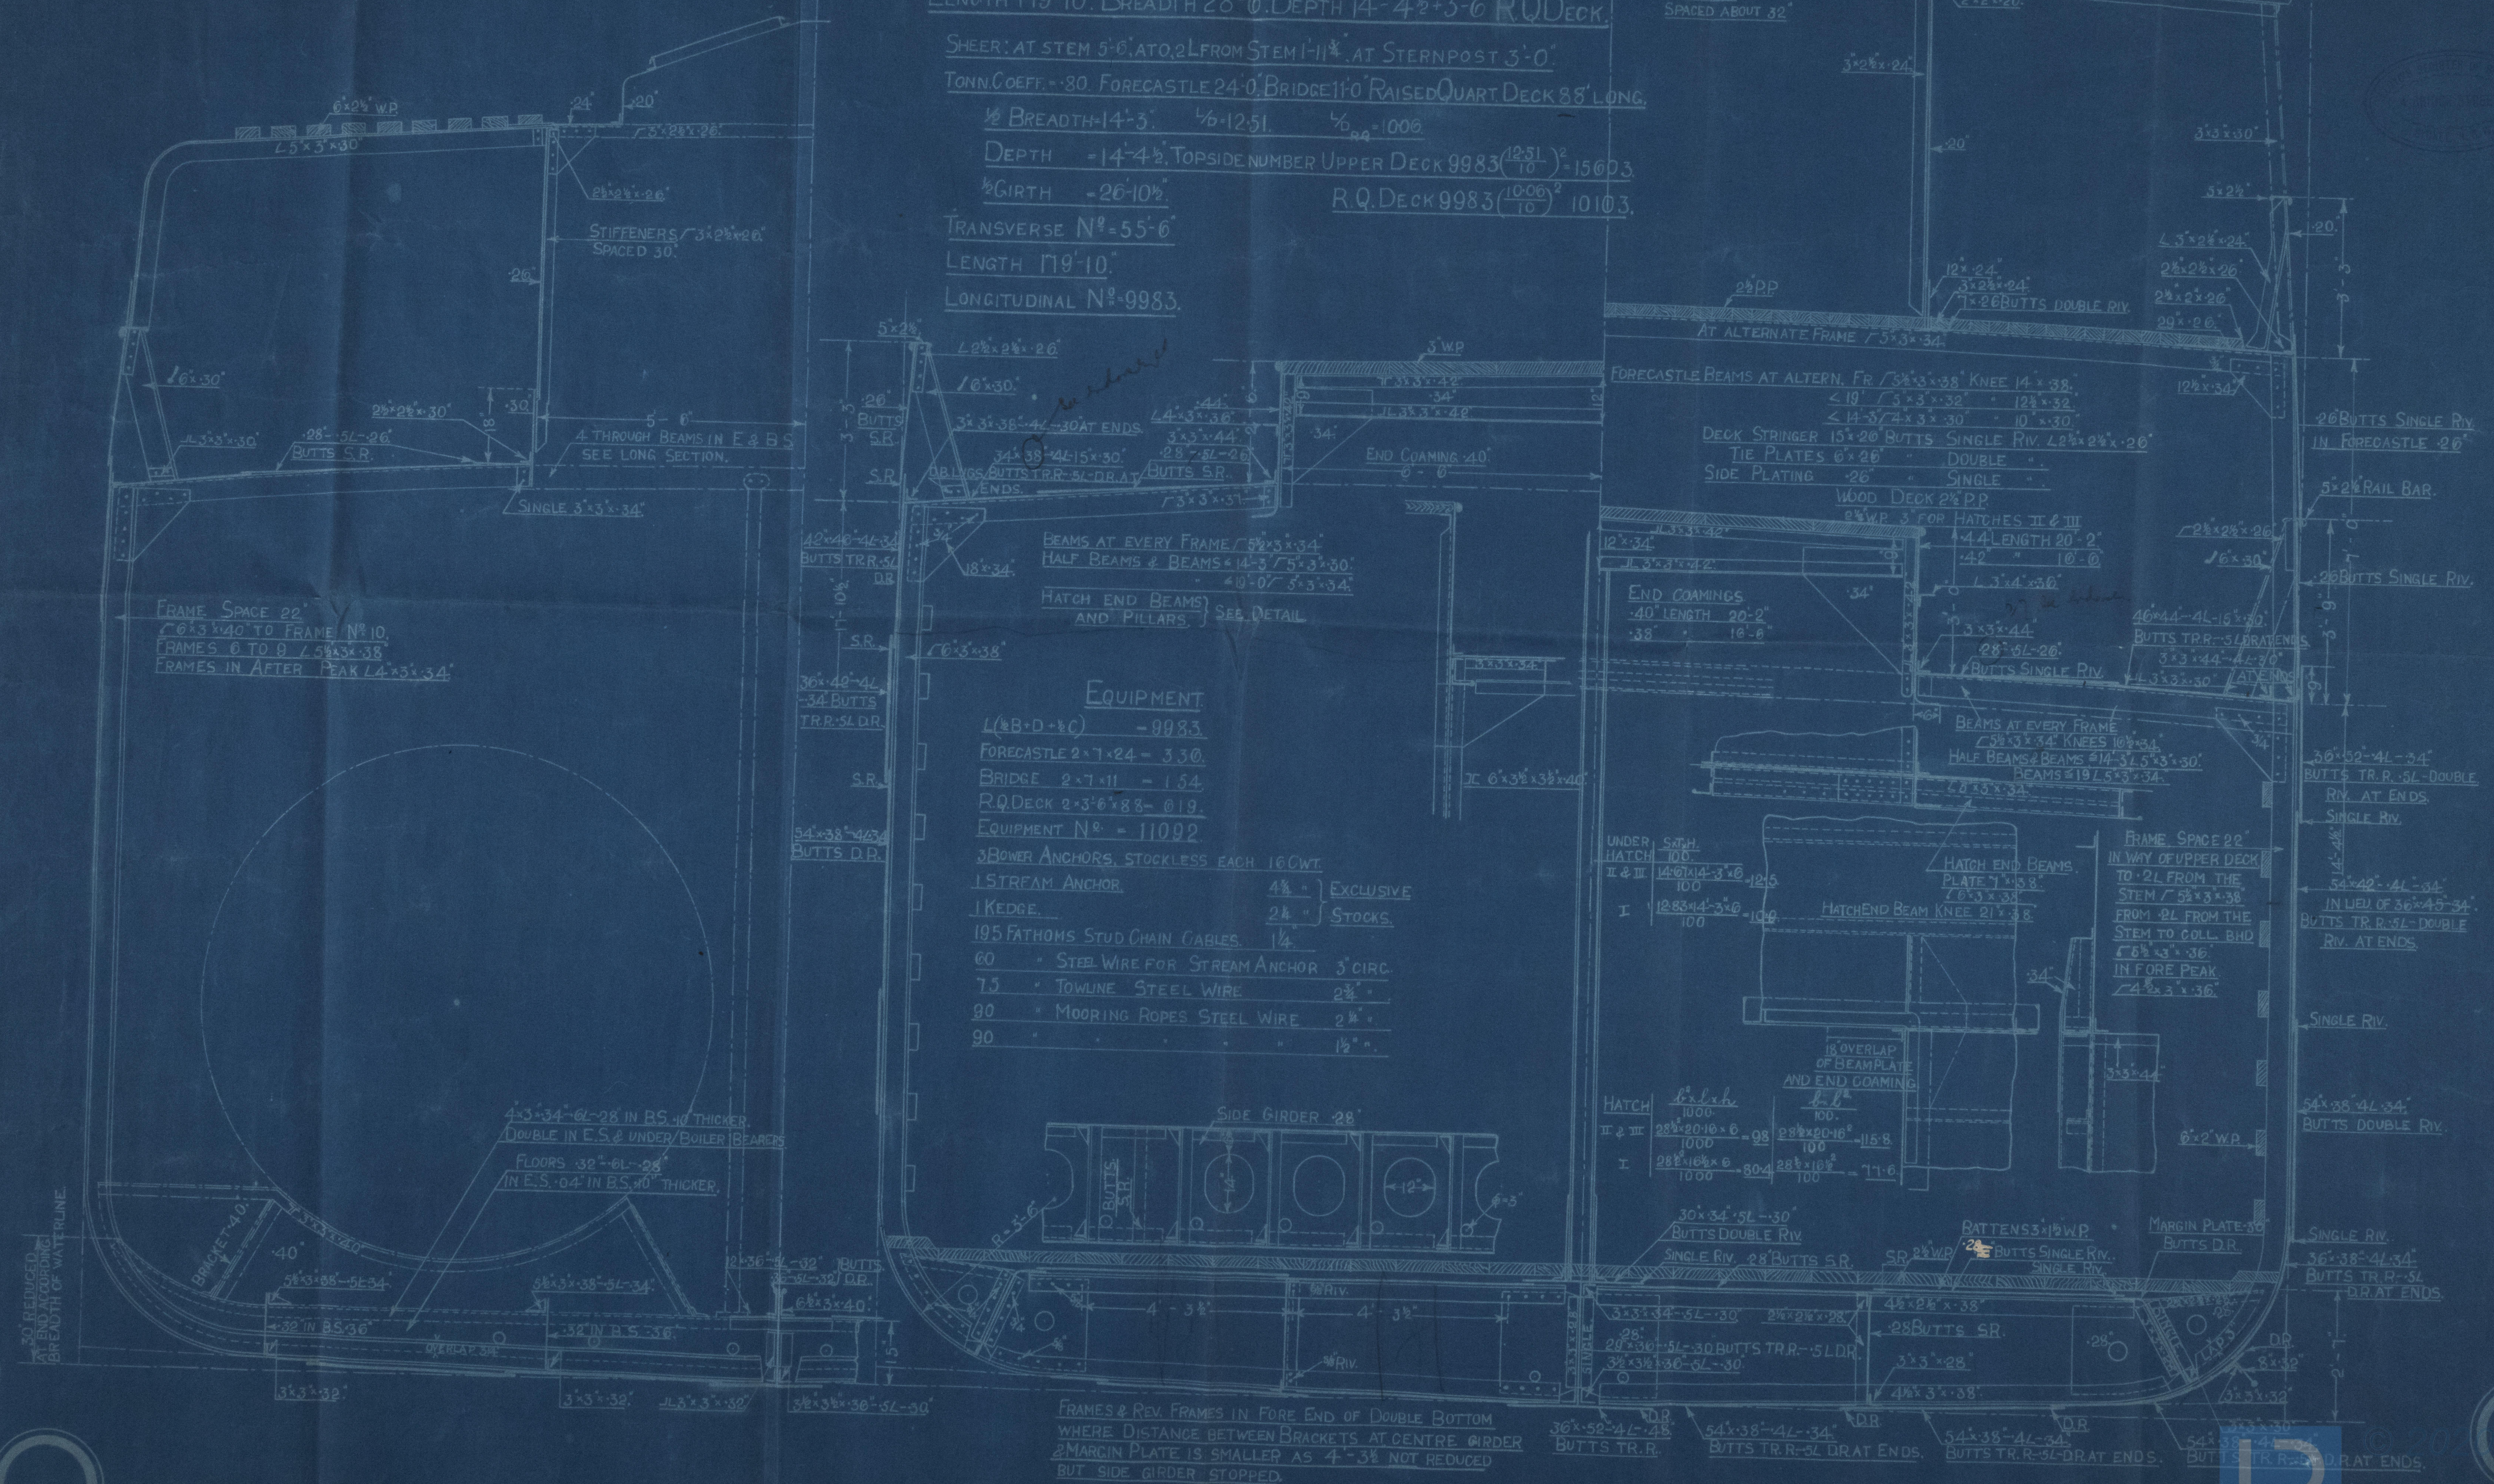

- ### EQUIPMENT
- L(B-D+C) - 9983
  - FORECASTLE 2' x 24" = 330
  - BRIDGE 2' x 11" = 154
  - EQUIPMENT N° = 11092
  - 2 BOWER ANCHORS, STOCKLESS EACH 16 CWT.
  - 1 STREAM ANCHOR 4 1/2" EXCLUSIVE
  - 1 KEDGE 2 1/2" STOCKS
  - 195 FATHOMS STUDD CHAIN CABLES 1 1/4"
  - 60 " STEEL WIRE FOR STREAM ANCHOR 3" CIRC.
  - 75 " TOWLINE STEEL WIRE 2 1/2"
  - 90 " MOORING ROPES STEEL WIRE 2 1/2"
  - 90 " " " 1 1/2"

FRAMES & REV. FRAMES IN FORE END OF DOUBLE BOTTOM WHERE DISTANCE BETWEEN BRACKETS AT CENTRE GIRDER 2' MARGIN PLATE IS SMALLER AS 4'-3 1/2" NOT REDUCED BUT SIDE GIRDER STOPPED.



Buranda  
EX  
S. S. Halpa  
Midship Section



Syd. Rpt No 13534



© 2020

Lloyd's Register  
Foundation

005518-005528-0086