

5.10.16

Lloyd's  
ROTTENSCHE  
AM. SCHIEDSW  
25/9/16  
DROUOK MIL  
SV


SS N<sup>o</sup> 72

# FORGED STEEL RUDDER & STERNFRAME


SCALE 1"=1'0 & 3"=1'0

MATERIAL WITH LLOYDS TEST  
& CERTIFICATE.


RUDDER AREA 66 1/2 FEET.  
CENTRE OF GRAVITY AT 2'6  
SPEED UNDER 10 KNOTS.

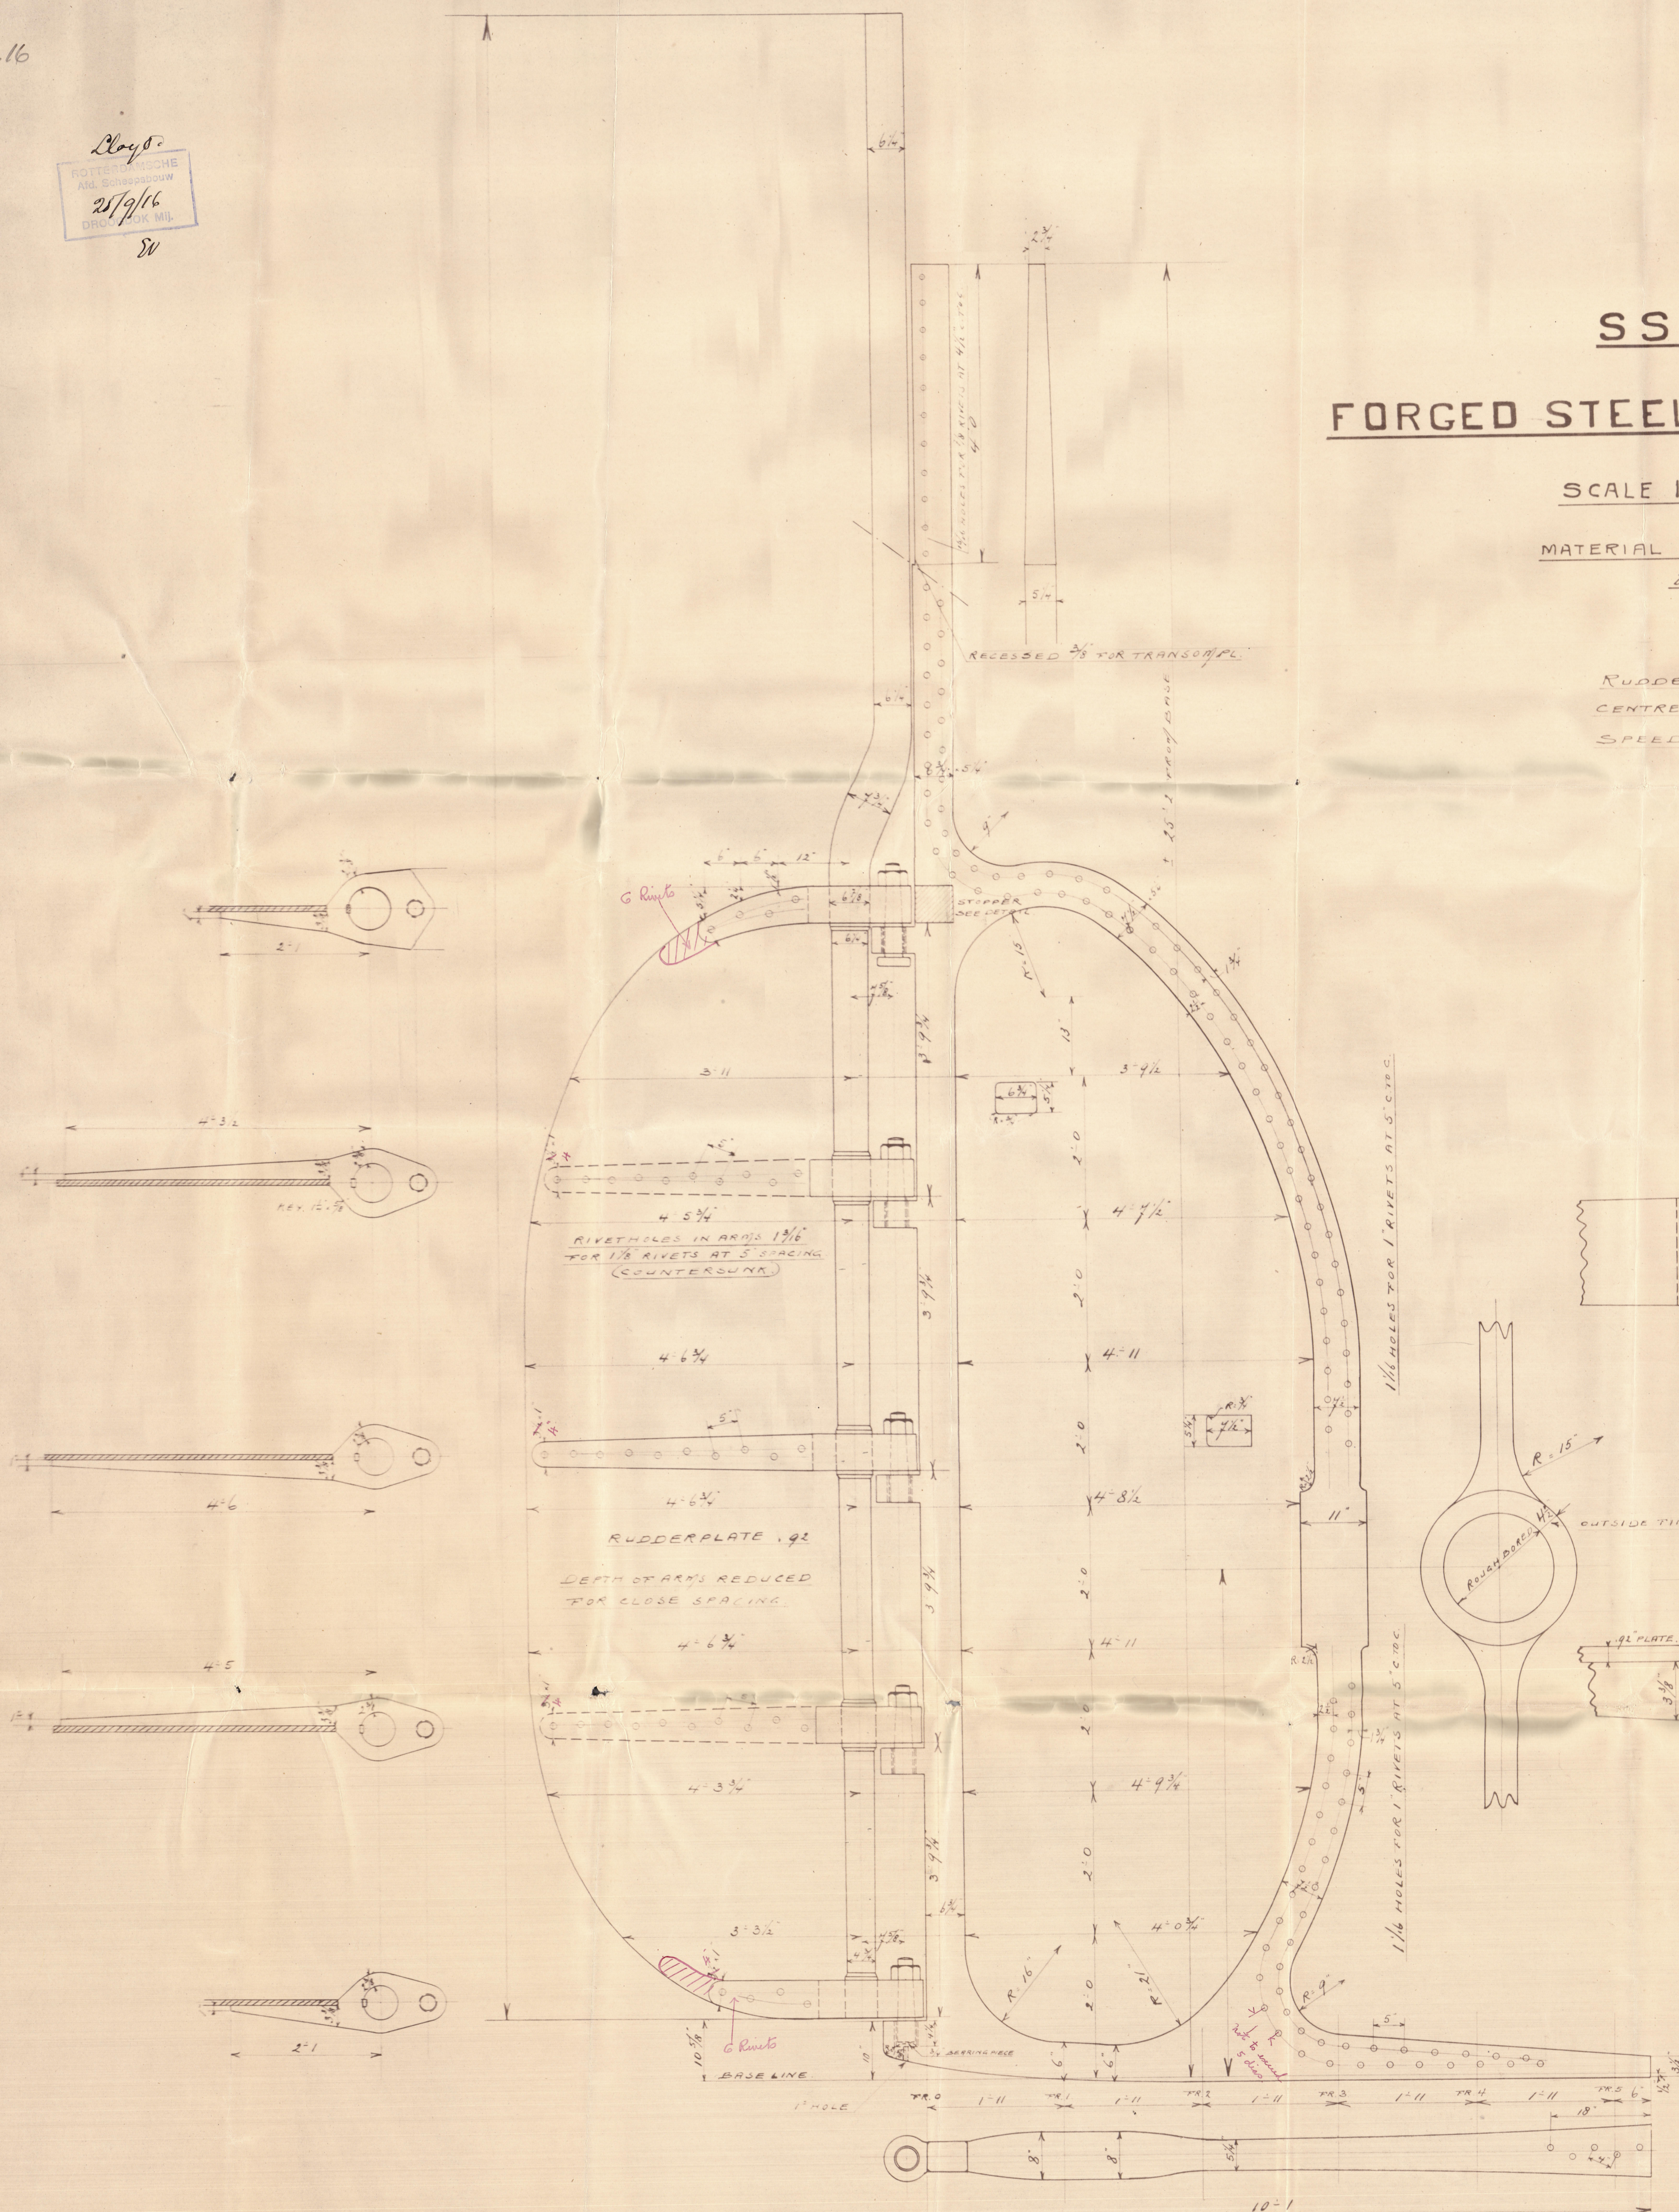


DETAIL OF GUDGEON & PINTLE  
SCALE 3"=1'0

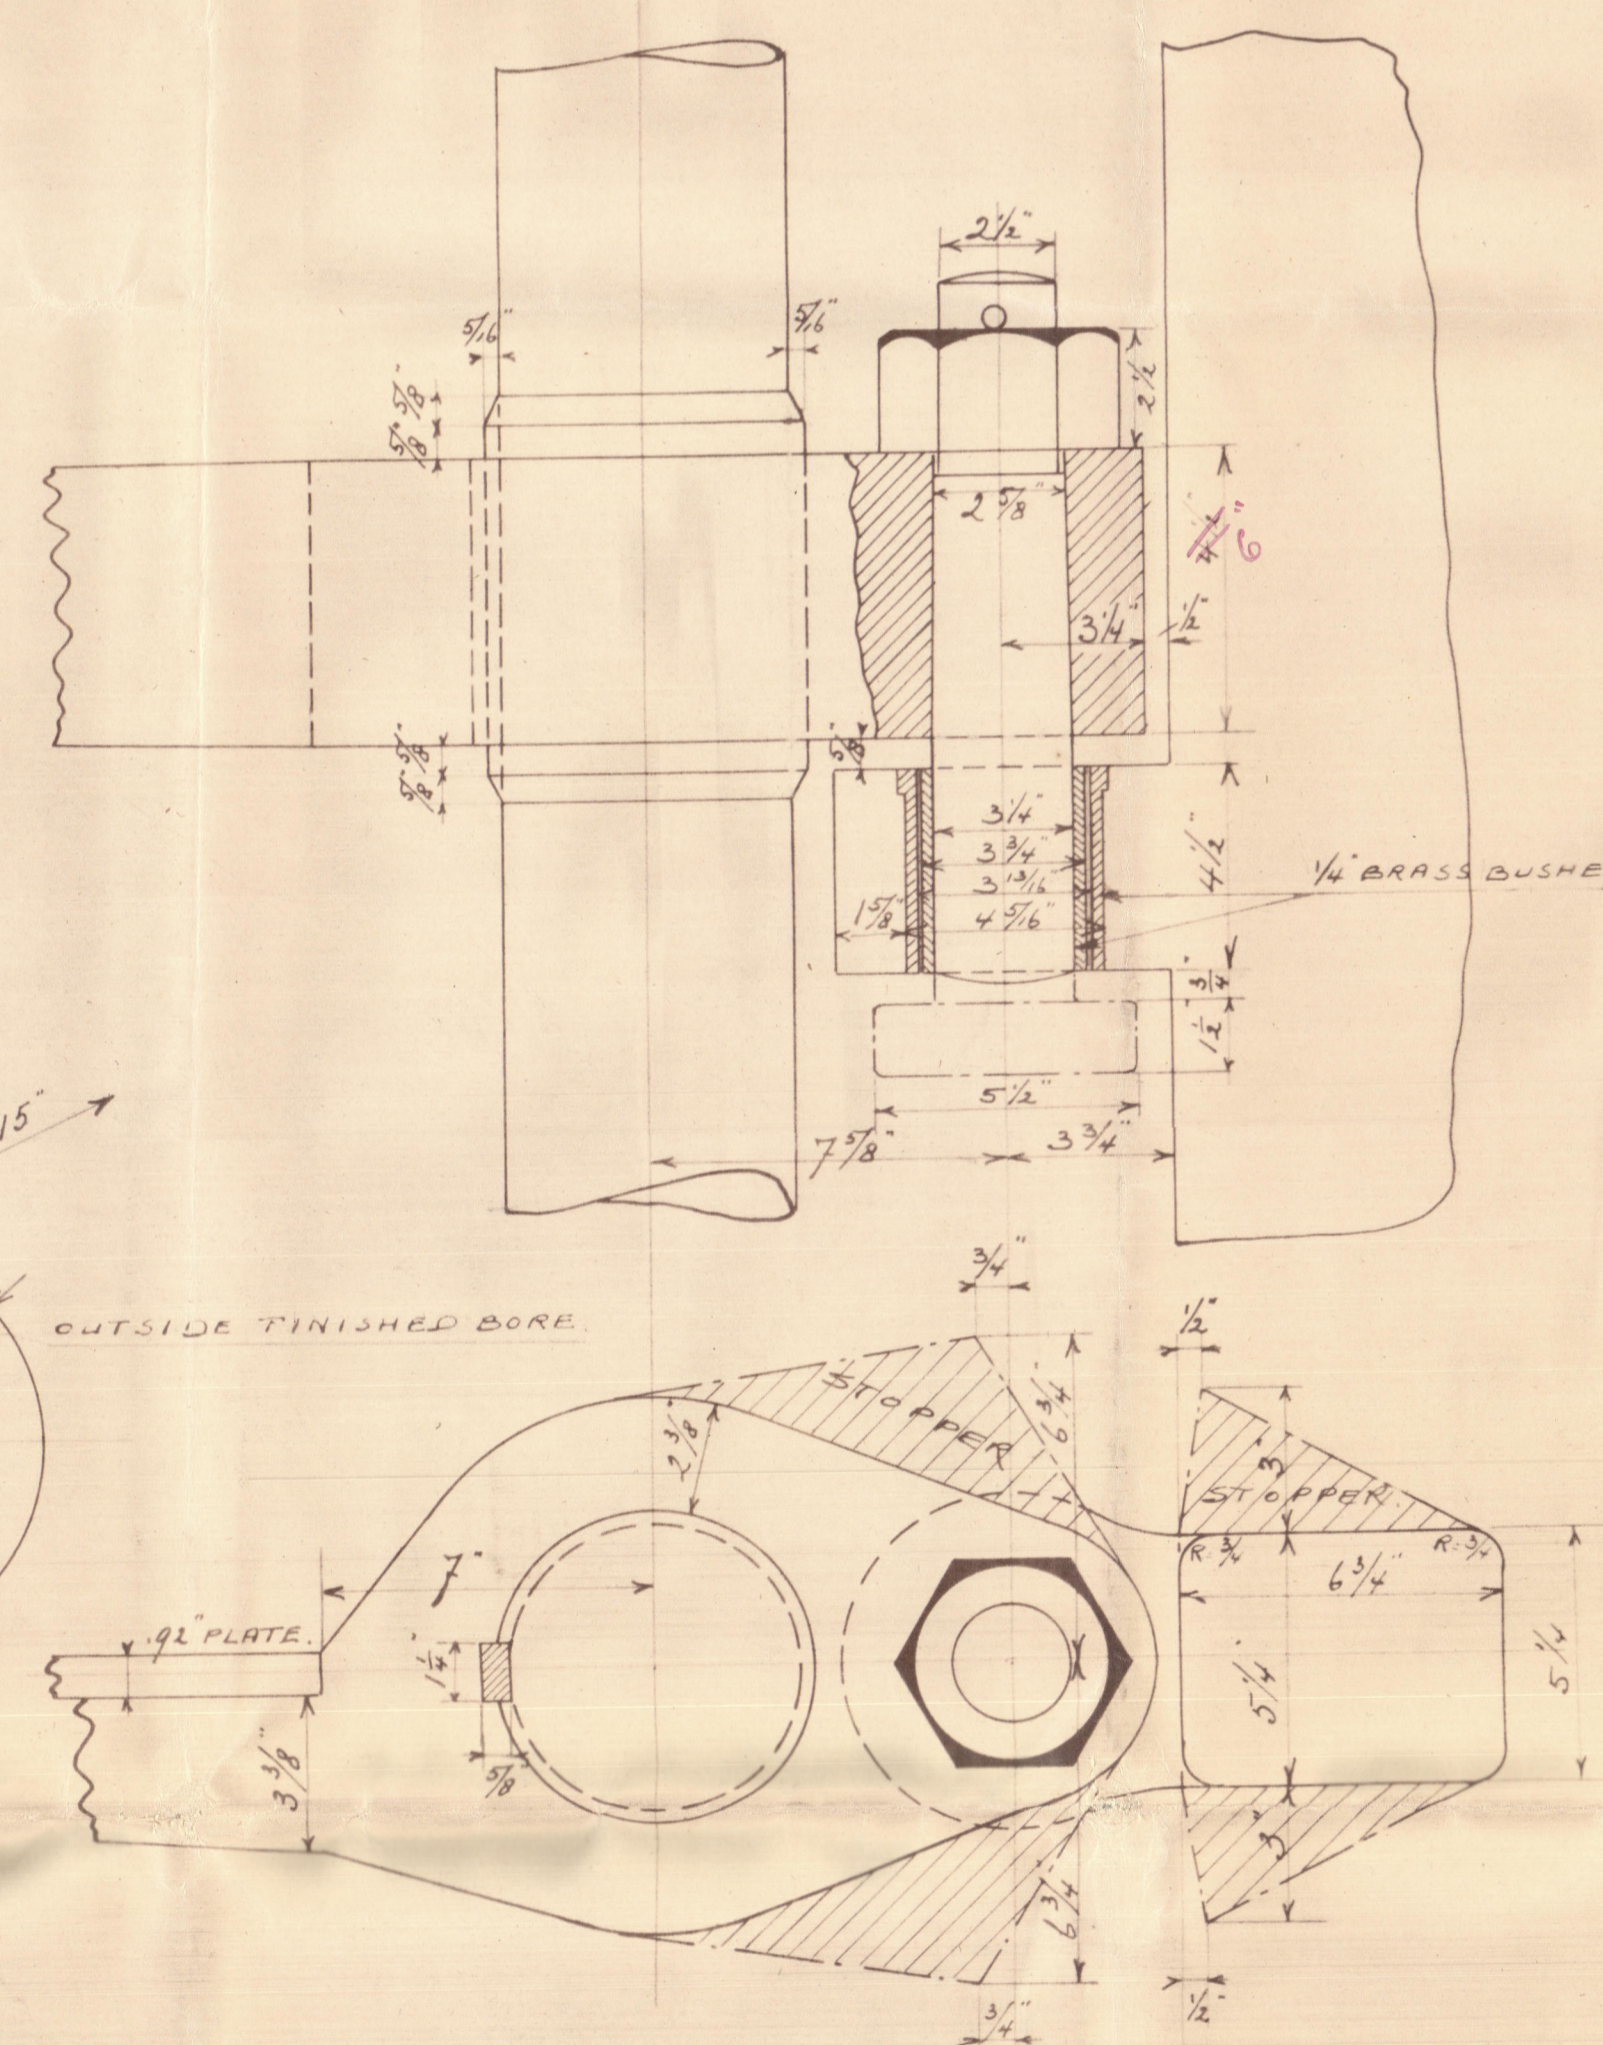


SECTION AT END.

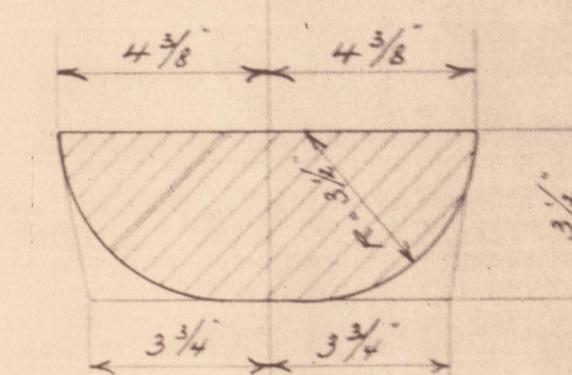


SECTION AT FRAME 5

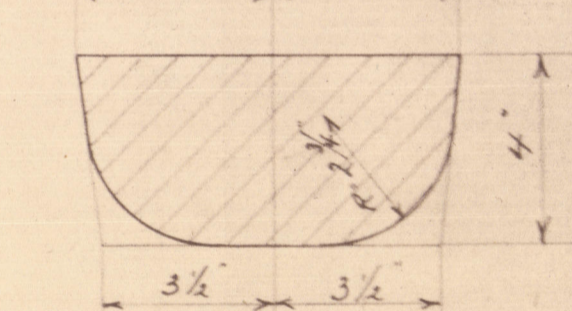

SECTION AT FRAME 4

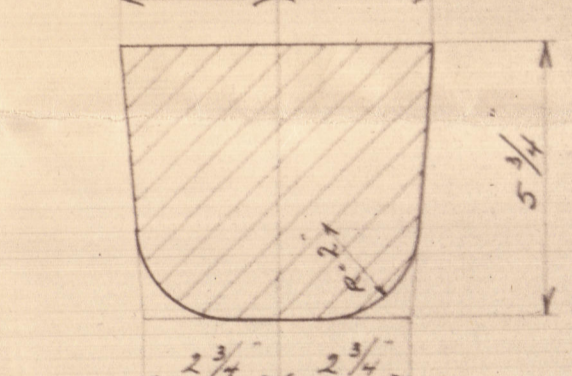

SECTION AT FRAME 3

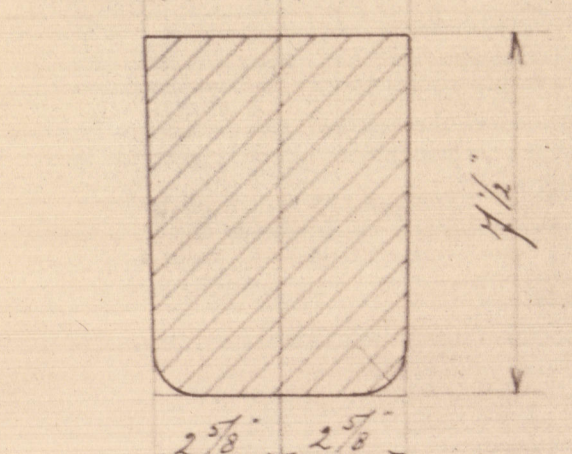

5.10.16.

S.S. 72



Rudder & Sternframe

S.S. Jaarwerkzaam.

Rotterdam ref. N<sup>o</sup> 10060

Plan of Rudder & Sternframe

3 plans

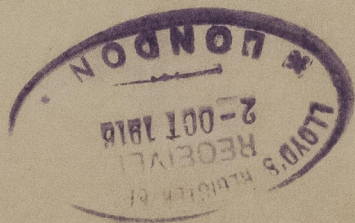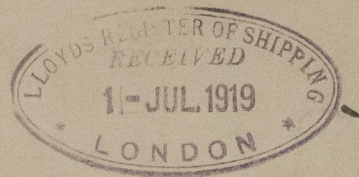

003518-005528-0222



© 2020

Lloyd's Register  
Foundation