


Nº S3.

# S.S. CHERIBON MARU.

## CENERAL ARRANCEMENT. (SHEET Nº II.)

SCALE 1/8 INCH TO A FOOT.

(FINISHED.)

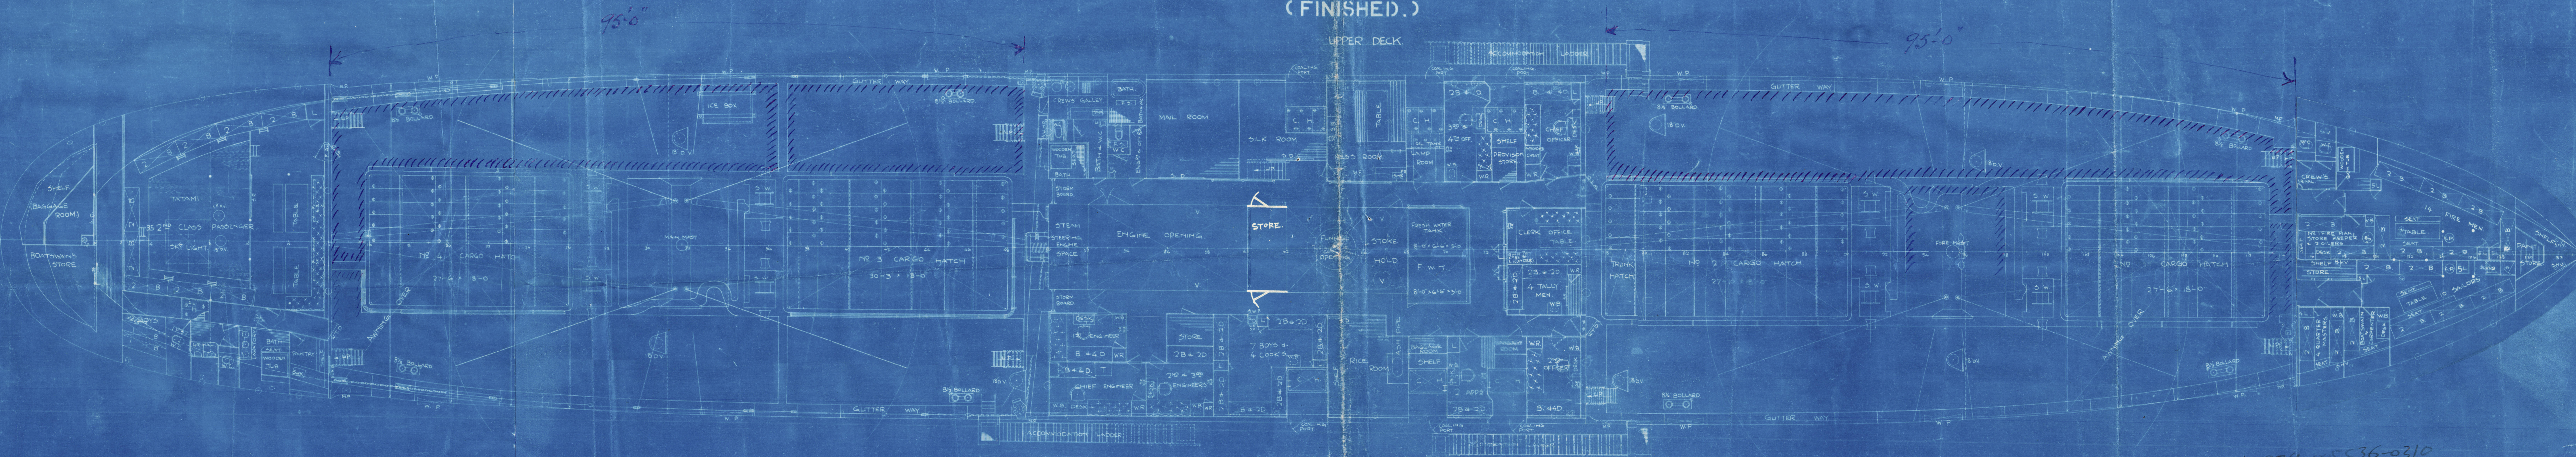



"Cheribon Marie"

Kobe 3237

General Arrangement

005529-005536-0310



© 2020

Lloyd's Register  
Foundation