


# No 63 CONSTRUCTION PROFILE, DECKS & INNER BOTTOM PLAN

SCALE 1/8 IN. TO ONE FT.



Shipping brackets to girders as per Sec. 16, para. 4 and 5.

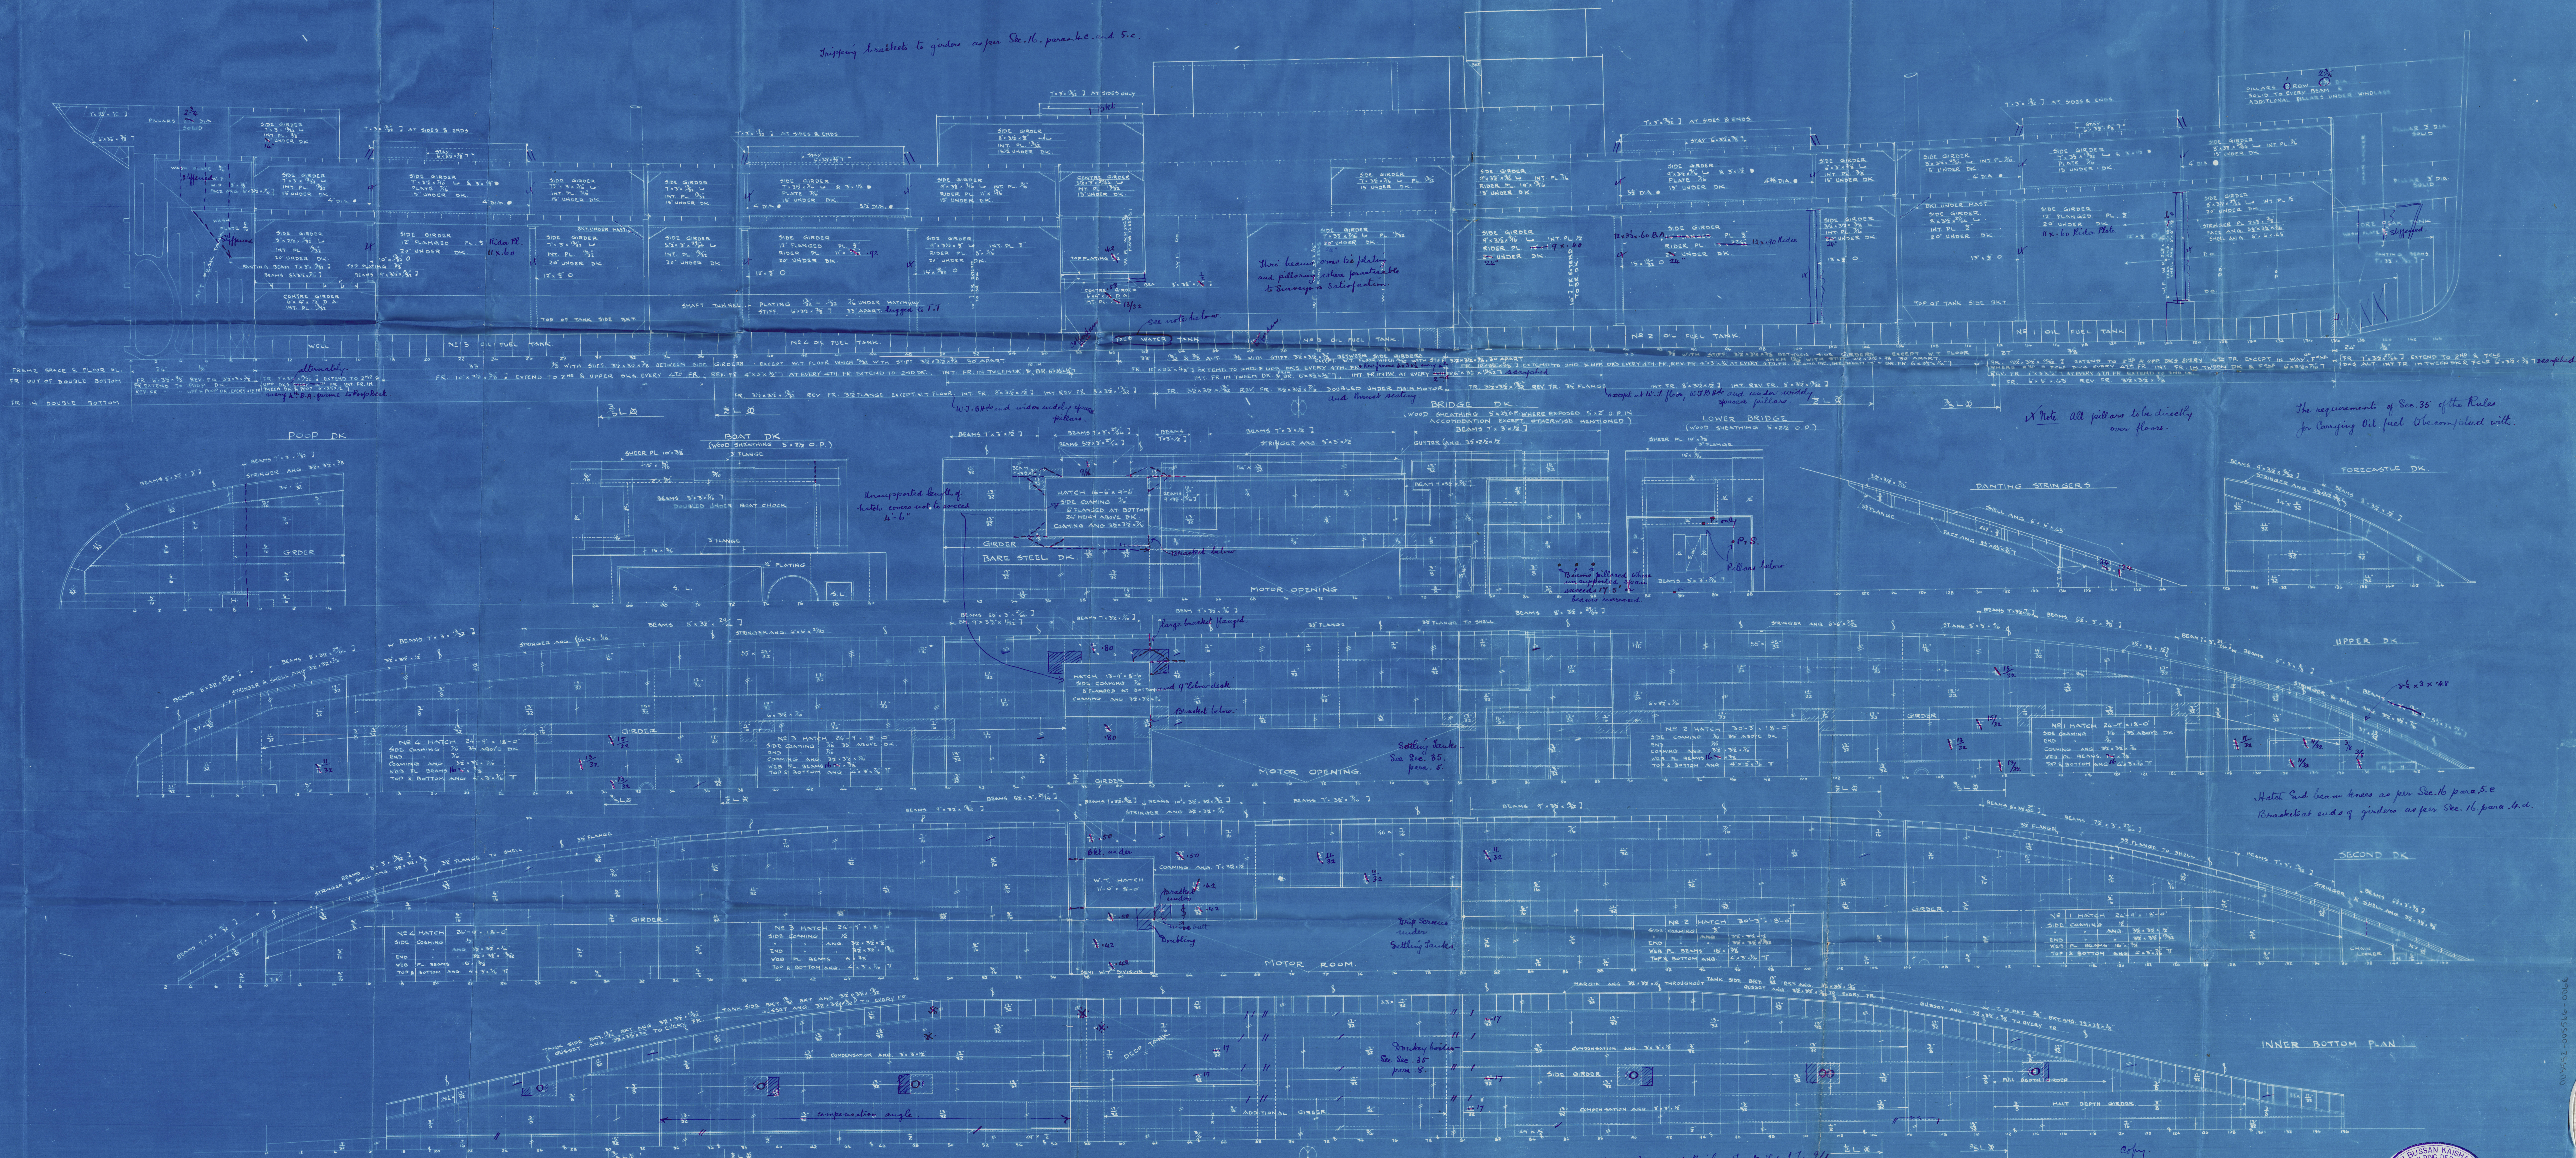

Note. Beam Oil not to be carried in Bay Tank when Double Bottom Tank below is used for fresh water.

\* Butte to be arranged 2 spaces clear of butt in adjoining strake.

Note. In way of Boiler Tank Top, late 1/4" and beams and butts in machinery space to be at least double riveted and oil fuel is carried in double bottom below.

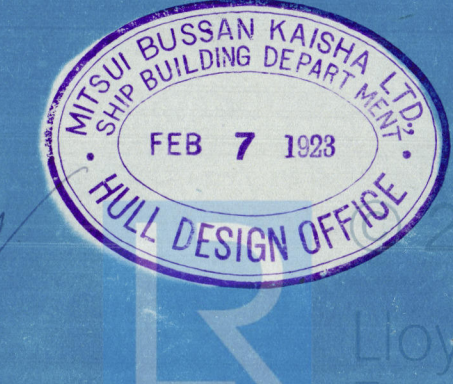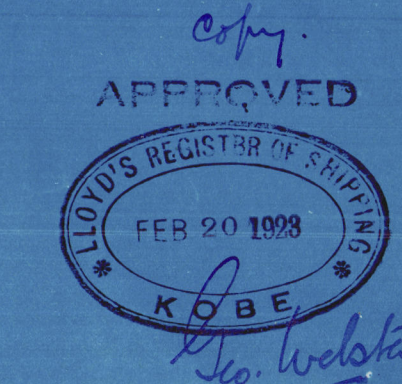



Gen. Box 4008.

"Akagisan Marn"  
Kbe 4469



© 2020

Lloyd's Register  
Foundation

005552-005566-0066



Profile London



© 2020

Lloyd's Register  
Foundation