


N^{os} 139 & 140. 161 x 162.

Midship Section of Two Steel Screw Tugs.

Dimensions: 80'-0" x 22'-0" x 12'-3" Mtd

To Class 100 A.1. at Lloyds.

Scale 1/2" = 1 Foot.

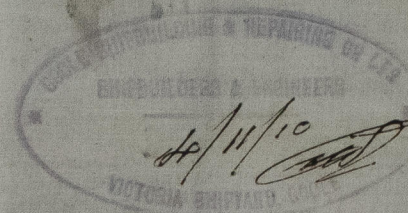

Equipment.

2 Anchors	4 Cwts. each ex Stock
1 Anchor	2 1/4 Cwt ex Stock
30 Fathoms	2" Wire Hawser
40 Fathoms	5 1/2" Manilla Hawser
90 Fathoms	3" Manilla
90 Fathoms	4" Manilla
About 3 Fathoms	of 9" Manilla
60 FATHOMS	1 1/16" STUD LINK CHAIN


Numerals.

Trans: N^o = 22 + 12.25 = 34.25

D = 11.09

Longl N^o = 34.25 x 80 = 2740.

$\frac{L}{D} = 6.53$

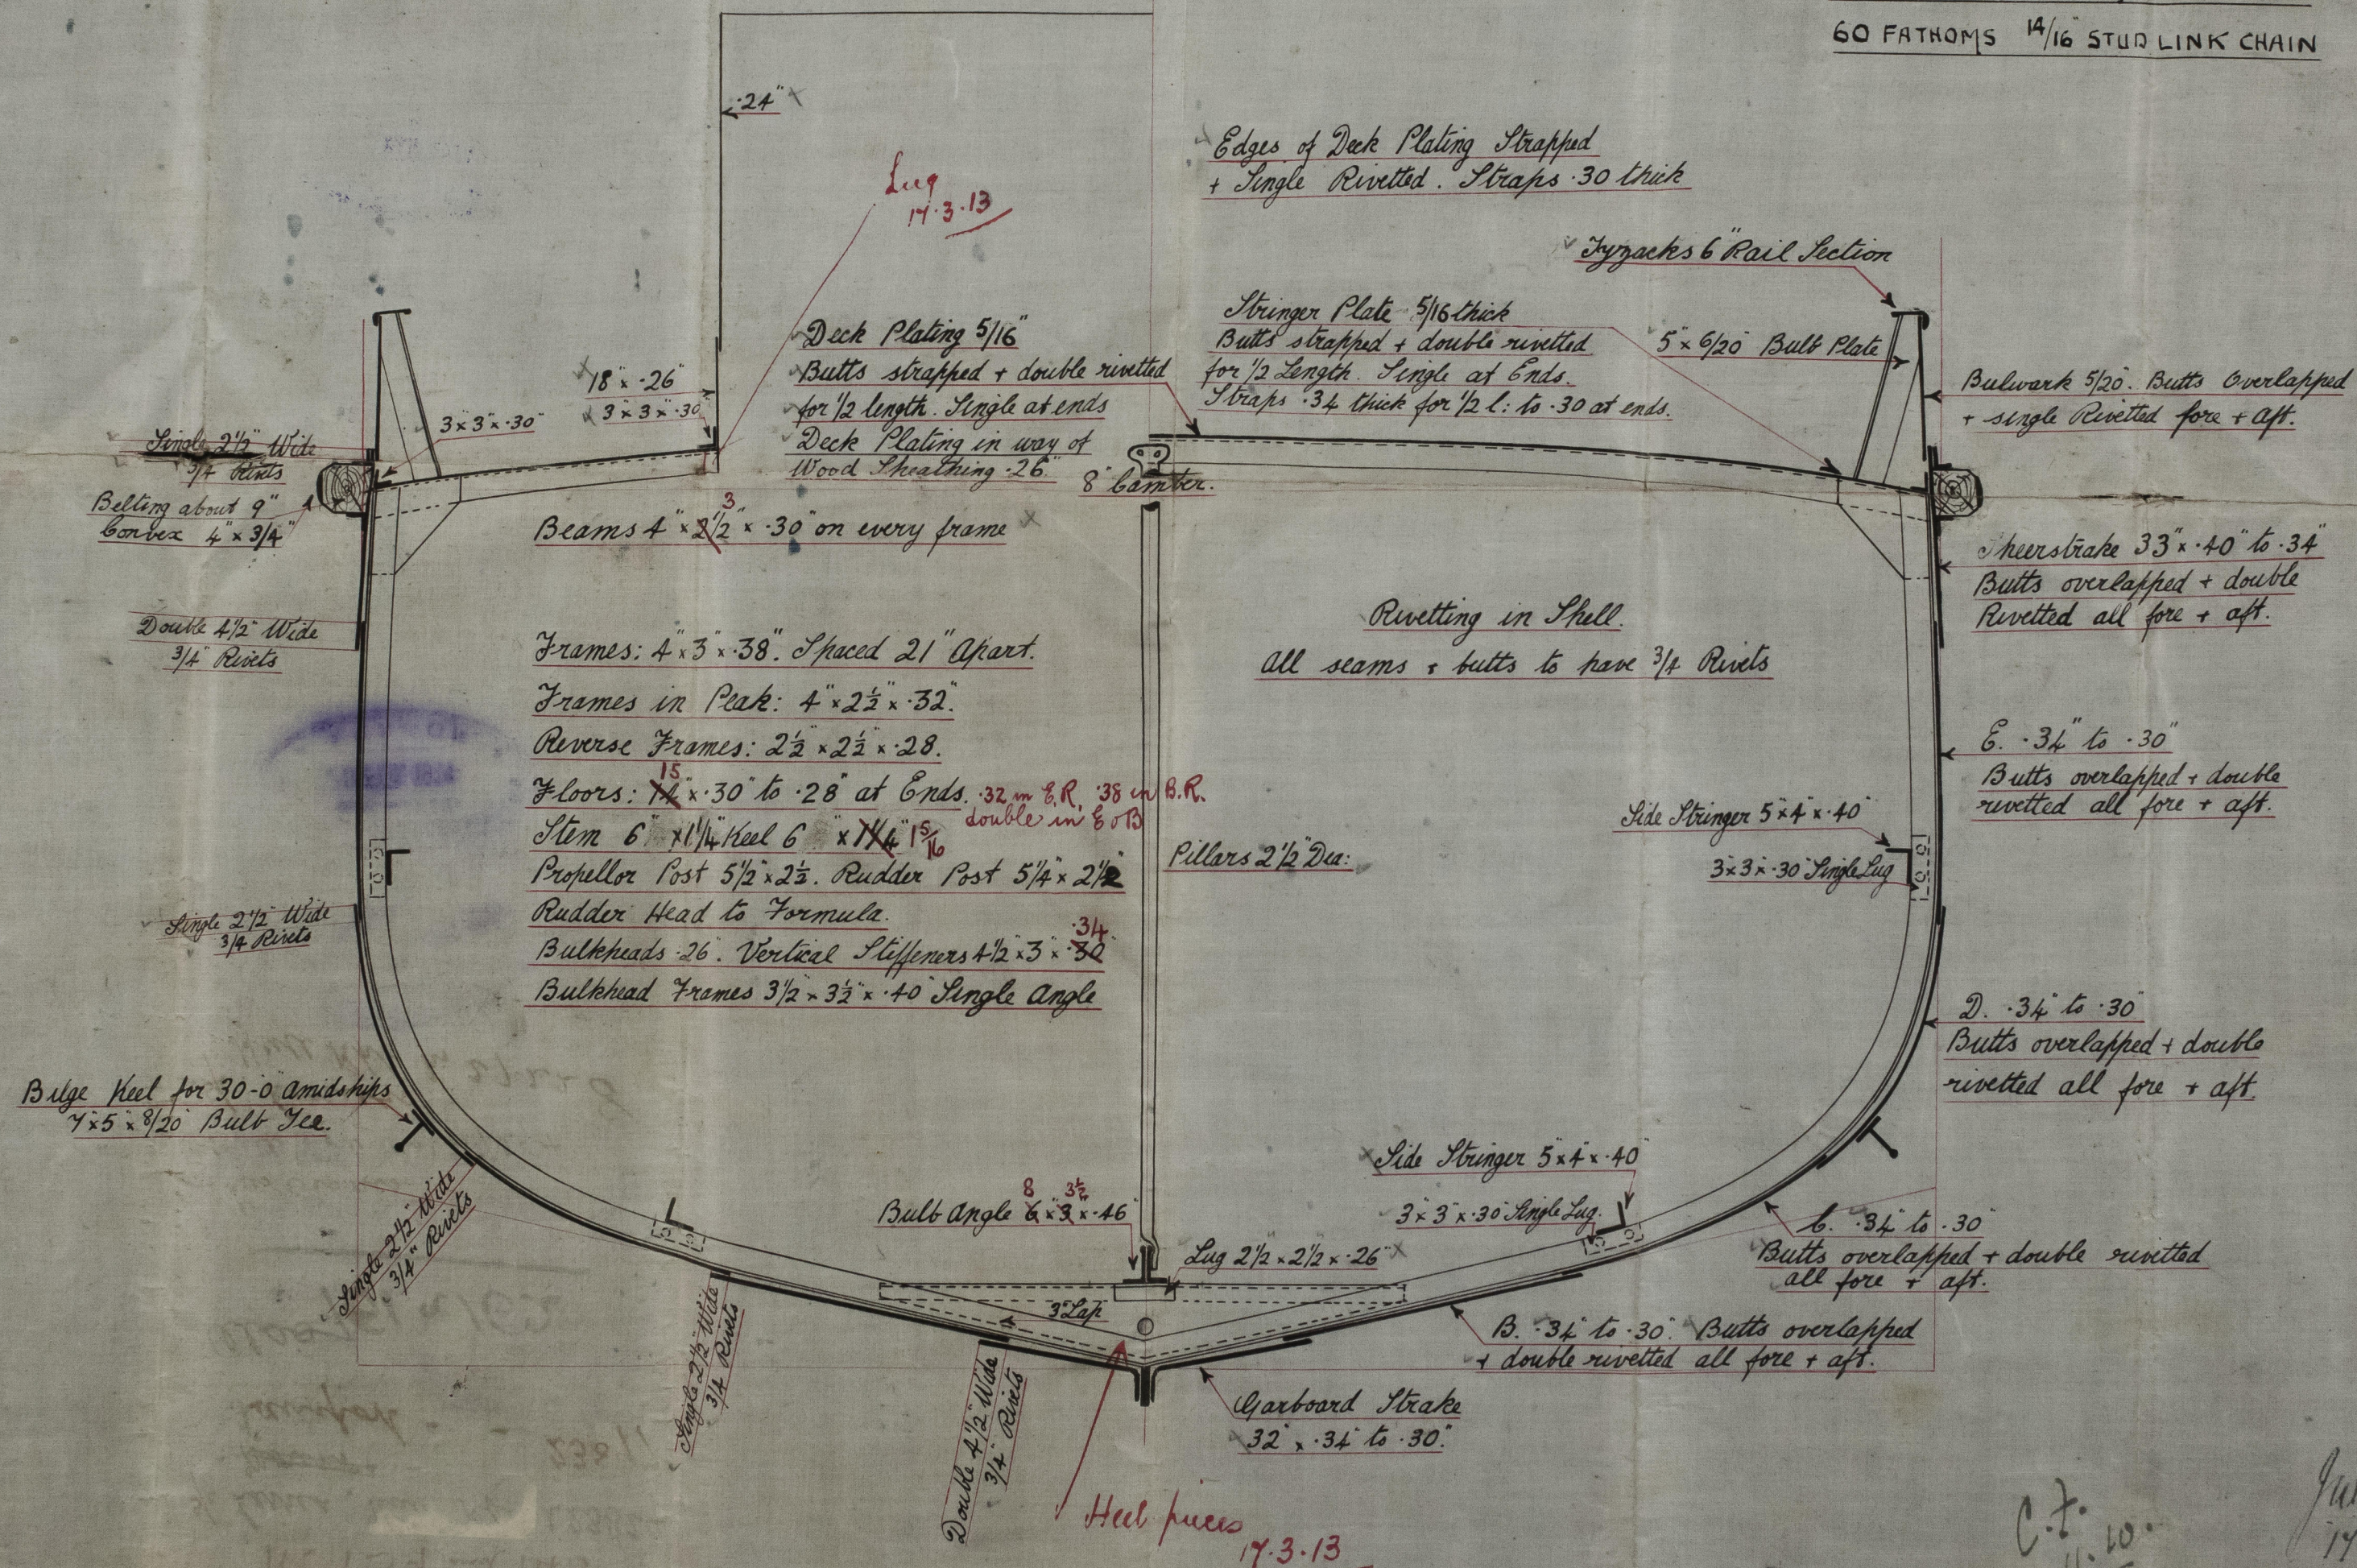

© 2020

Lloyd's Register Foundation

Boole S. & R. Co. Ltd.

Midship Section

No 139 and 140

s/s Larrea. Hull Rpt 223829

~~Moran~~

Lampford - - 23897

Also 161 & 162

s/s Liners

Hull Rpt No 27384

s/s Liners

Hull Rpt No 27228

DS 58.



© 2020

005585 - 005601-0120

Lloyd's Register
Foundation