
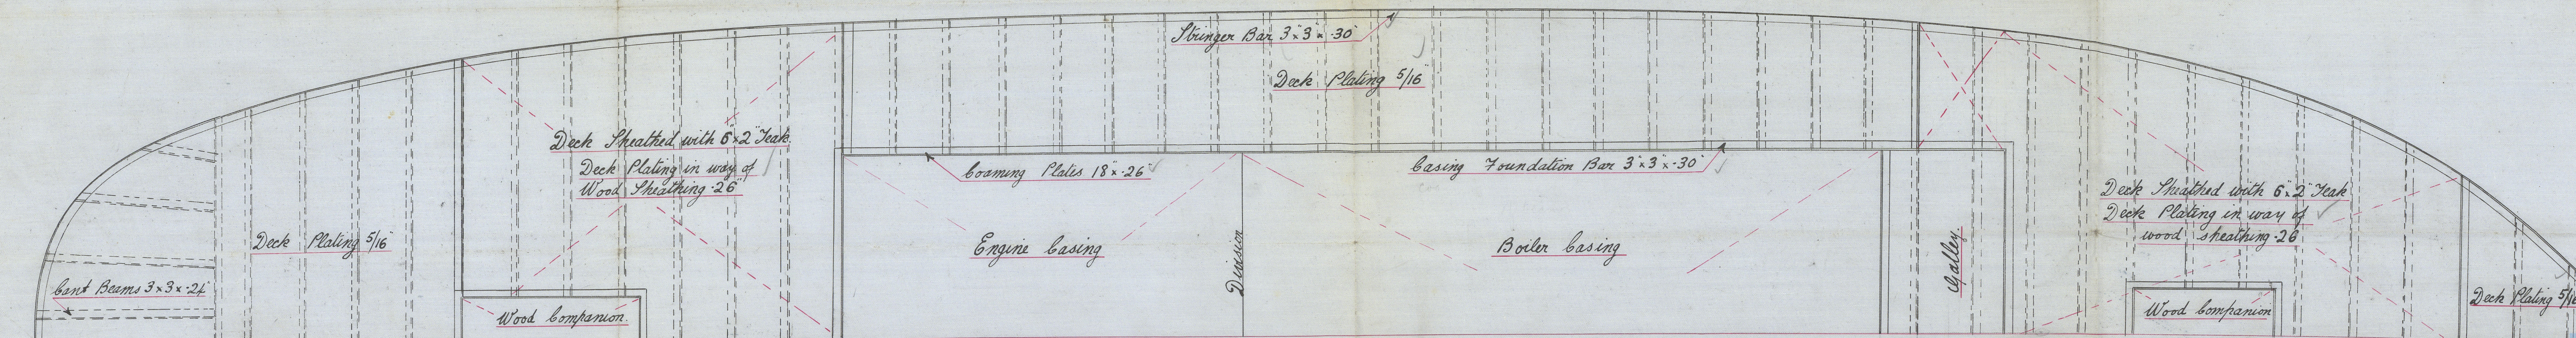


N^{os} 139 + 140. 161 + 102.
 Longitudinal Section.
 Dimensions: 80'-0" x 22'-0" Ex. x 12'-3" Moulded.
 SCALE $\frac{3}{8}$ " = 1 Foot
 To Class 100. A.I. Lloyds.

4/11/10
 SHIPBUILDING & REPAIRING CO. LTD.
 SHIPBUILDERS & ENGINEERS
 VICTORIA SHIPYARD BUILDING

14.11.10
 S.I.N.
 12.1.11
 (612) 17.3.13

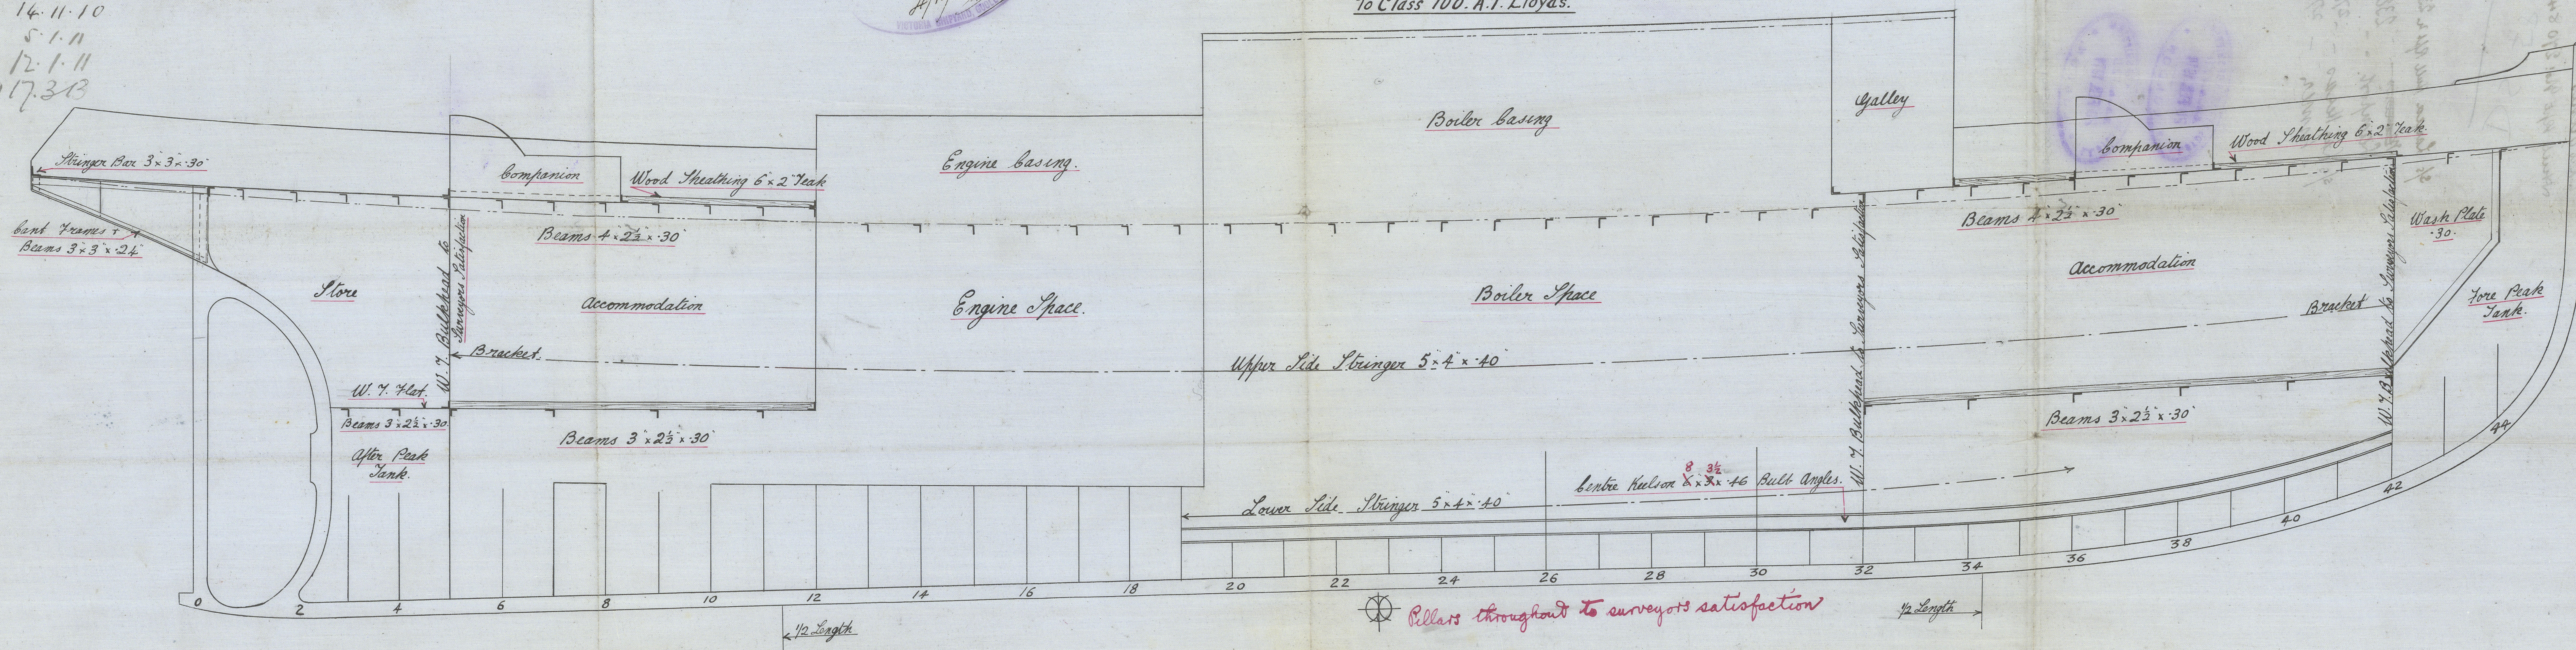

C.F.
 14.11.10.

Book S. & R. C. Ltd.

Profile & Deck Plan

No 139 and 140.

No 161 and 162

Las Heras

Atul. Rpt No: 27084

DS 58



s/s Larrea Hull Rpt n. 23829

~~Moreno~~ - 23897

Lampoon. - -

s/s Las Heras - 27084

Ammer - 27228

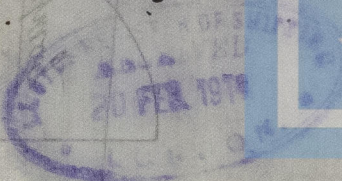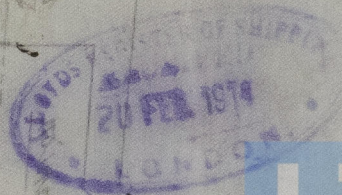

© 2020

Lloyd's Register
Foundation