


FROM  
S, LTD.  
EL

SCALE  $\frac{1}{4}$  INCH = ONE FOOT.


WHALEBACK SUPPORTED TO SURVEYORS SATISFACTION.



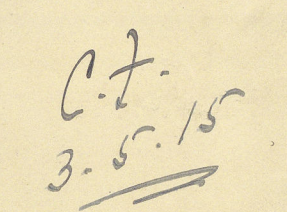

Cochrane & Sons Ltd  
Profile & Deck Plan

P.P. N° 650

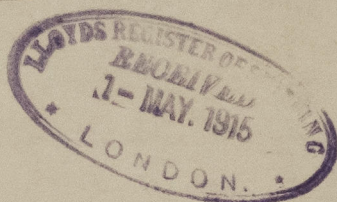

*S.S. "Kutcher" Hull No 29179.*



© 2020

Lloyd's Register  
Foundation

005618-005634-0049