

PLAN No. 5555  
 FOR ENCLOSURE TO  
 Messrs. LLOYDS  
 HULL FROM  
 COCHRANE & SONS, LTD.  
 SHIPBUILDERS, SELBY.  
 DATE 29/4/15

# MIDSHIP SECTION.

STEEL SCREW TRAWLER.

Nº650.


DIMS. 136'-8" B.P. x 23'-4 1/2" MLD. x 13'-0" MLD.

SCALE 1/2"

TO CLASS 100.A.I. LLOYDS STEAM TRAWLER.

DECK PLATED OVER IN WAY OF MACHINERY.

ENGINE & BOILER CASING AS PREVIOUSLY APPROVED.

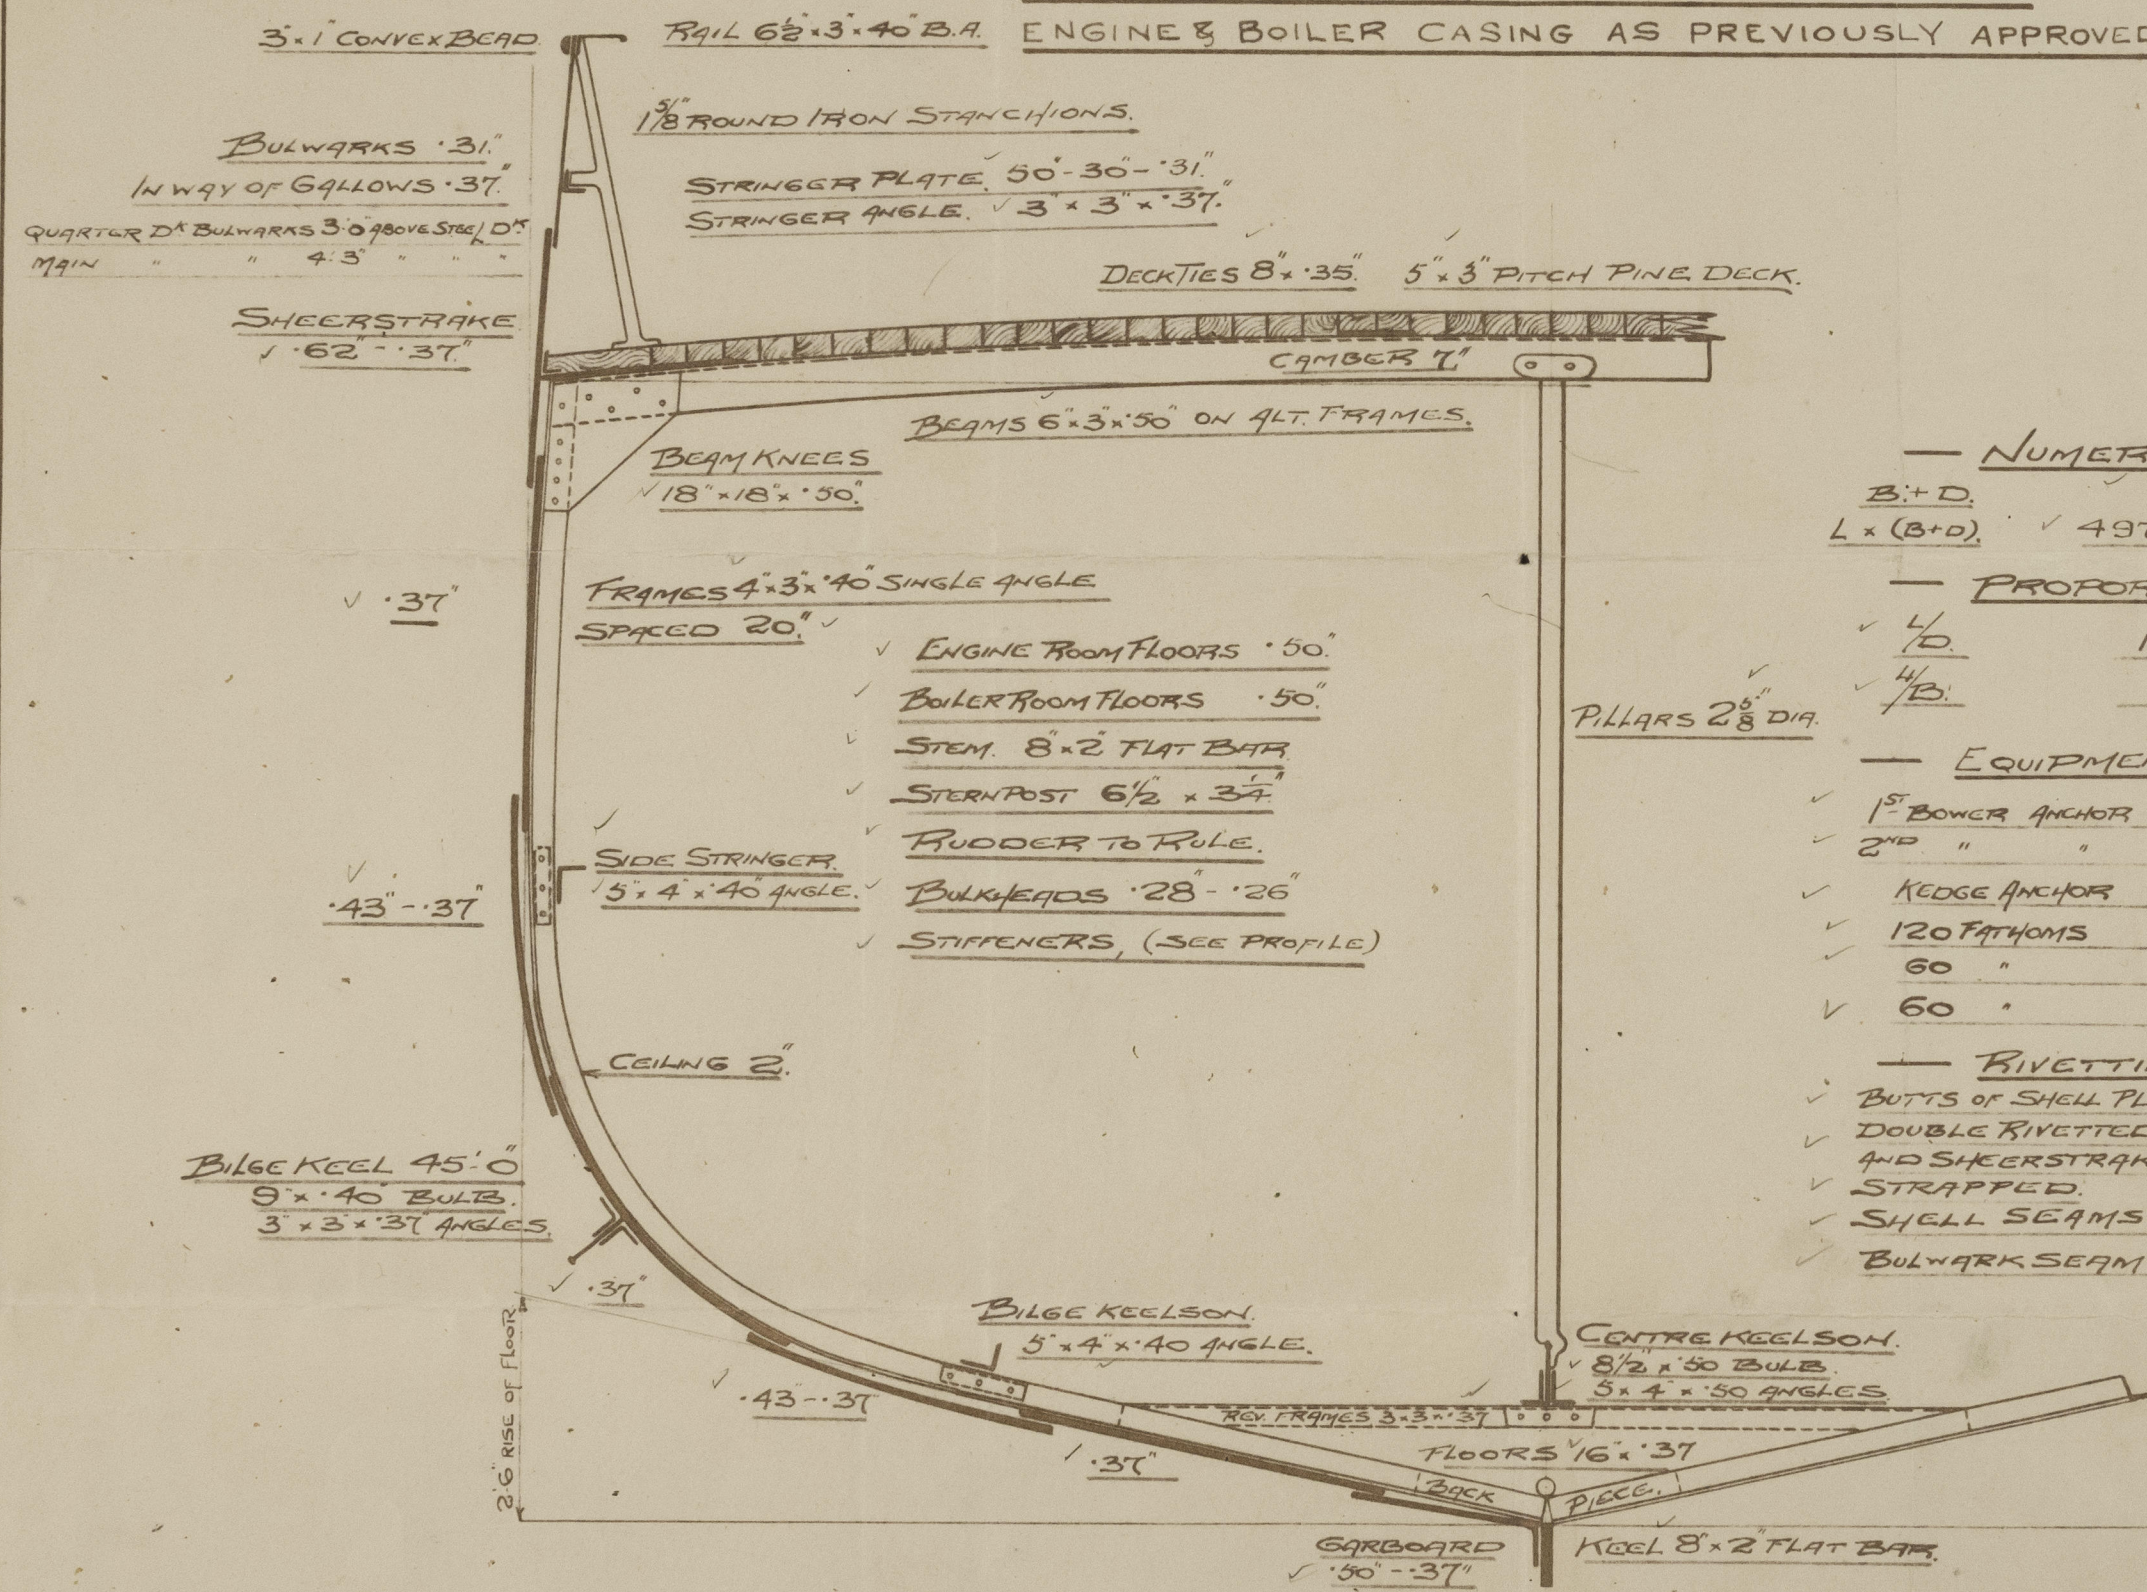

## NUMERALS.

B + D 36.37  
 L x (B + D) 4970.32

## PROPORTIONS.

L/D 10.51  
 H/D 5.84

## EQUIPMENT.

- 1st BOW ANCHOR 6 CWTs EX STOCK OR 7 1/2 CWTs STOCKLESS
- 2nd " " 5 1/2 " " " " " " " "
- KEEDGE ANCHOR 3 " " " "
- 120 FATHOMS 1 3/16" STUD LINK CABLE.
- 60 " 6" HAWSER.
- 60 " 5" WARP.


## RIVETTING.

- BUTTS OF SHELL PLATING TO BE LAPPED AND DOUBLE RIVETTED EXCEPT GARBOARD AND SHEER STRAKE WHICH ARE TO BE STRAPPED.
- SHELL SEAMS DOUBLE RIVETTED.
- BULWARK SEAM SINGLE RIVETTED.

C.T.  
 3.5.15



Messrs. Crehame & Sons Ltd.  
Midship Section.  
J. J. No 650

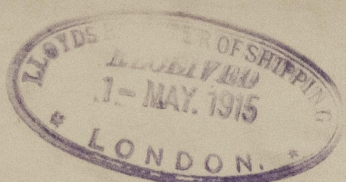

*A. St. Aubert 'Null Rpt no 29197'*



© 2020

Lloyd's Register  
Foundation

005618-005634-0050