
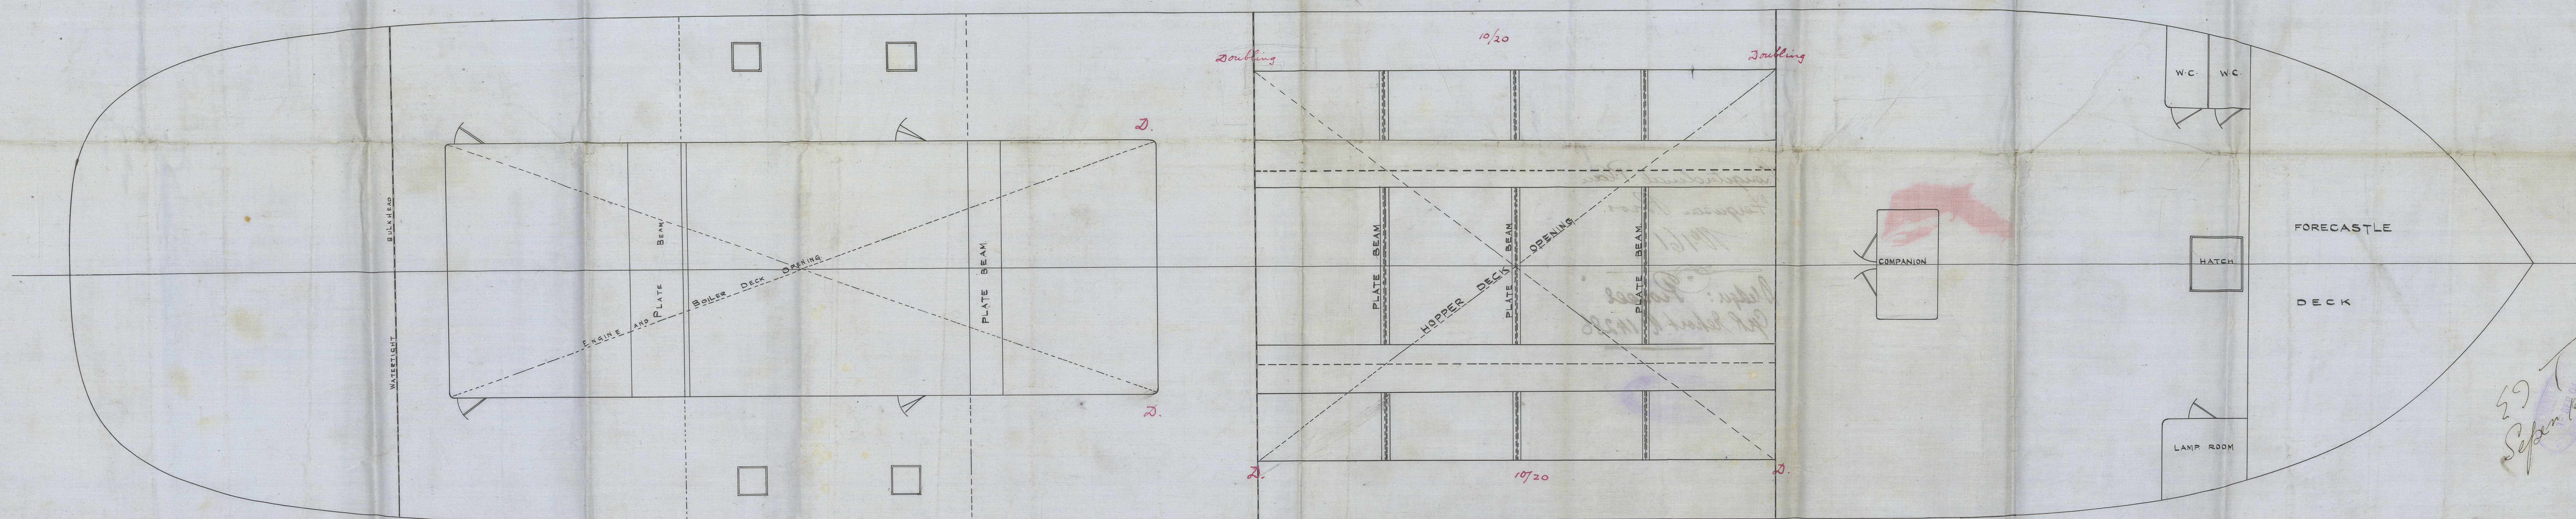


ELEVATION AND DECK PLAN
SAND PUMP HOPPER DREDGER
SCALE $\frac{1}{4}$ INCH = 1 FOOT
DIMENSIONS ~~183'-0"~~ x 37'-0" x 9'-6"
170'-0"

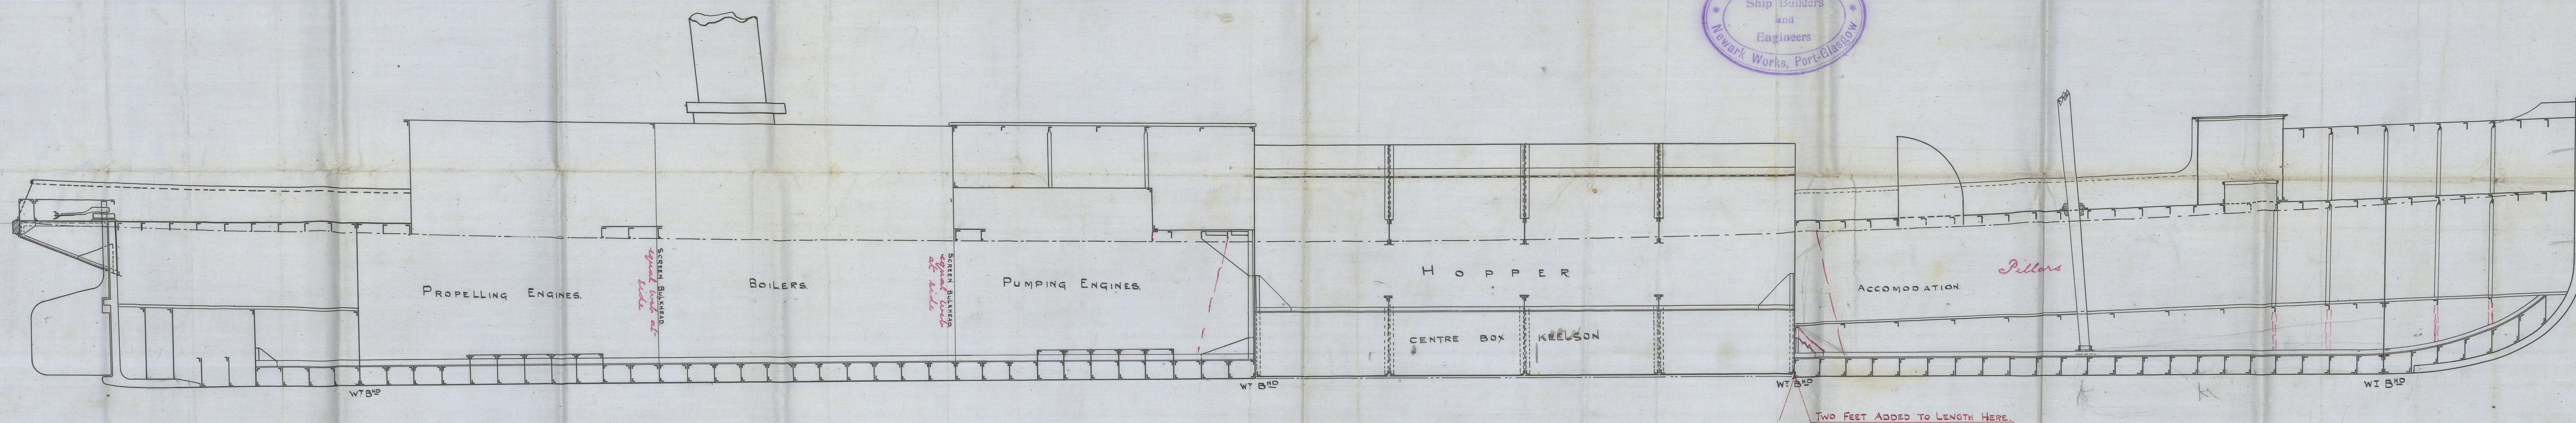

59 T
Sept 1901

Longitudinal Plan

Ferguson Bros.

No. 161

Sledge: Pioneer

Cut Report No. 14286

105701

005618-005634-0207



© 2020

Lloyd's Register
Foundation