
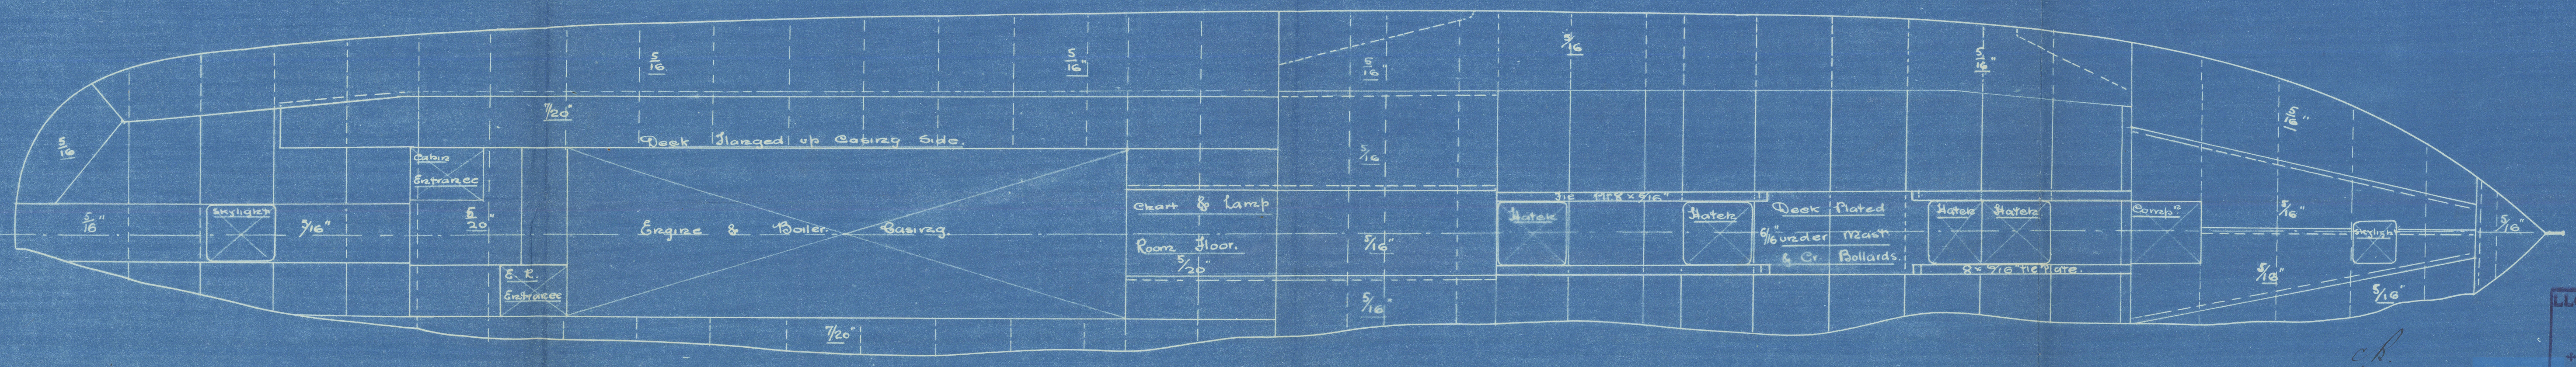


15.3.05

— PROFILE & DECK PLAN —  
— STEEL SCREW TRAWLER —  
— NO 345 —  
— DIM- 115'-0" B.P. x 21'-6" x 12'-6" MLD. —  
— SCALE 1/4" = 1 FOOT. —

OSCHMIDT & SONS  
MARINE ENGINEERS  
3395 14/3/05  
Approved

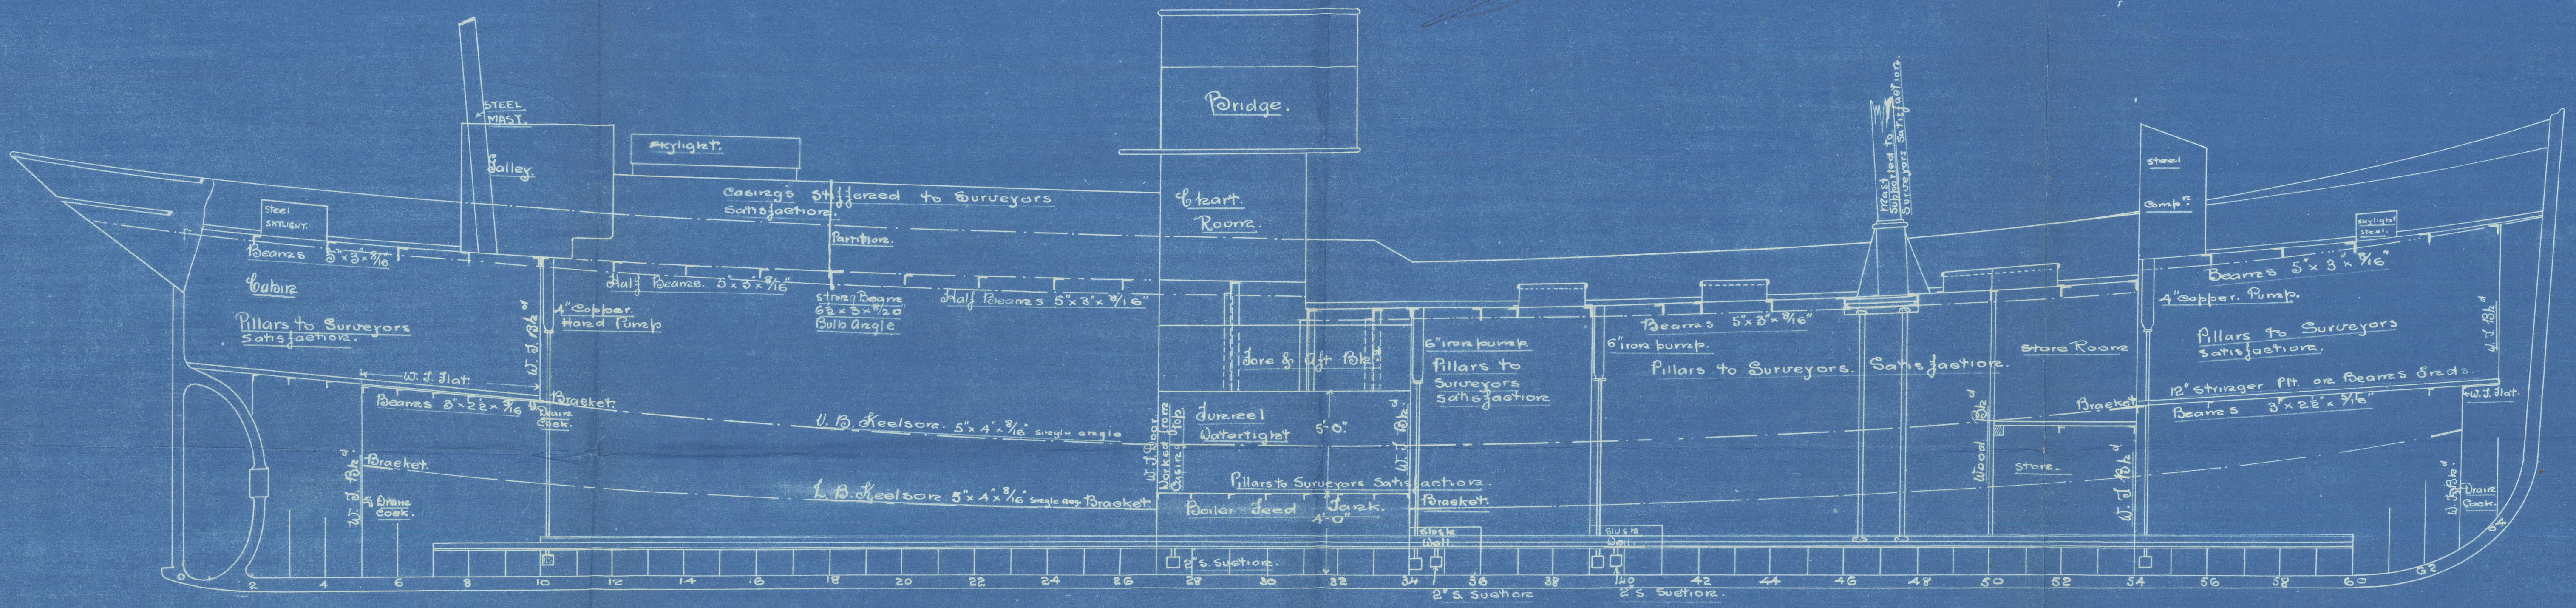

LLOYD'S REGISTER  
OF SHIPPING.  
11 MAR 1905  
+ HULL +


Lloyd's Register  
Foundation




Cochrane & Sons

No. 345.

Profile + Deck Plan.

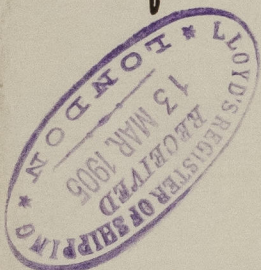

s/s President Skinner  
Hull Report No 17210

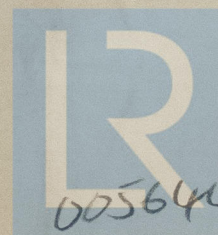

© 2020

Lloyd's Register  
Foundation

005644-005655-0001



Profile & Deck Plan No 345

00 5644-005655-0001




© 2020

Lloyd's Register  
Foundation



Profile & Deck Plan No 345

005644-005655-0001

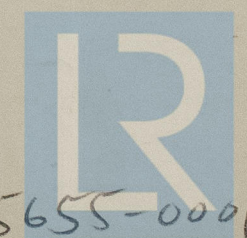

© 2020

Lloyd's Register  
Foundation