

N^{os} 475 - 6

Midship Section

Dimensions $15\frac{3}{4}'-0" \times 26'-0" \times 10'-9"$

15.3.10 To class AI at Lloyds, for coasting service

on the Bosphorus & Sea of Marmora

7.7.10. on the Bosphorus & Sea of
Scale $\frac{1}{2}$ inch = 1 foot.

Equipment.

- ✓ 2 Bower Anchors, 7 1/4 cwt ex stock or 9 cwt straps

- ✓ 1 Stream " 3 " "

- ✓ 1 Kedge " 14 " " "

- ✓ 163 fathoms 1" chain

- 45 " $\frac{11}{16}$ chain, or $2\frac{1}{4}$ steel wire

- ✓ 75 " 7½" hemp or 2½" " "

- 90 5½ hawser

Supplied
as per
specification

50 = 2 $\frac{1}{2}$ wr




120 - 8 1/2 hrs

120-4

approved

see London letter




data 7/7/10

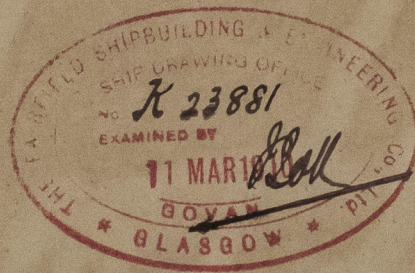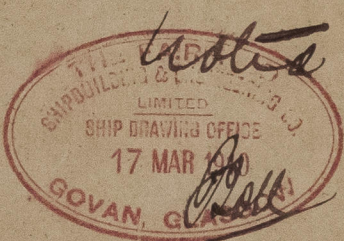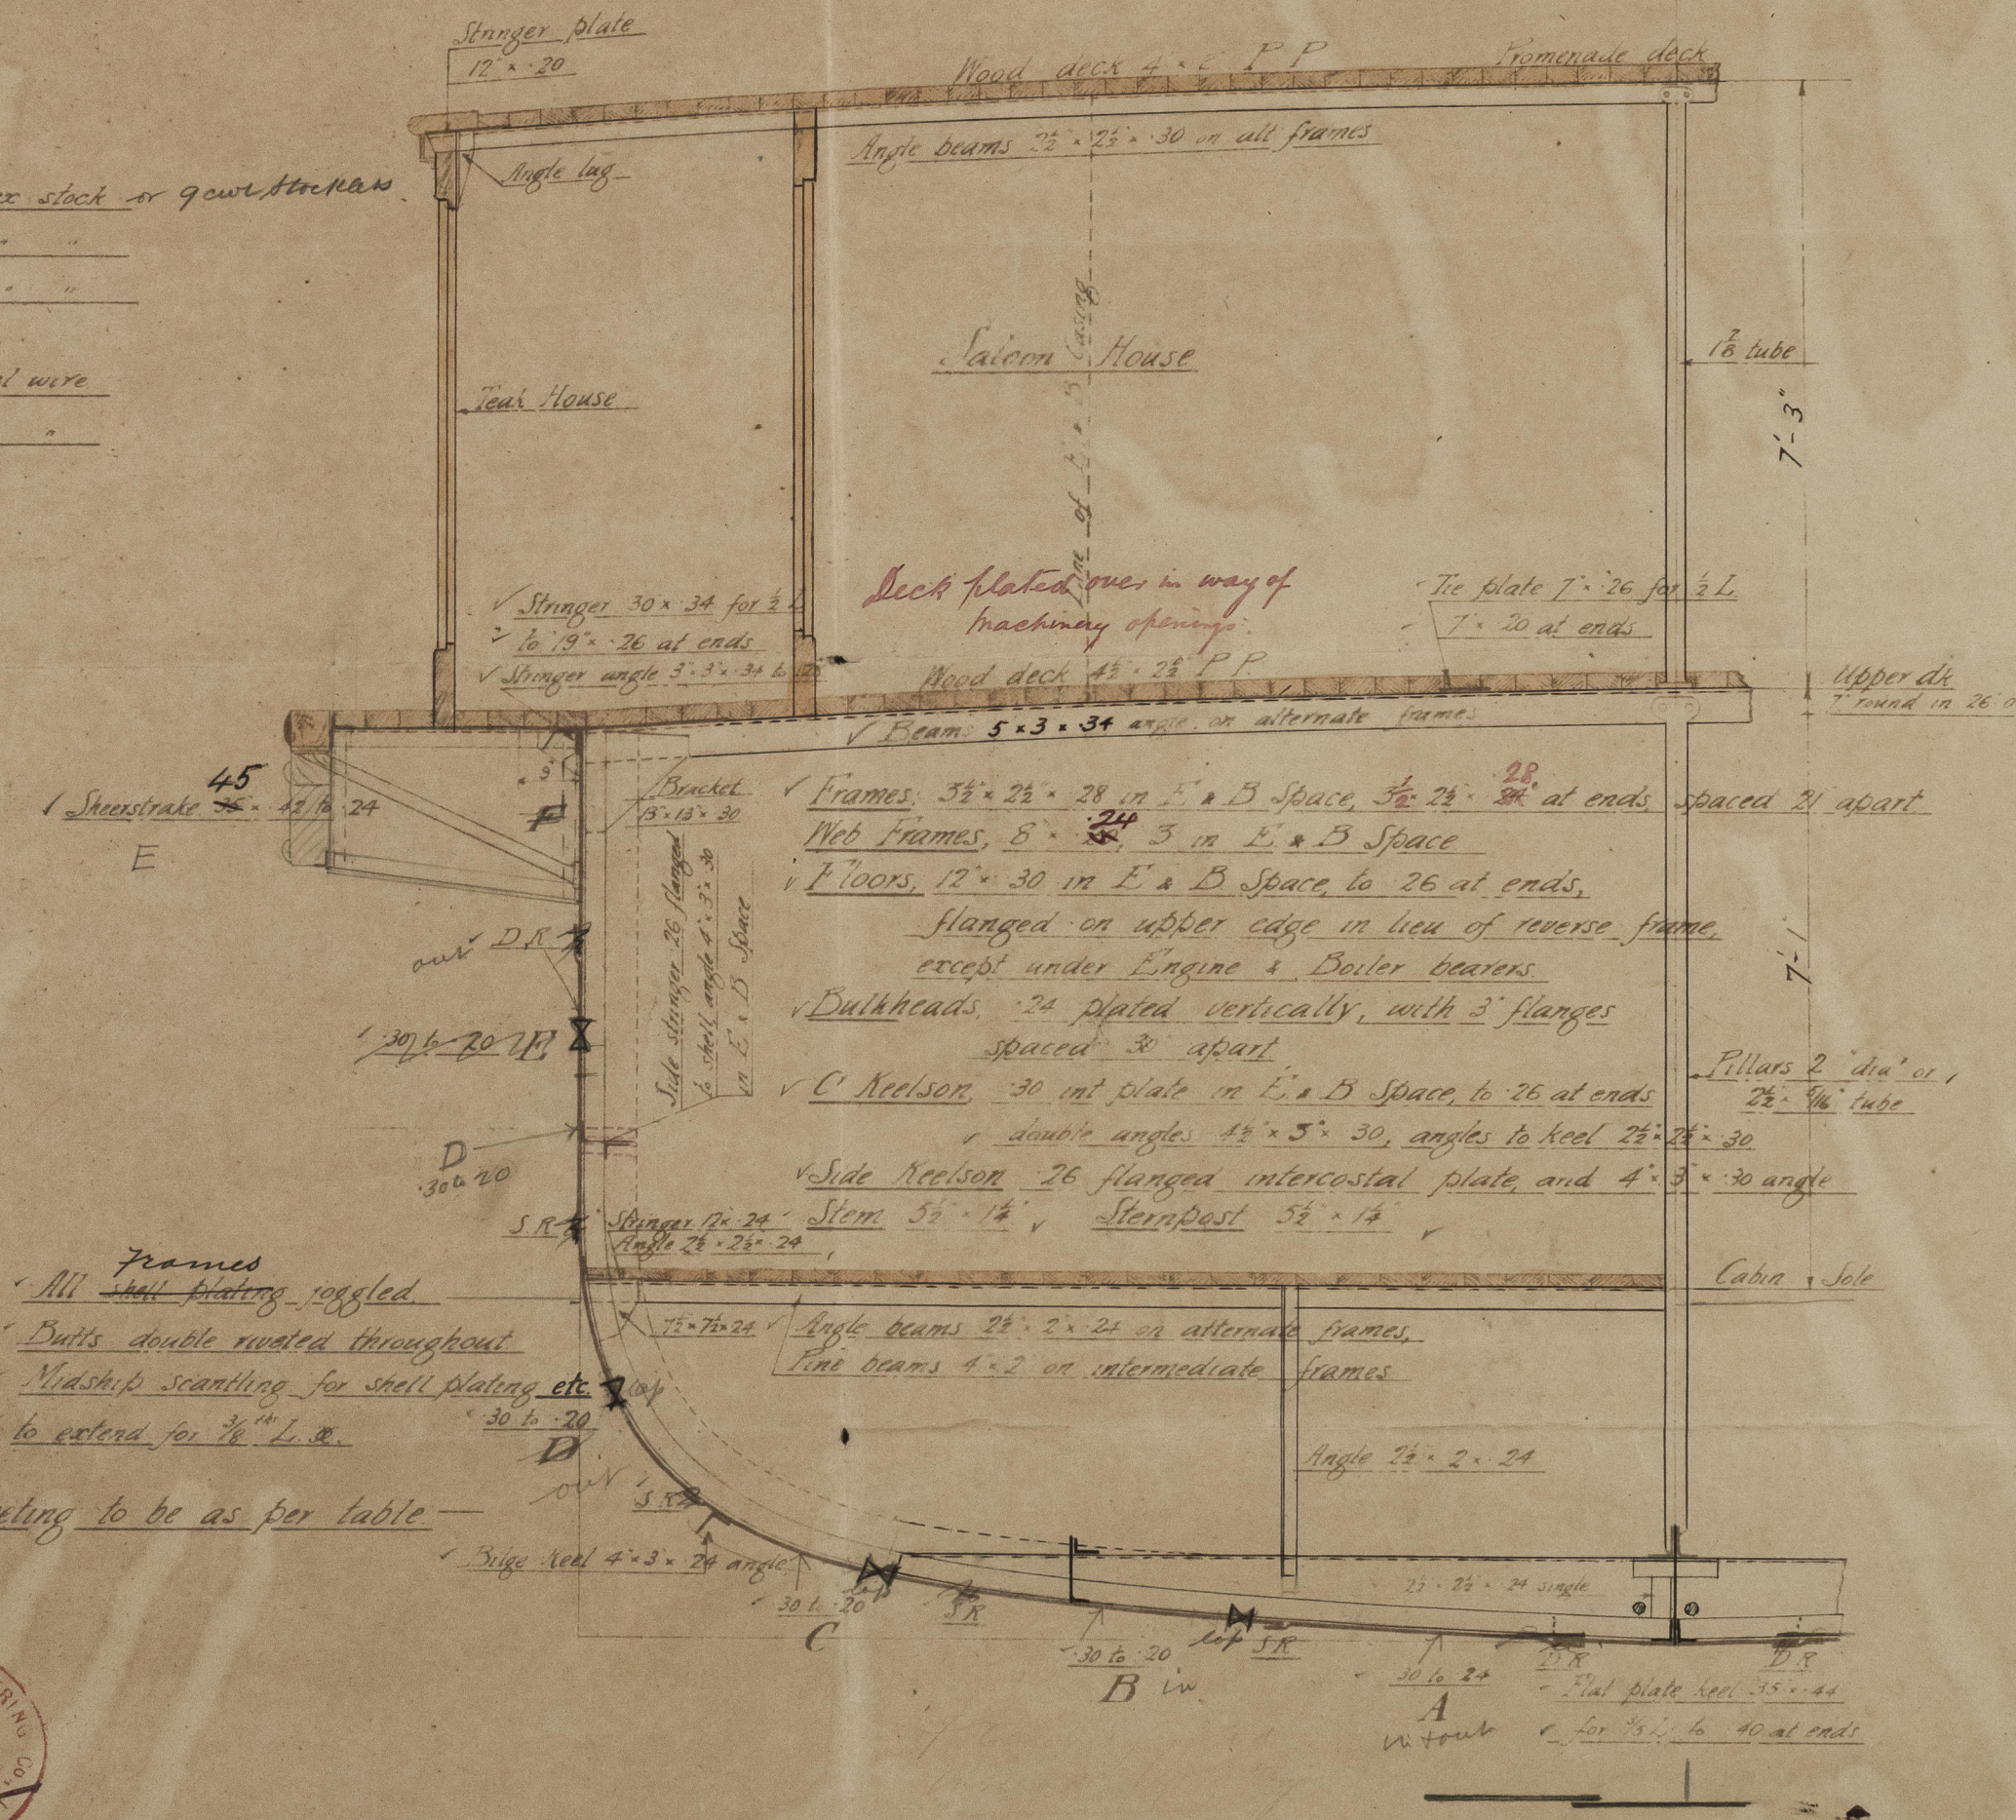

Fairfield S. B. & Co.

No 4754476

Midship Section

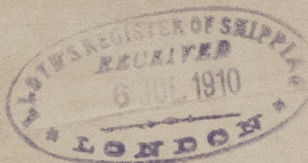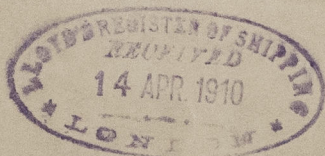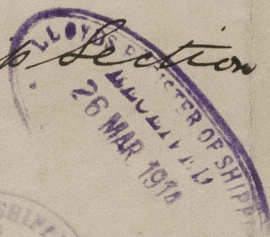

175: M. "Borjhorus 65"

GLASGOW REPORT No. 29167.



© 2021

Lloyd's Register
Foundation

005671-005683-0175