
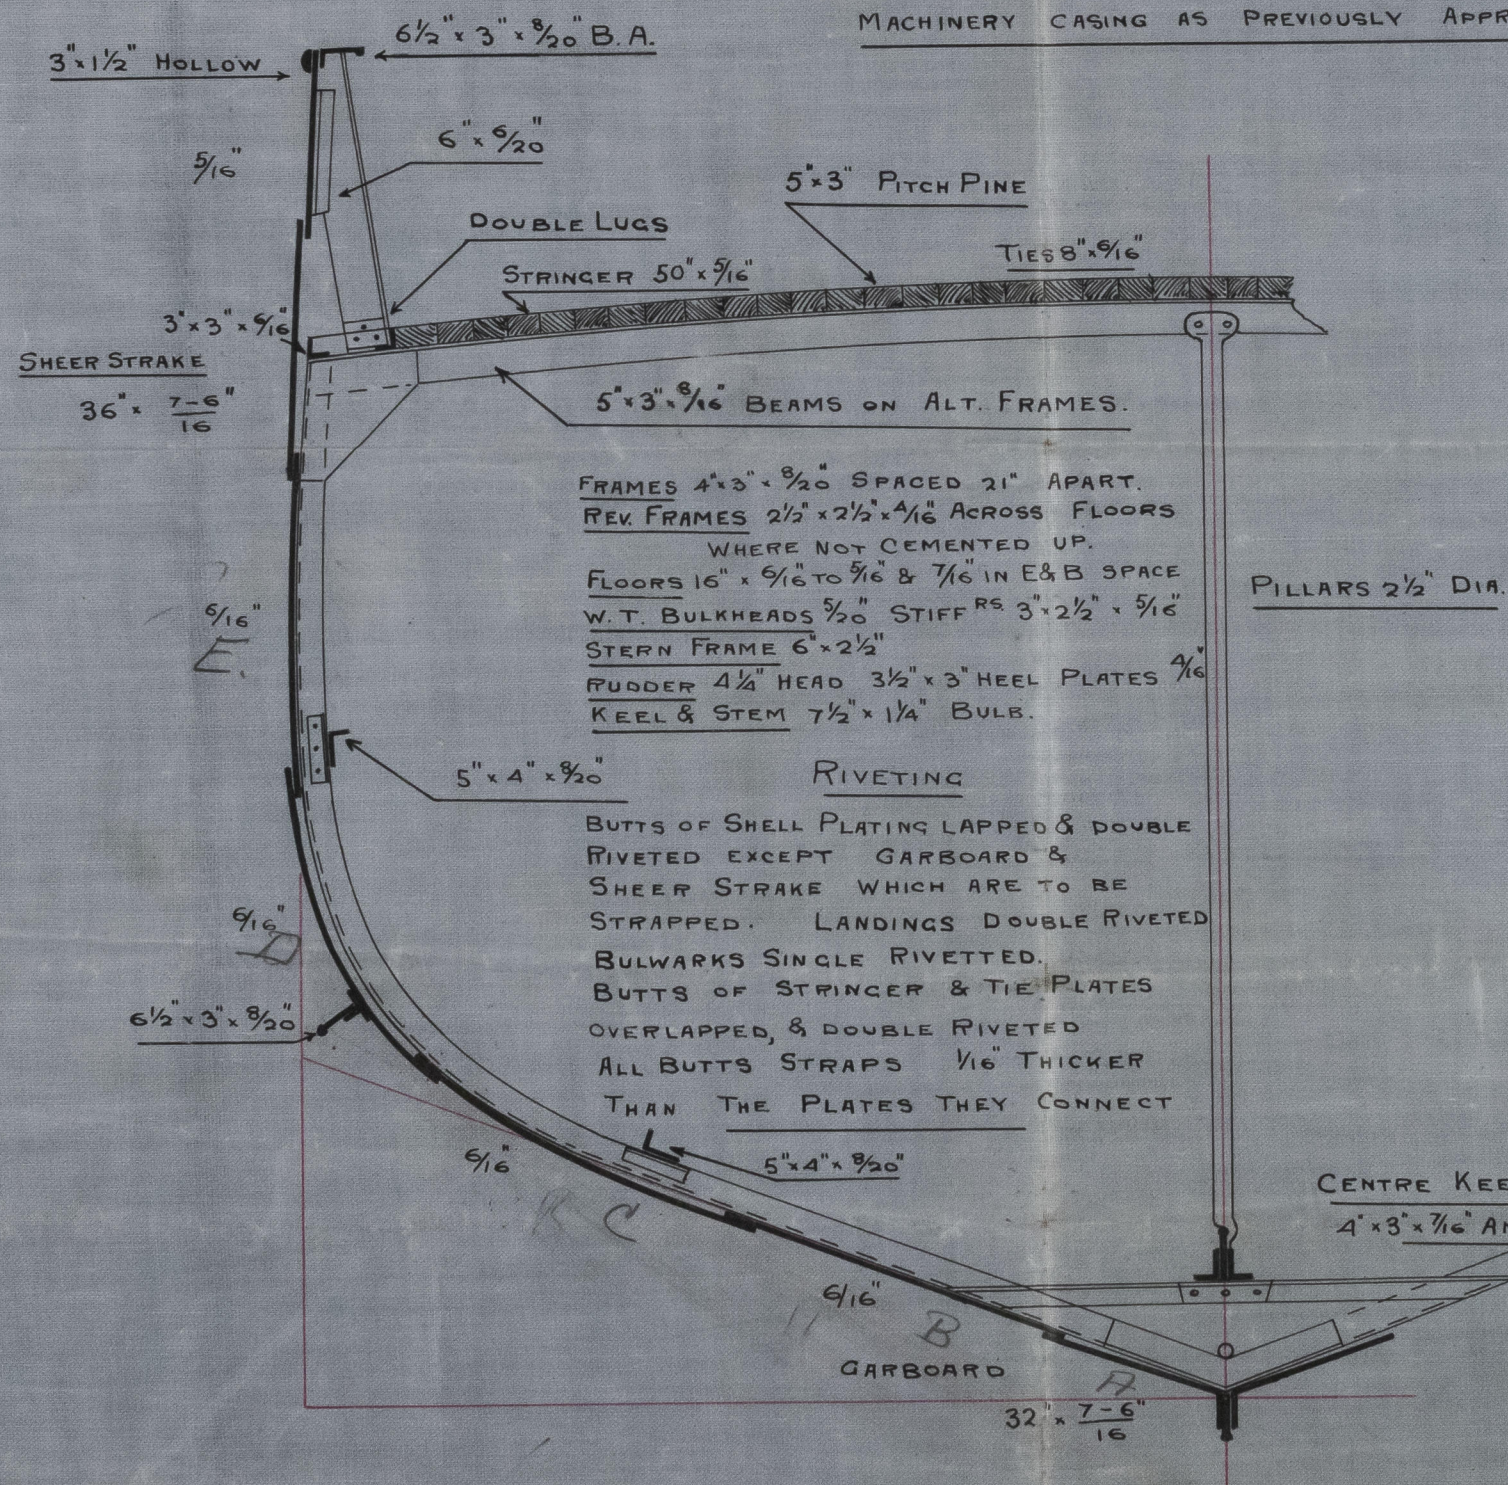


DECK PLATED OVER IN WAY OF MACHINERY SPACE
MACHINERY CASING AS PREVIOUSLY APPROVED.

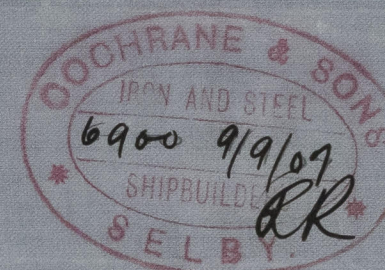

$\frac{1}{2}$	BREADTH	10 · 7	$\frac{L}{B}$ 4·85
$\frac{1}{2}$	GIRTH	18 · 58	
	DEPTH	12 · 43	$\frac{L}{D}$ 8·35
	1 ST NO.	41 · 71	
		103 · 87	
	2 ND NO.	4332 · 6	

1 ST	BOWER	ANCHOR	4½ CWT	EX STOCK
2 ND	"	"	4	" "
3 RD	"	"	2½	" "
75 FATHOMS		15/16"	SHORT LINK CABLE	
60	"	5½"	HAWSER	
60	"	3½"	WARD.	

CENTRE KEELSON $7\frac{1}{2}" \times 7\frac{1}{16}"$ BULB
 $4" \times 3" \times 7\frac{1}{16}"$ ANGLES.

answ

0056915 - 005708-0001

Cochrane & Sons

Nos 417, 418, 419, & 420

amended

Midship Section.

3/5 Bellerophon Hull Rpt No. 19590

" Bellona

" Boreas

" Bucentaur

" " "

" " "

" " "

over



© 2021

Lloyd's Register
Foundation

005695-005703-0001