

18.4.07.



# PROFILE AND DECK PLAN

STEEL SCREW TRAWLER.

No 417-18-19 & 20

DIM: 105'-0" x 21'-6" x 11'-3" HOLO. 12'-0" MLO

SCALE 1/4" = ONE FOOT.

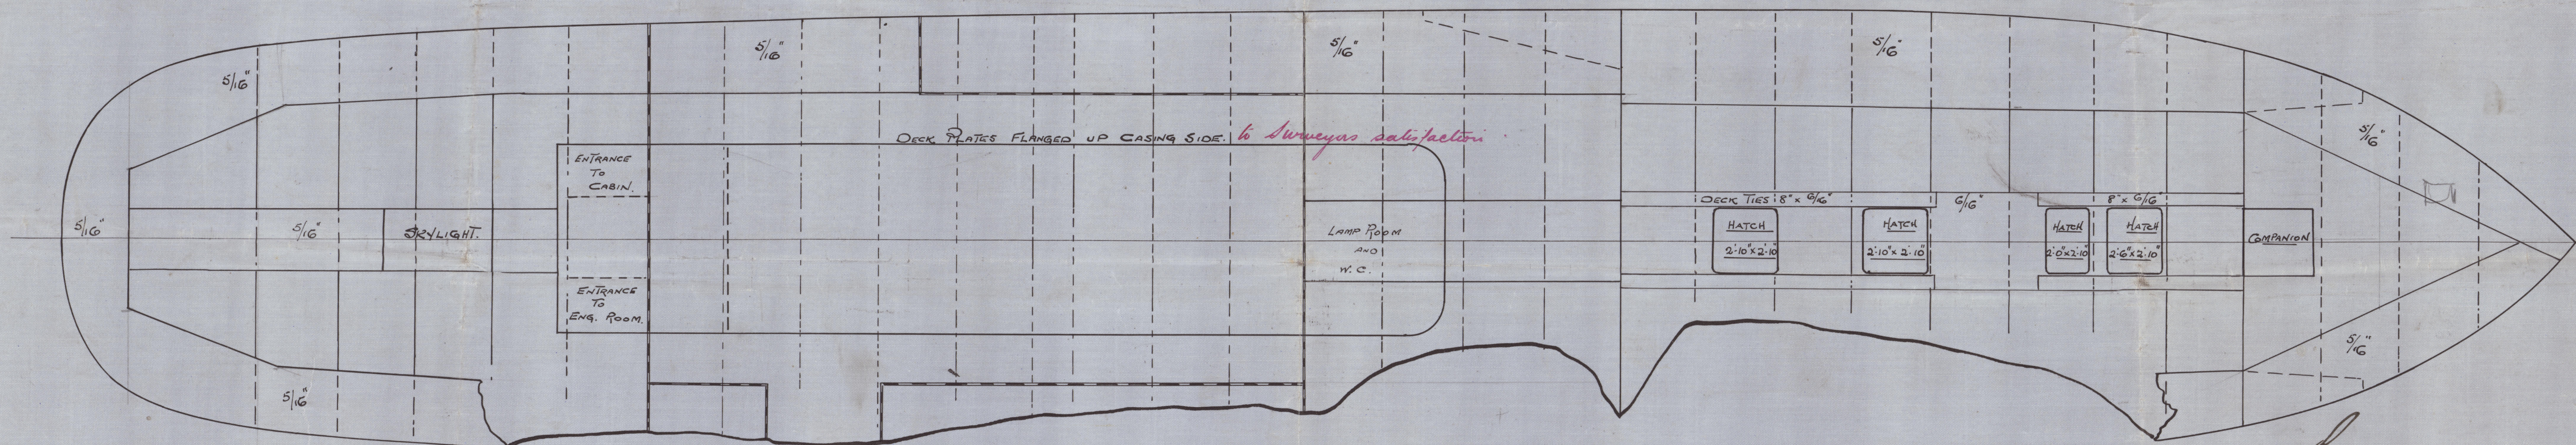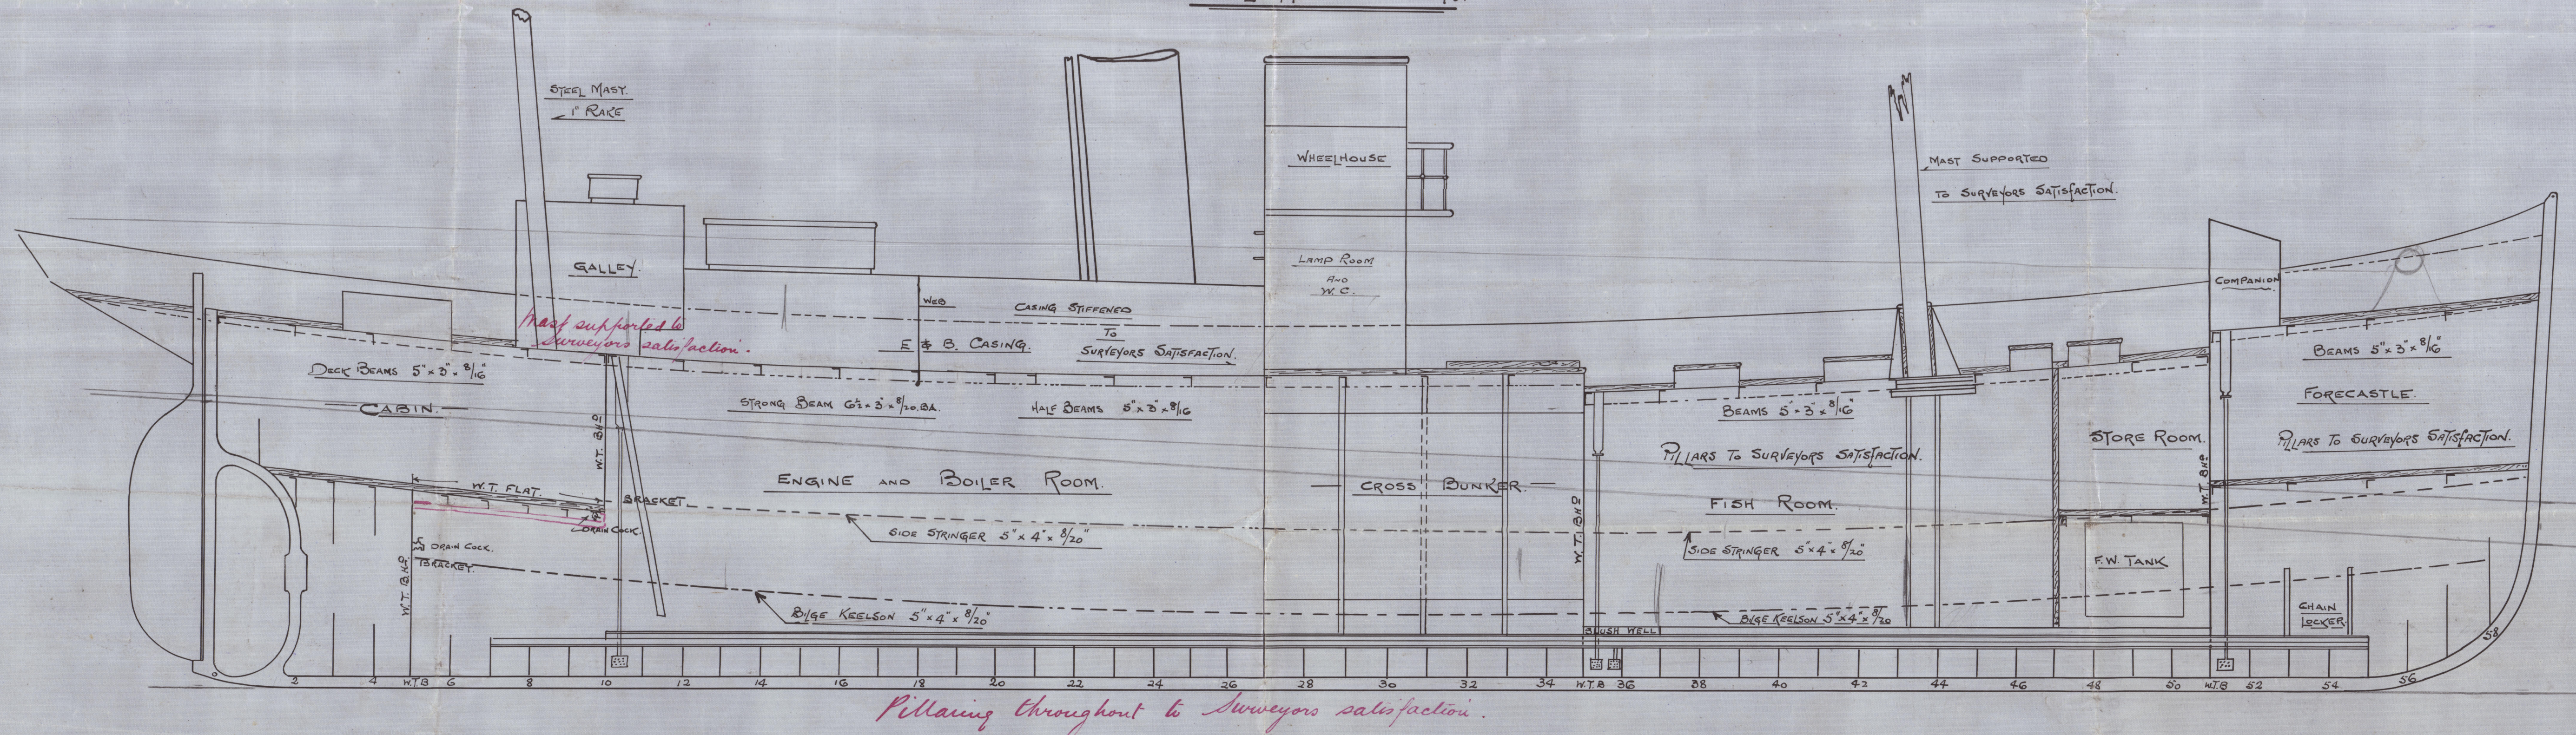

18.4.07.



- Profile -

Cochran & Sons  
Selby

Nos. 417. 418. 419 & 420

of Bellersophor Hull R.R. No. 19590

- Bellona . . .
- Boreas . . .
- Buelton . . .



© 2021

Lloyd's Register  
Foundation