

SINGLE SCREW MOTOR VESSEL

DIMENSIONS:- 120'0" B.P. x 24'0" x 8'6" MLO

MIDSHIP SECTION & PROFILE & DECKS

SCALES. $\frac{1}{2}" \times \frac{1}{4}" = 1'0"$

TO CLASS \star 100 A1. LLOYD'S.

L x D = 1020.

L/D = 14.13.

L x (B+D) = 3900

D = 8.5

MATERIAL FROM STOCK

EQUIPMENT NO = UNDER 4200. LETTER C.

2 BOWER ANCHORS. STOCKLESS. 1 OFF $6\frac{3}{4}$ CWTs. AND 1, $5\frac{3}{4}$ CWTs.



1 STREAM ANCHOR $1\frac{3}{4}$ CWTs. EX STOCK.

135 FATHOMS $\frac{1}{16}"$ STUD CHAIN CABLE

45 " $\frac{9}{16}"$ STREAM CHAIN

75 " 6" HEMP TOWLINE

90 " 4" HEMP HAWSER

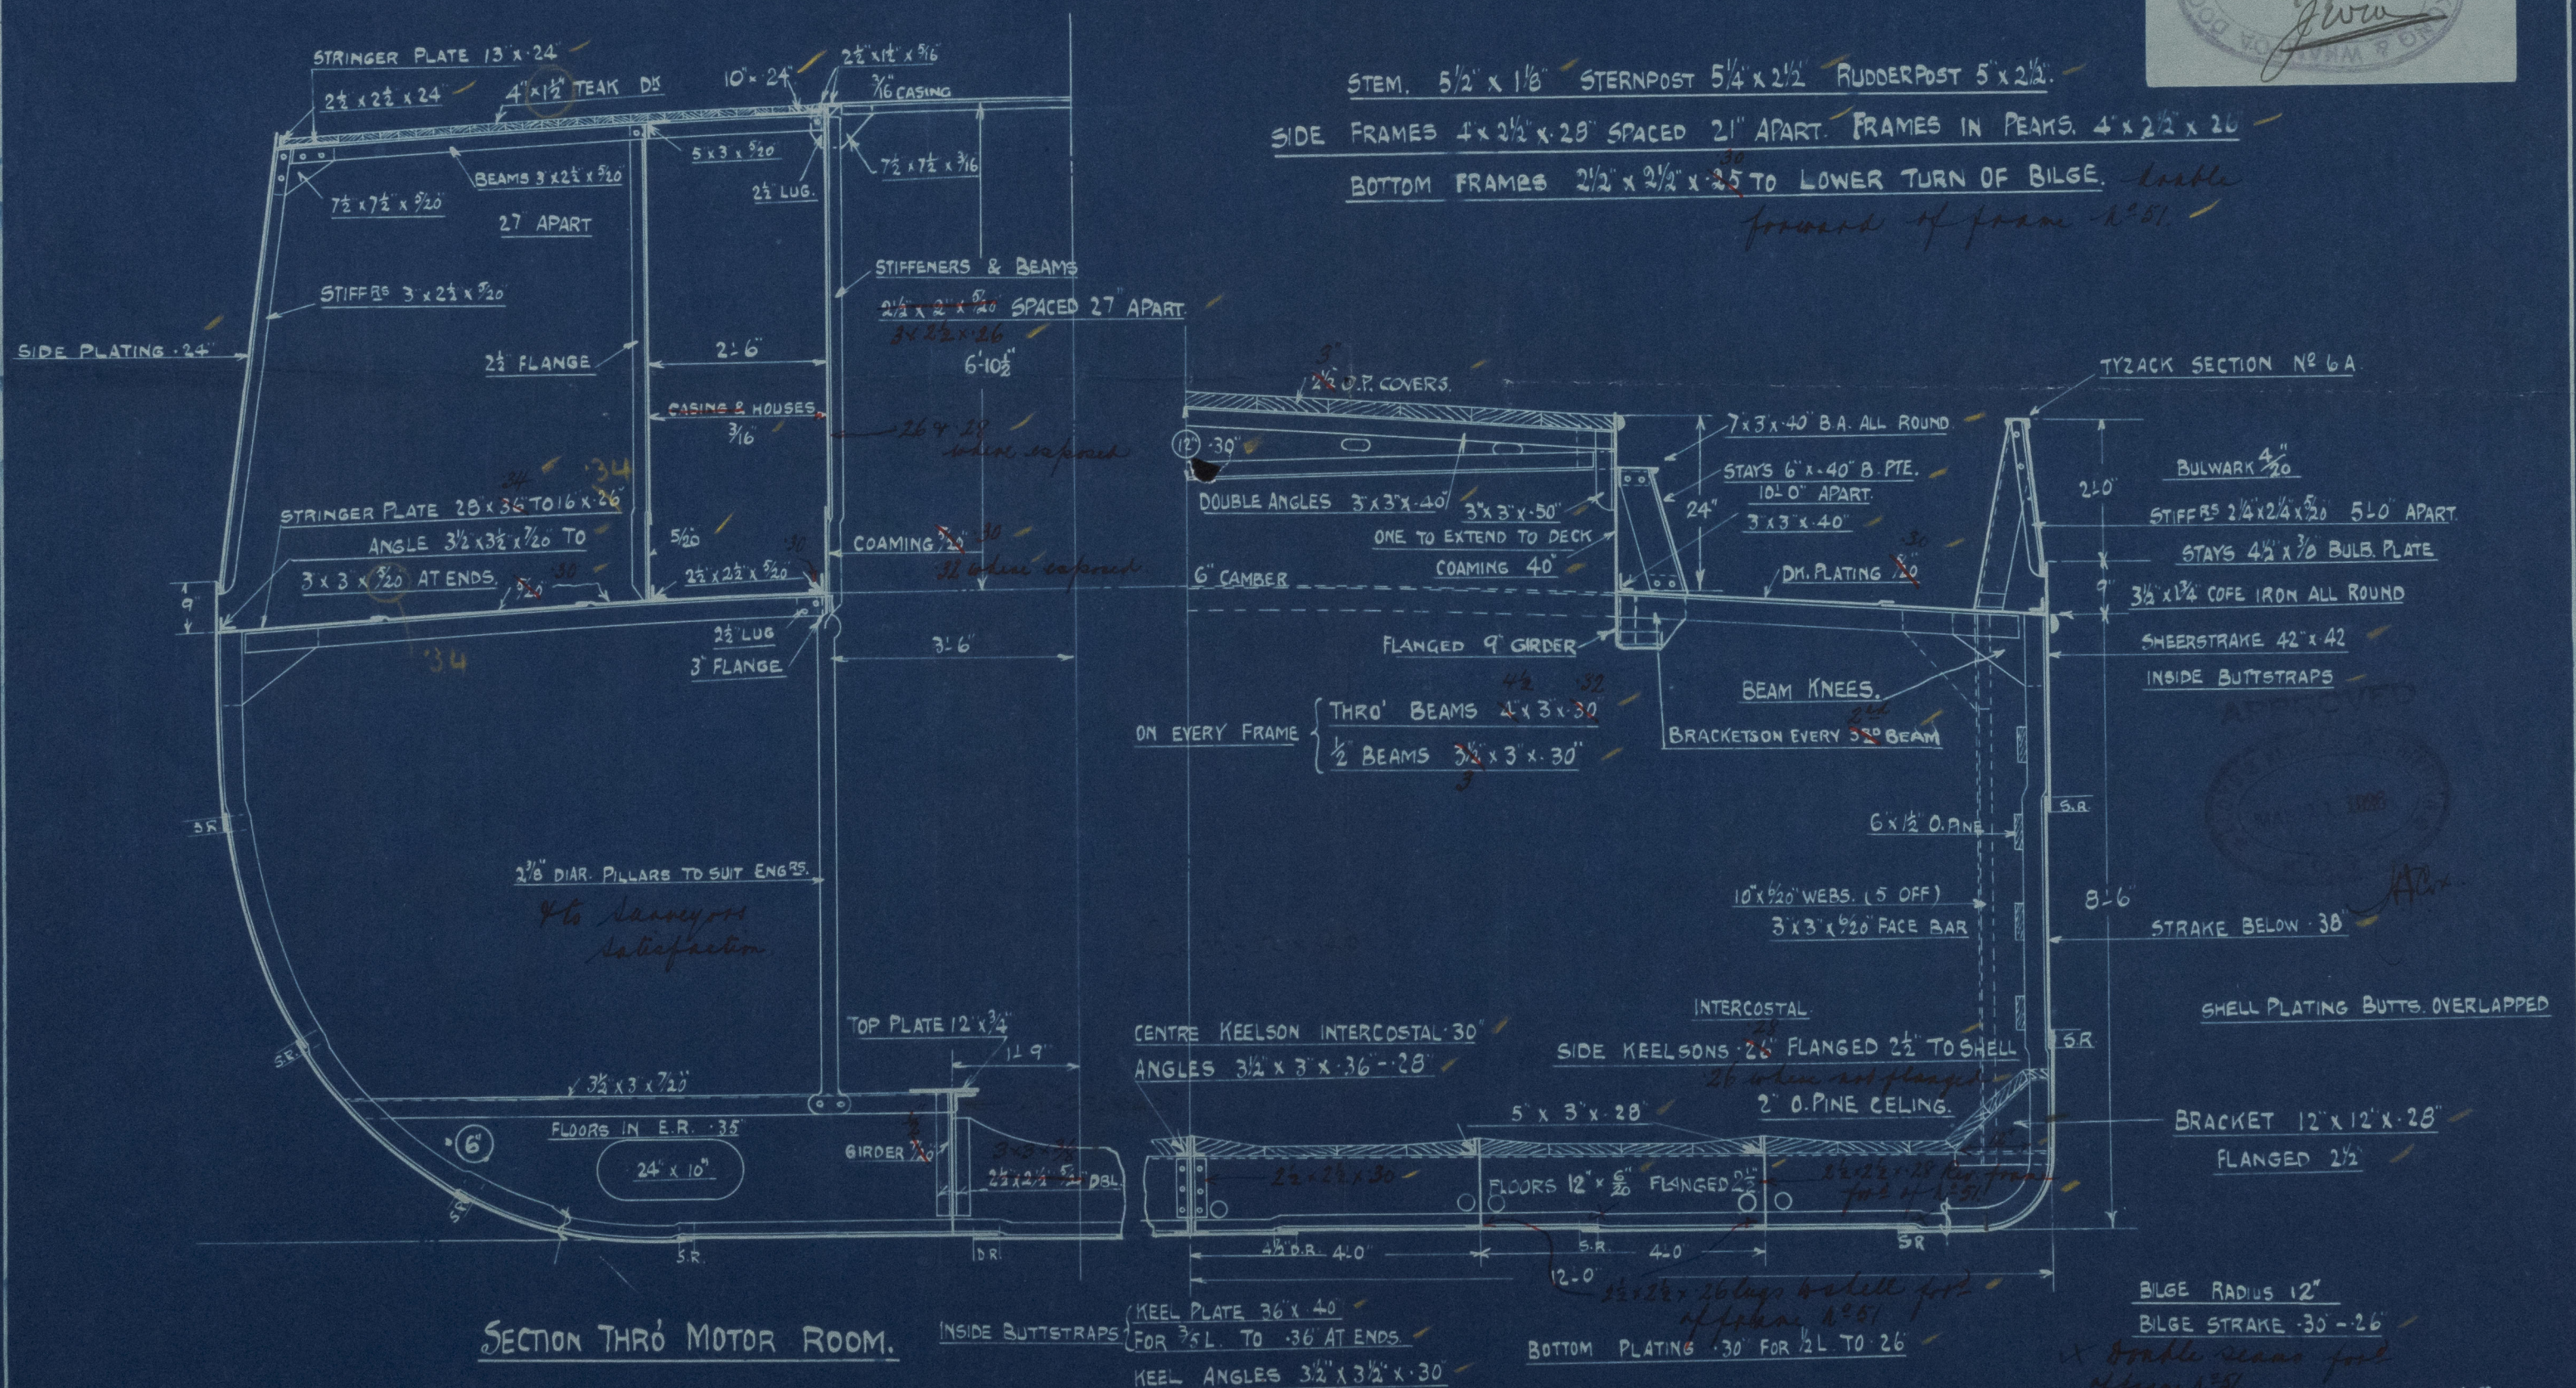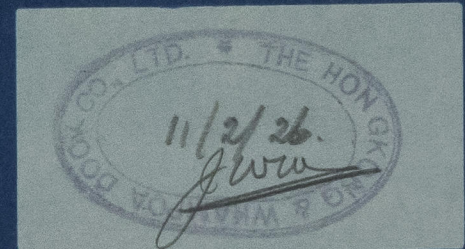

SECTION THRO' MOTOR ROOM.

INSIDE BUTTSTRAPS

KEEL PLATE $36" \times 40"$
FOR $\frac{3}{4}"$ L. TO $\frac{3}{4}"$ AT ENDS
KEEL ANGLES $3\frac{1}{2}" \times 3\frac{1}{2}" \times 30"$

BOTTOM PLATING $30"$ FOR $\frac{1}{2}"$ L. TO $26"$

BILGE RADIUS $12"$
BILGE STRAKE $30" \times 26"$

H.K. SWAMPSON & CO. LTD.
DRAWING NO. 10
226



Lloyd's Register
Foundation

Hong Kong + Shanghai D.K. Co.

120 ft.

Midship Section

GEN. BOX NO 884.

Mr. Aloha H.K. 6027.

62819

36) 110 4

32) 50 15
32
180
160
20

London

005695-005708-0016



© 2021

Lloyd's Register
Foundation