

-NUMERALS-
 BREADTH = 26.33
 DEPTH = 11.25
 B + D = 37.58
 L x (B + D) = 122 x 37.58 = 4584.76
 $\frac{L}{B} = 10.8$ $\frac{L}{D} = 4.6$

-N^o417-
 -MIDSHIP SECTION-
 -OF A- *Barge*

-STEAM GRAB HOPPER ~~DREDGER~~

-TO CLASS LLOYDS A.1.-
 -DIMENSIONS:- 122'-0" B.P. x 26'-6" EXT x 11'-3" MOULDED -
 -SCALE 1/2" = 1 FOOT.-

21 -EQUIPMENT-


| | | |
|-------------|--|-------------------------|
| ANCHORS | 5 3/4 CWT EX STOCK OR T/A.C. STOCKLESS | OWNERS REQUEST |
| 1 " | 2 1/4 " " " | |
| 1 " | 3/4 " " " | |
| 165 FATHOMS | 1 1/16 STUDLINK CABLE IN ONE LENGTH | |
| 45 " | 2 1/4 STEEL WIRE | OR 120 FMS OF 5/8 CHAIN |
| 75 " | 2 1/4 " " " | |
| 90 " | 15/8 " " " | OR 4" MANILLA |

Main Counsel: 16 Steel wire


PARTICULARS FOR FREEBOARD.

| | |
|------------------|------------|
| LENGTH APPROX | 122' |
| BREADTH | 26.5' |
| DEPTH | 10.56 |
| U.D. TONNAGE | 273 |
| SHEER AT STEM | 3'-8 1/4" |
| " 1/8 FROM STEM | 1'-10" |
| " AT STERN | 1'-10 1/4" |
| " 1/8 FROM STERN | 1'-0" |

-SECTION IN WAY OF HOPPER-

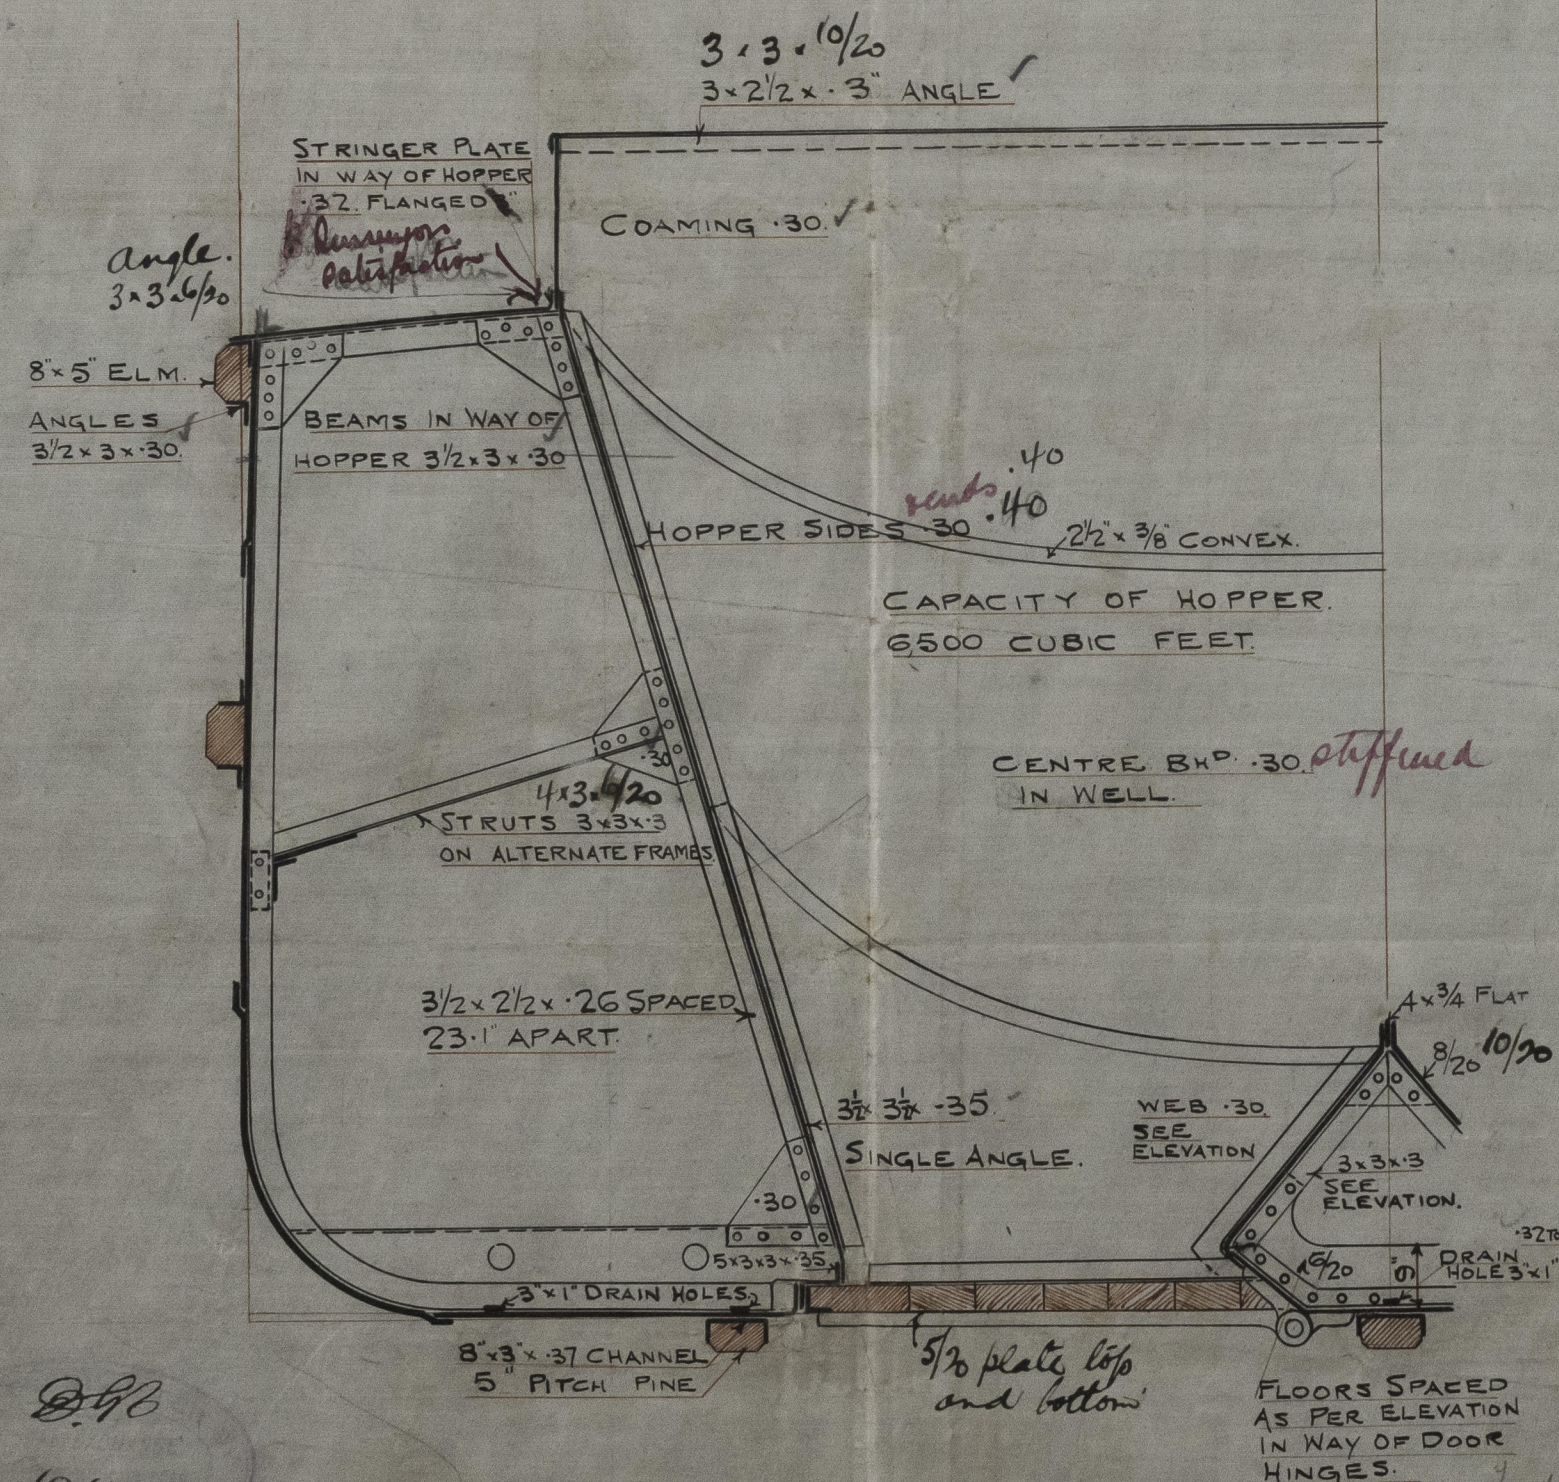

-SECTION CLEAR OF HOPPER-

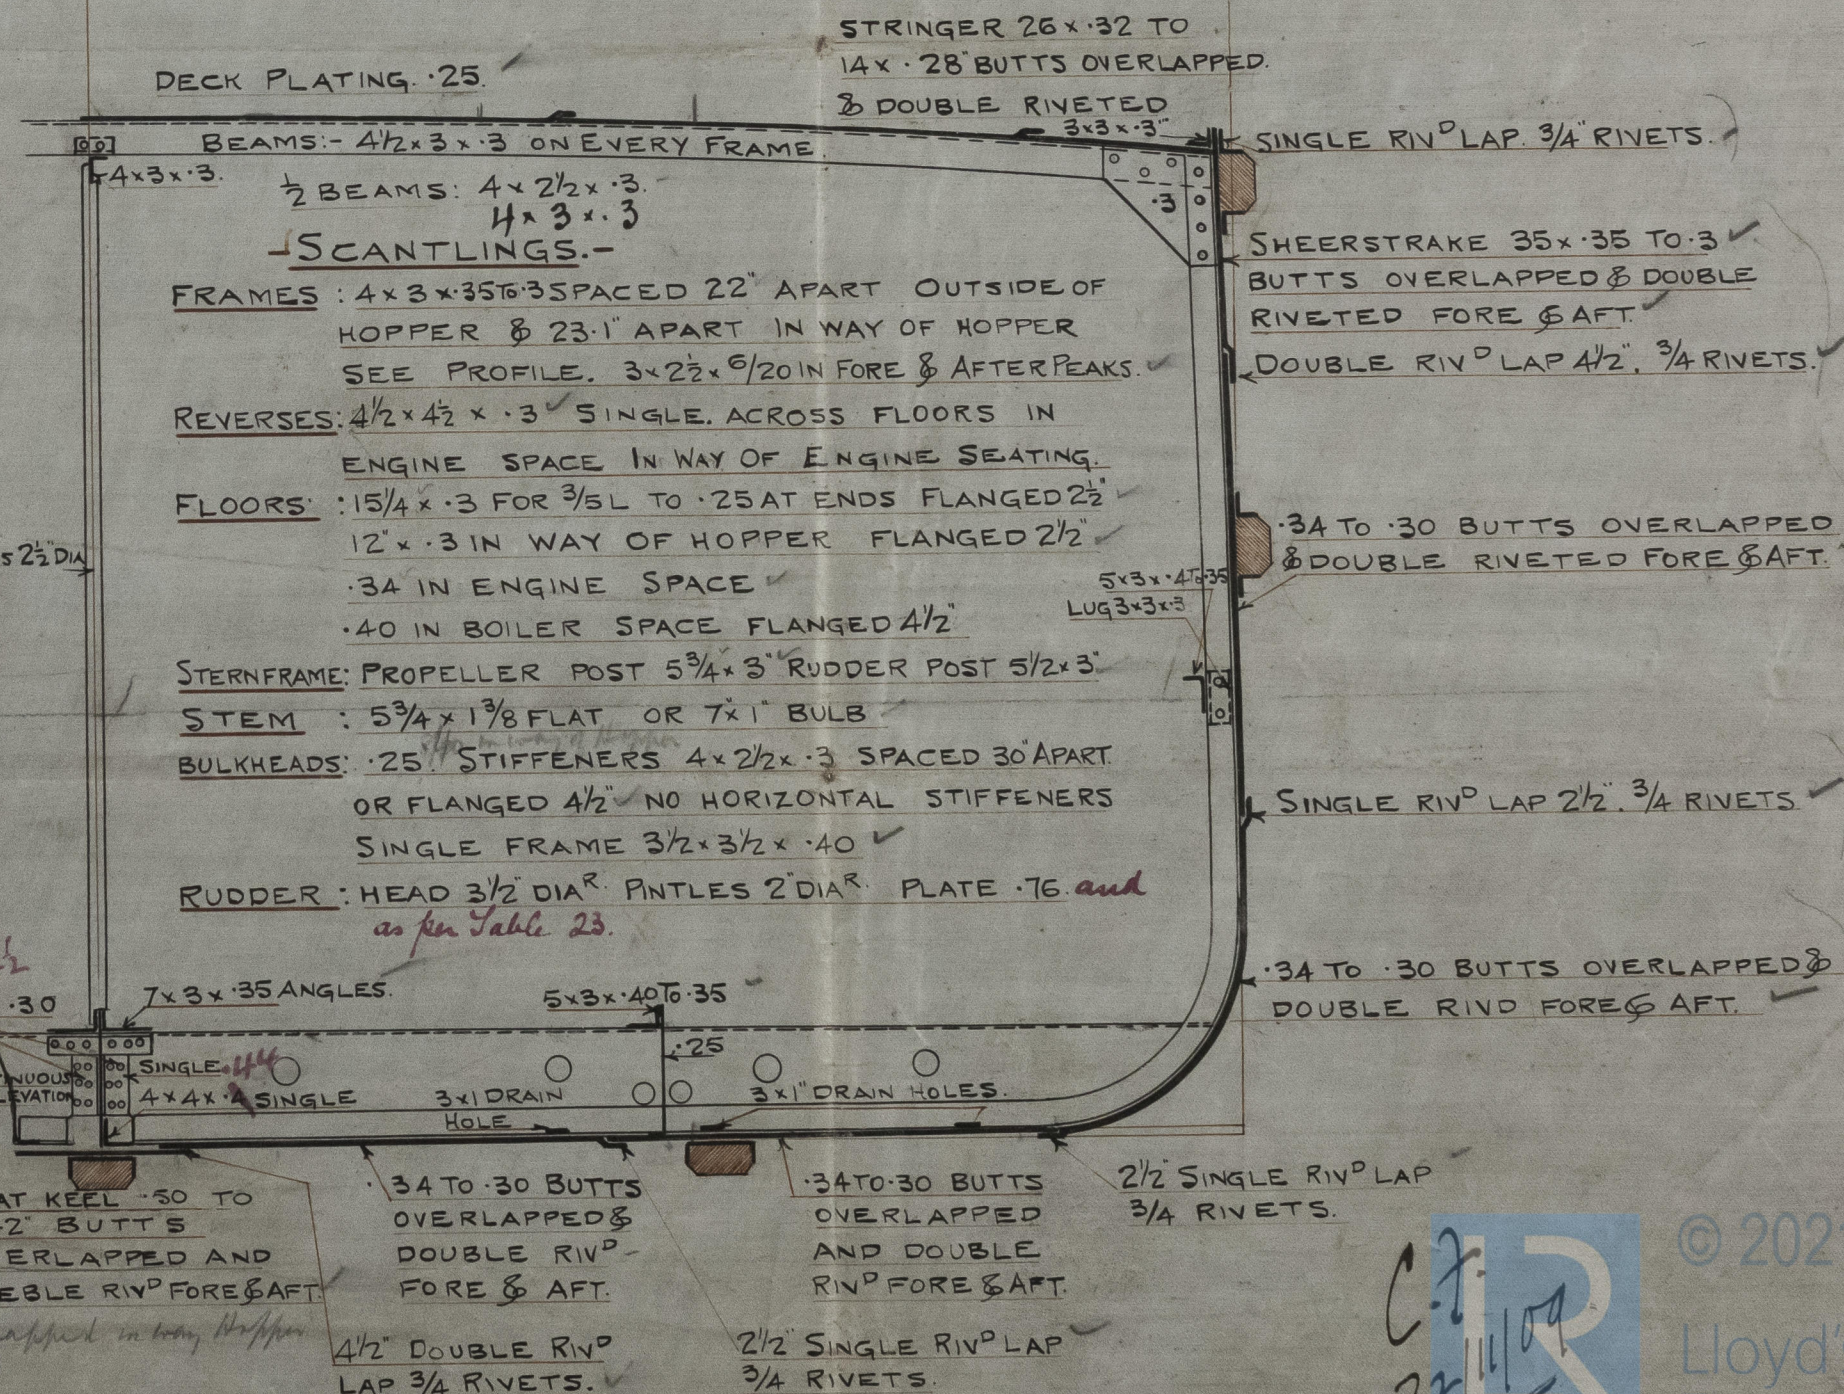

Smith's Dock Co.
 No 417 Barge
 Steam Grab Hopper Hoist
 Mid. Lee
 Priestman
 Lub Report 6207


005695-005708-0194

 MIDSHIP SECTION

005708-005710-0194

