

22.11.09  
18.12.09  
4.1.10



N<sup>o</sup> 417

PROFILE & DECK PLAN

TO CLASS. LLOYDS A.1. FOR STEAM GRAB HOPPER *Barge*

DIMENSIONS: 122-08 BY 26-65 FT X 11' 3 MLD

SCALE 1/4 INCH.

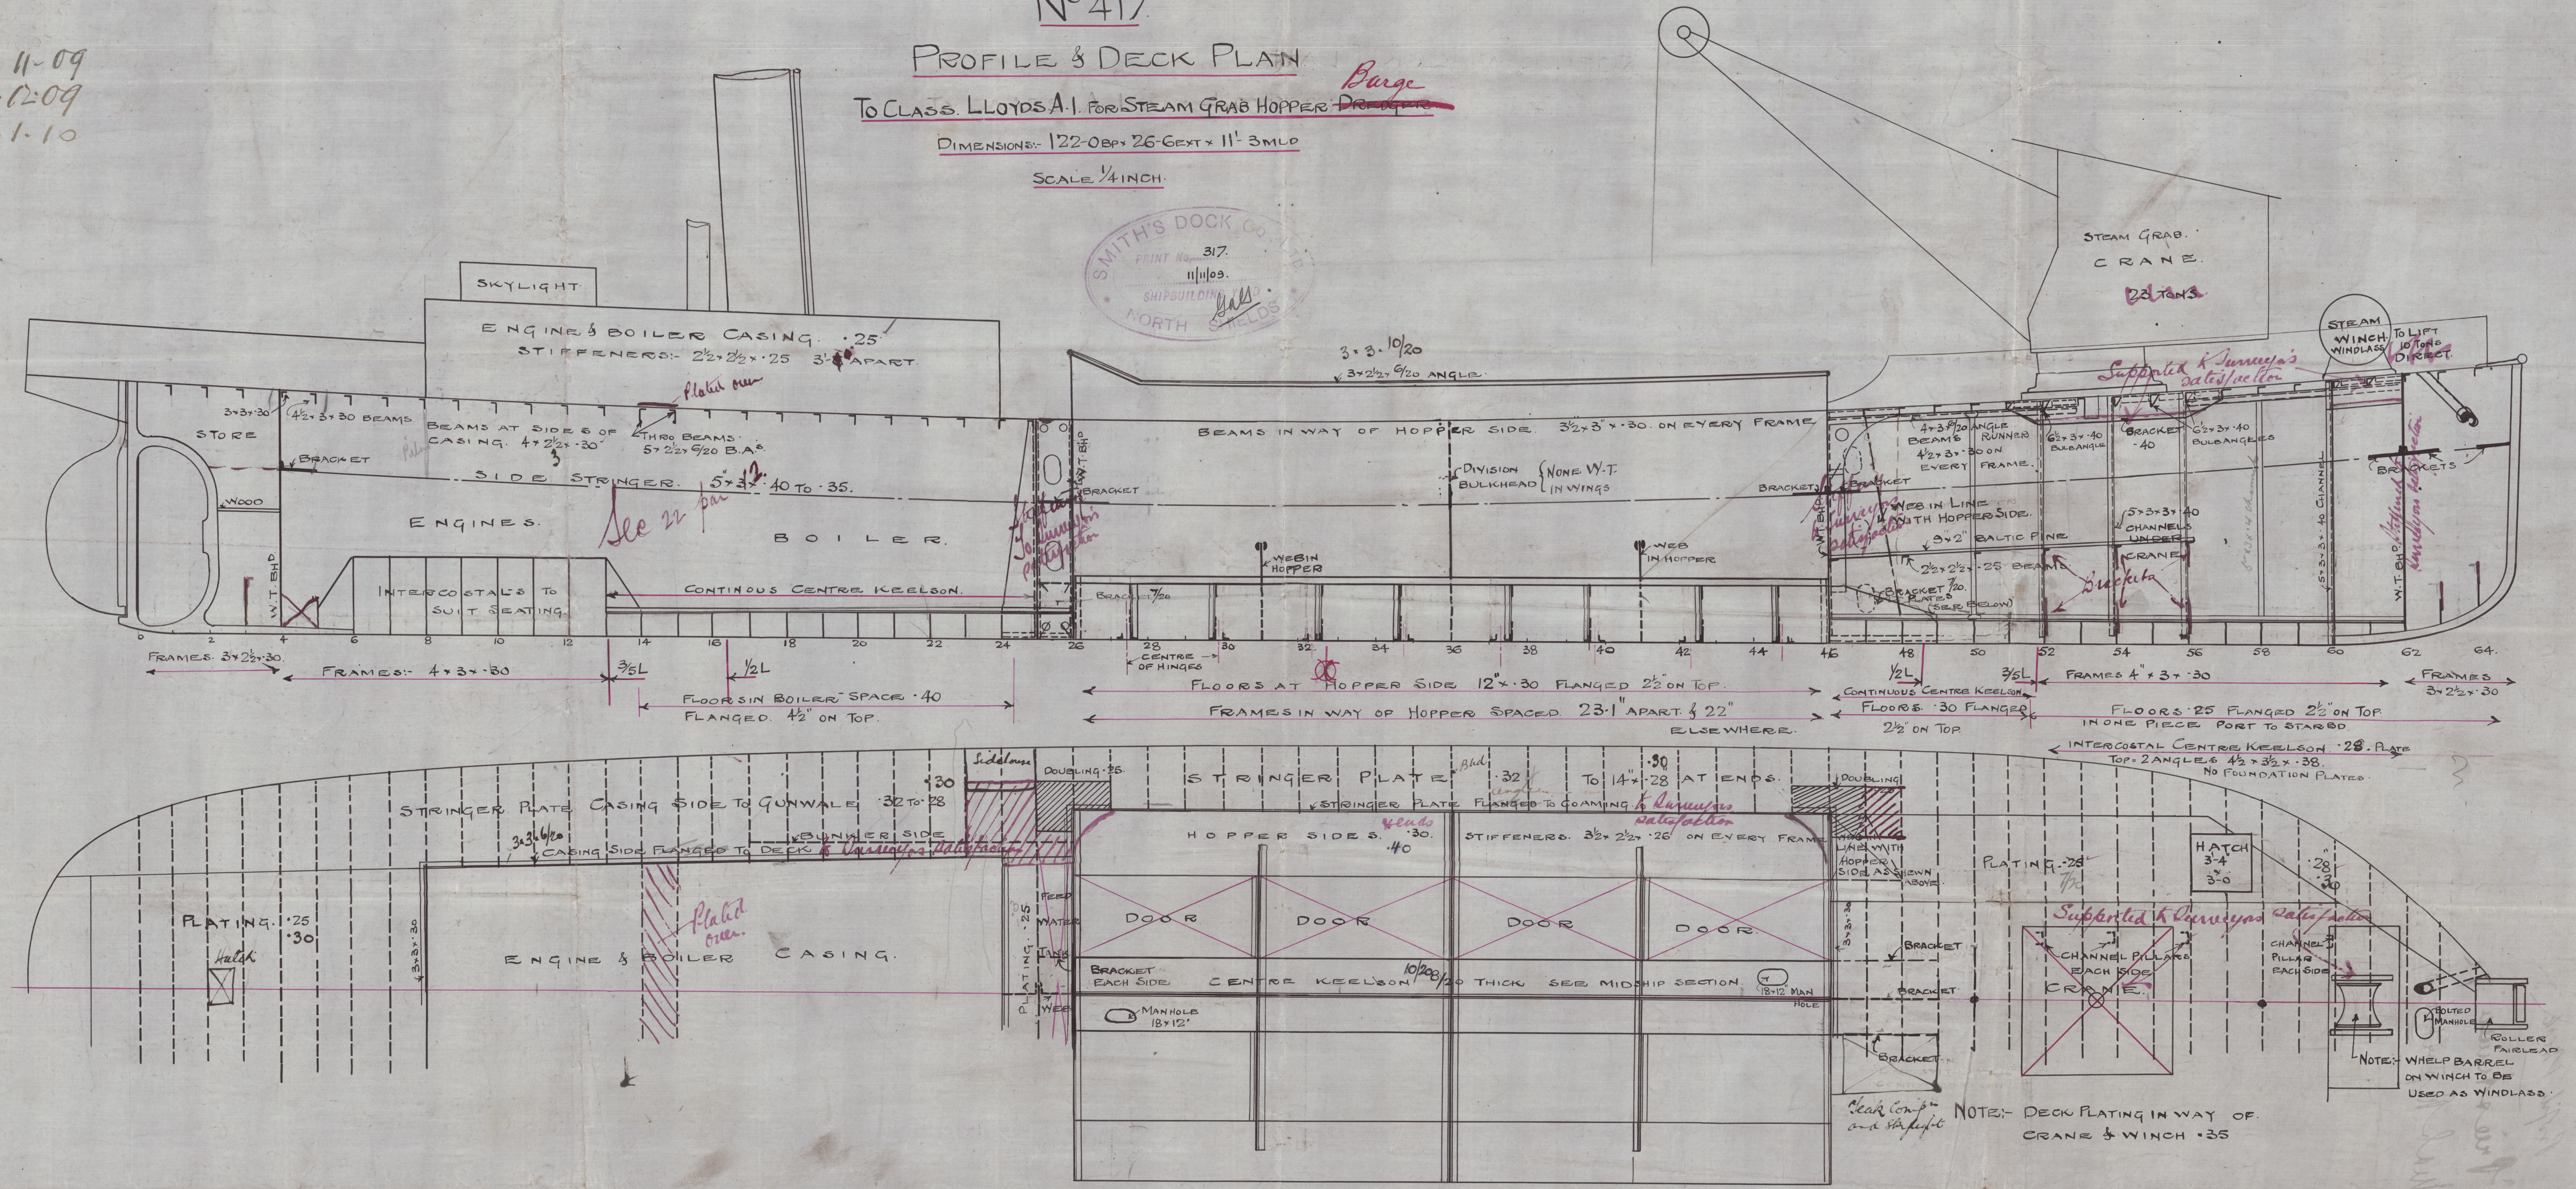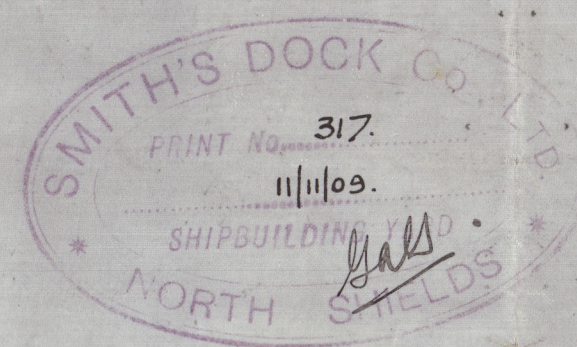

C.T.  
22/11/09

19.11.09

01-5  
5-1  
E-11

Smith's Dock Co.



Priestman

Lab. Report 6207



© 2021

Lloyd's Register  
Foundation

005675

005708