

LODGE REGISTER OF
BUILDINGS
1910

9-4-10



PROPOSED AMENDED CONNECTIONS

AT CENTRE KEELSON

T.S.S. N° 235

SCALE $1\frac{1}{2}" = \text{ONE FOOT}$

DRAWING N° 7463

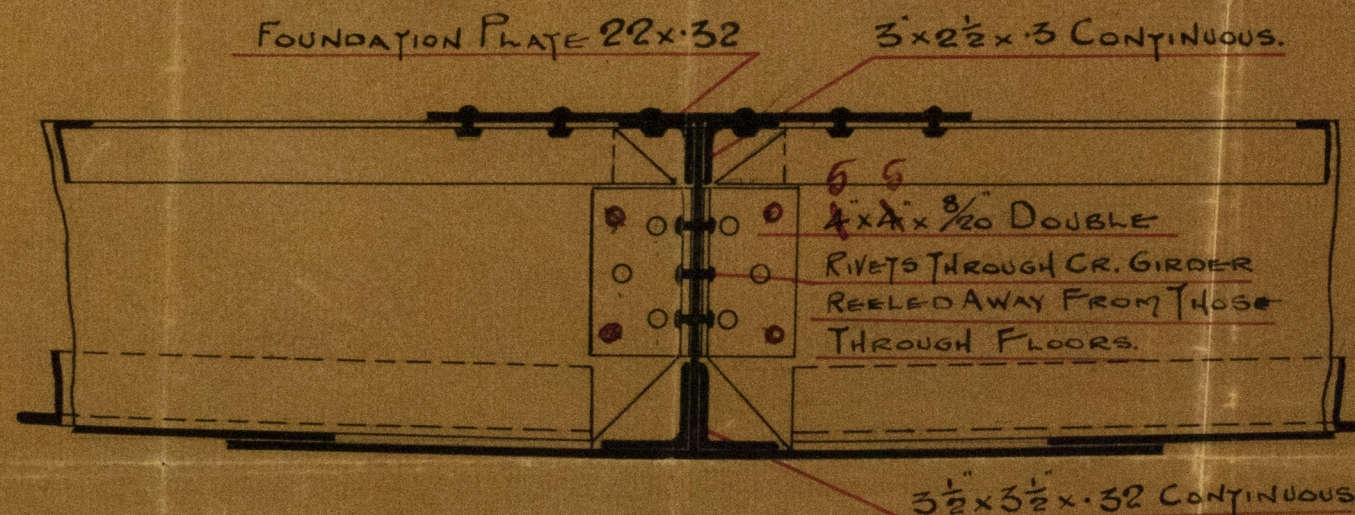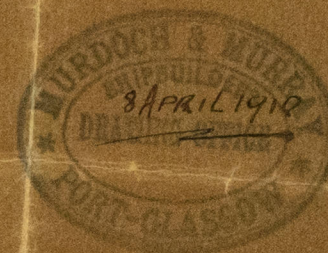


© 2020

Lloyd's Register
Foundation

005709-005725-0071

And Connections at Centre
 Keelson.
 Murdoch Murray
 T.L. No 235

 


PROPOSED AMENDED CONNECTIONS

AT CENTRE KEELSON

T. S. S. No 235

DRAWING No 1463
 SCALE 1" = ONE FOOT

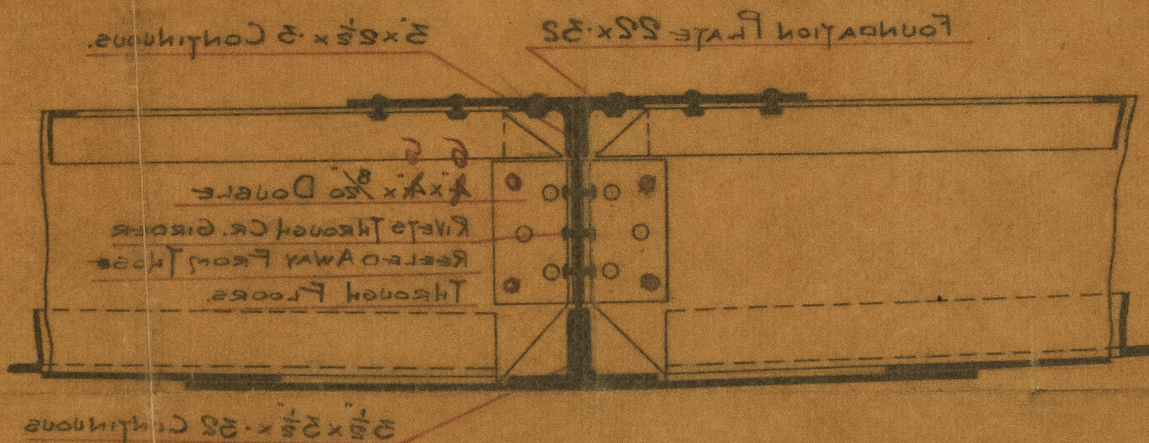

T.S.S. No 235

1500-52750405725-0051



© 2020

Lloyd's Register
 Foundation