



3.11.05
30.1.06
20.8.06

Profile
2.2.2.2
Mackay Brothers
2.2.2.2
11.11.05

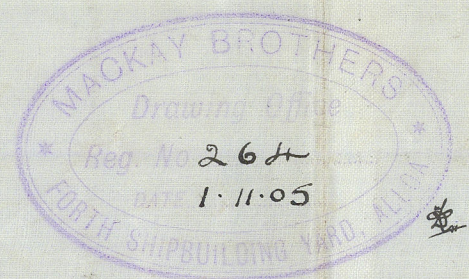

LONGITUDINAL & DECK PLANS . S.S. No 5 LLOYDS 100 A.I.*

SCALE 1/8" INCH = ONE FOOT.

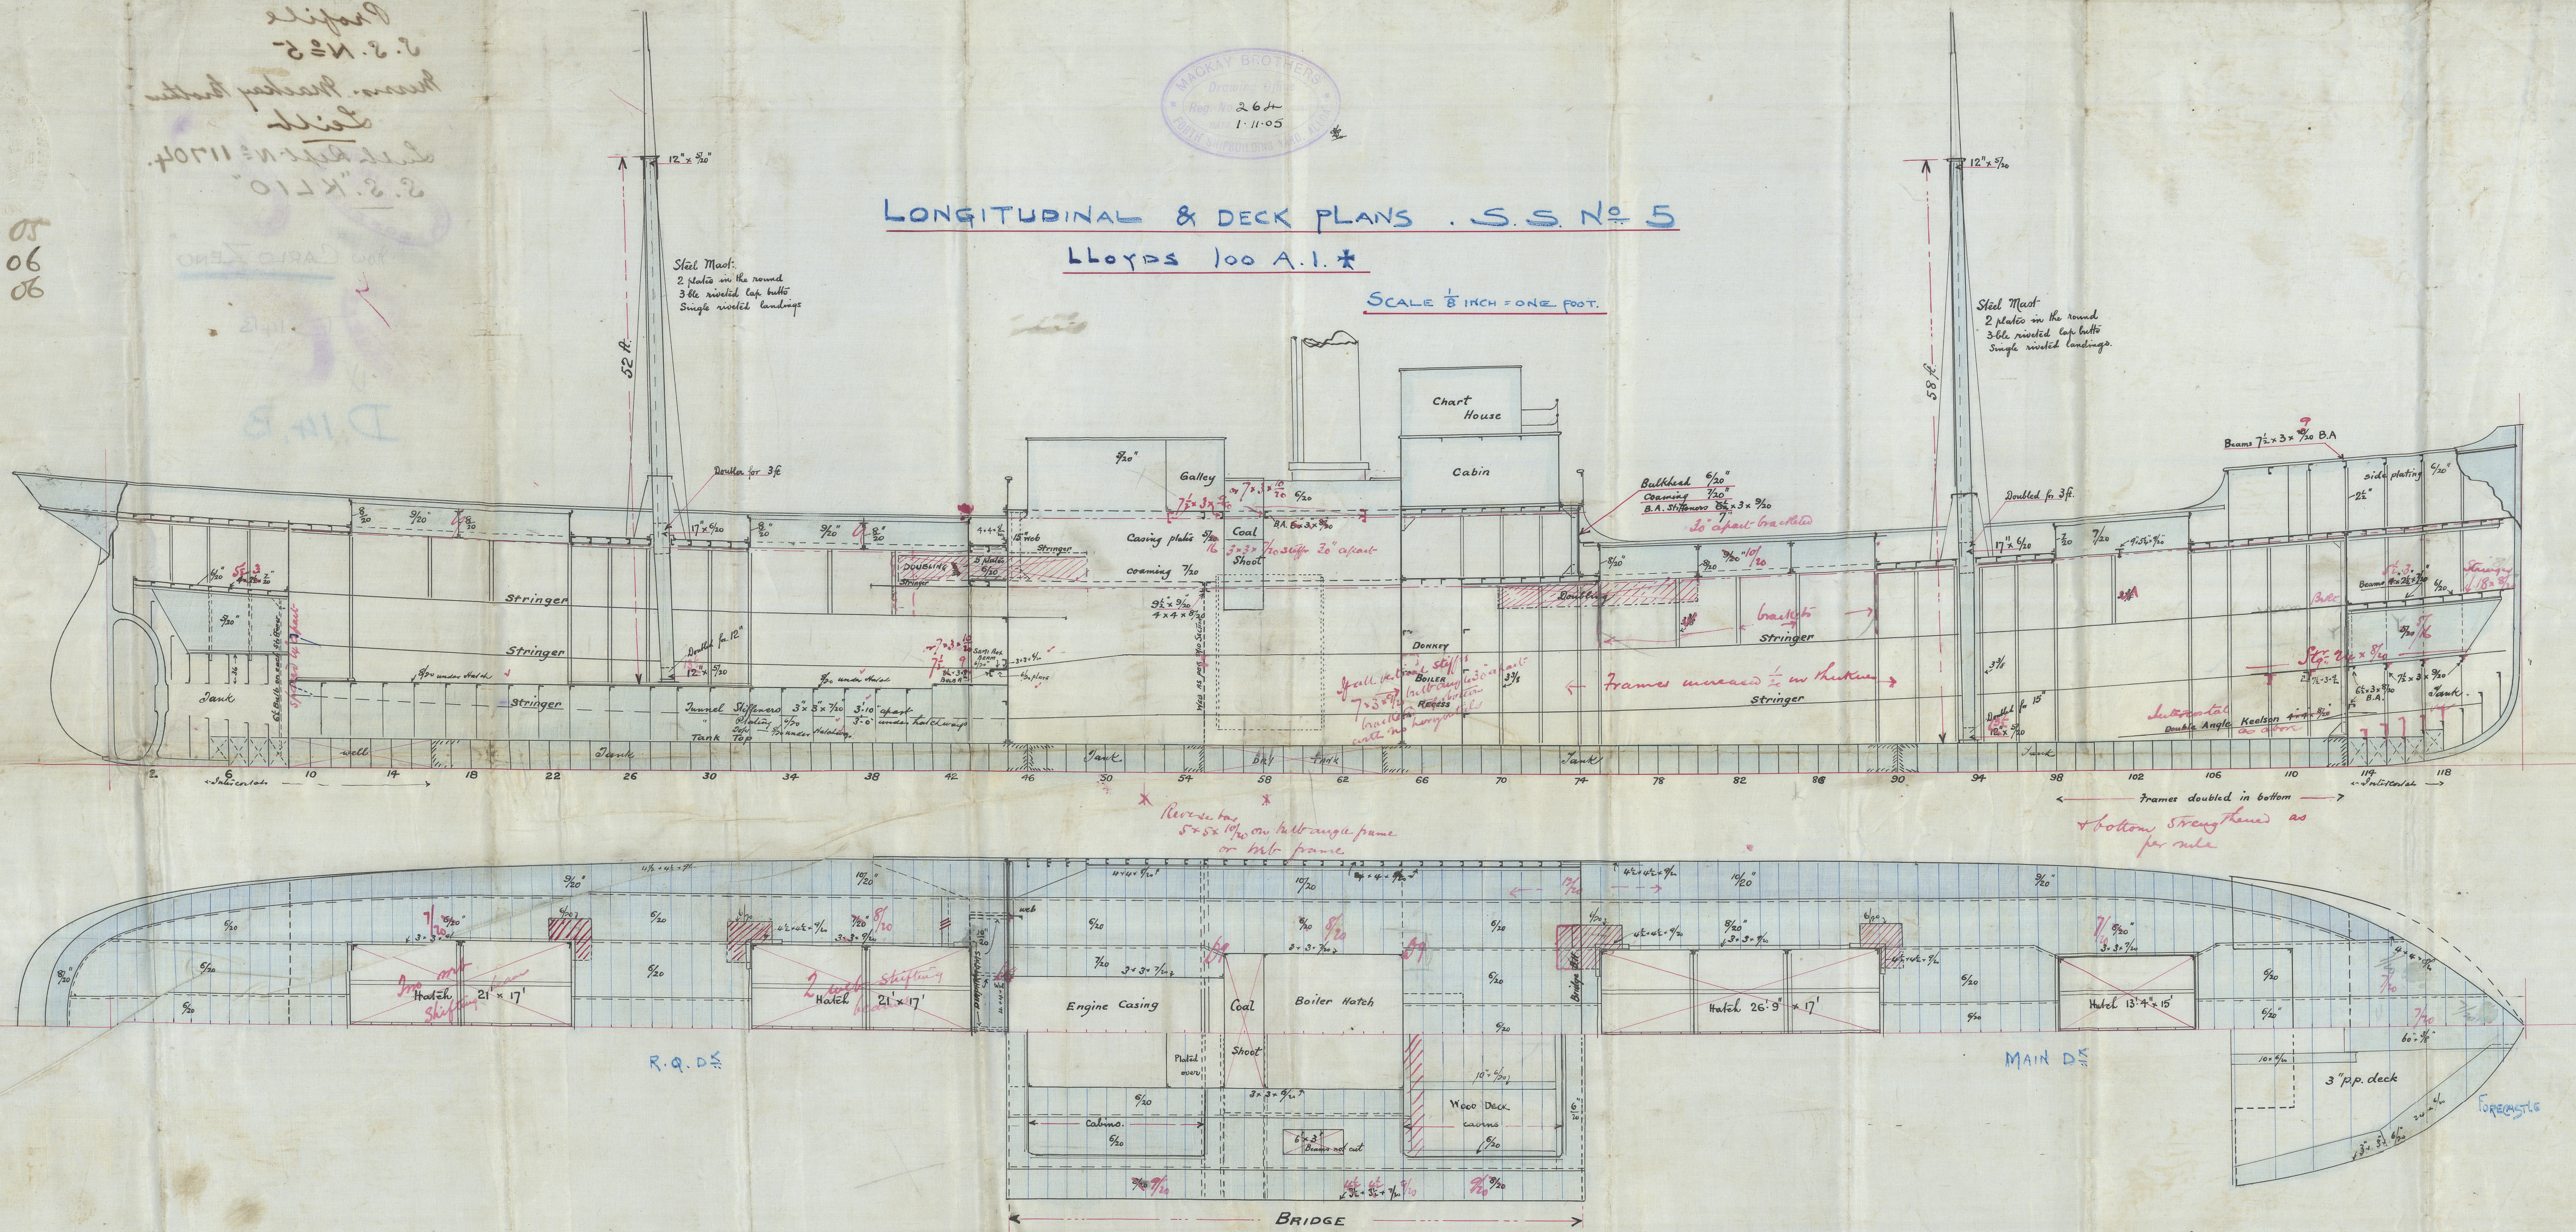

J.H.
3/11/05

Profile

S. S. N^o 5

Messrs. Mackay Brothers
Leith

Leith Rept. N^o 11704.

S. S. "KLIO"

now CARLO ZENO

D. 14 B.

X

D. 14 B.



© 2021

Lloyd's Register
Foundation

005726-005739-0001