
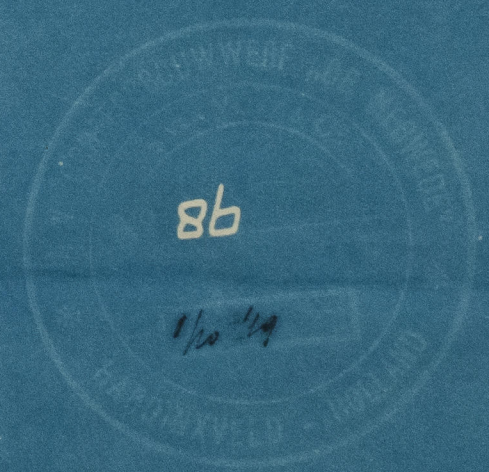


STERNFRAME

TO CLASS 100 A, LLOYDS

13.11.19.
55.134.

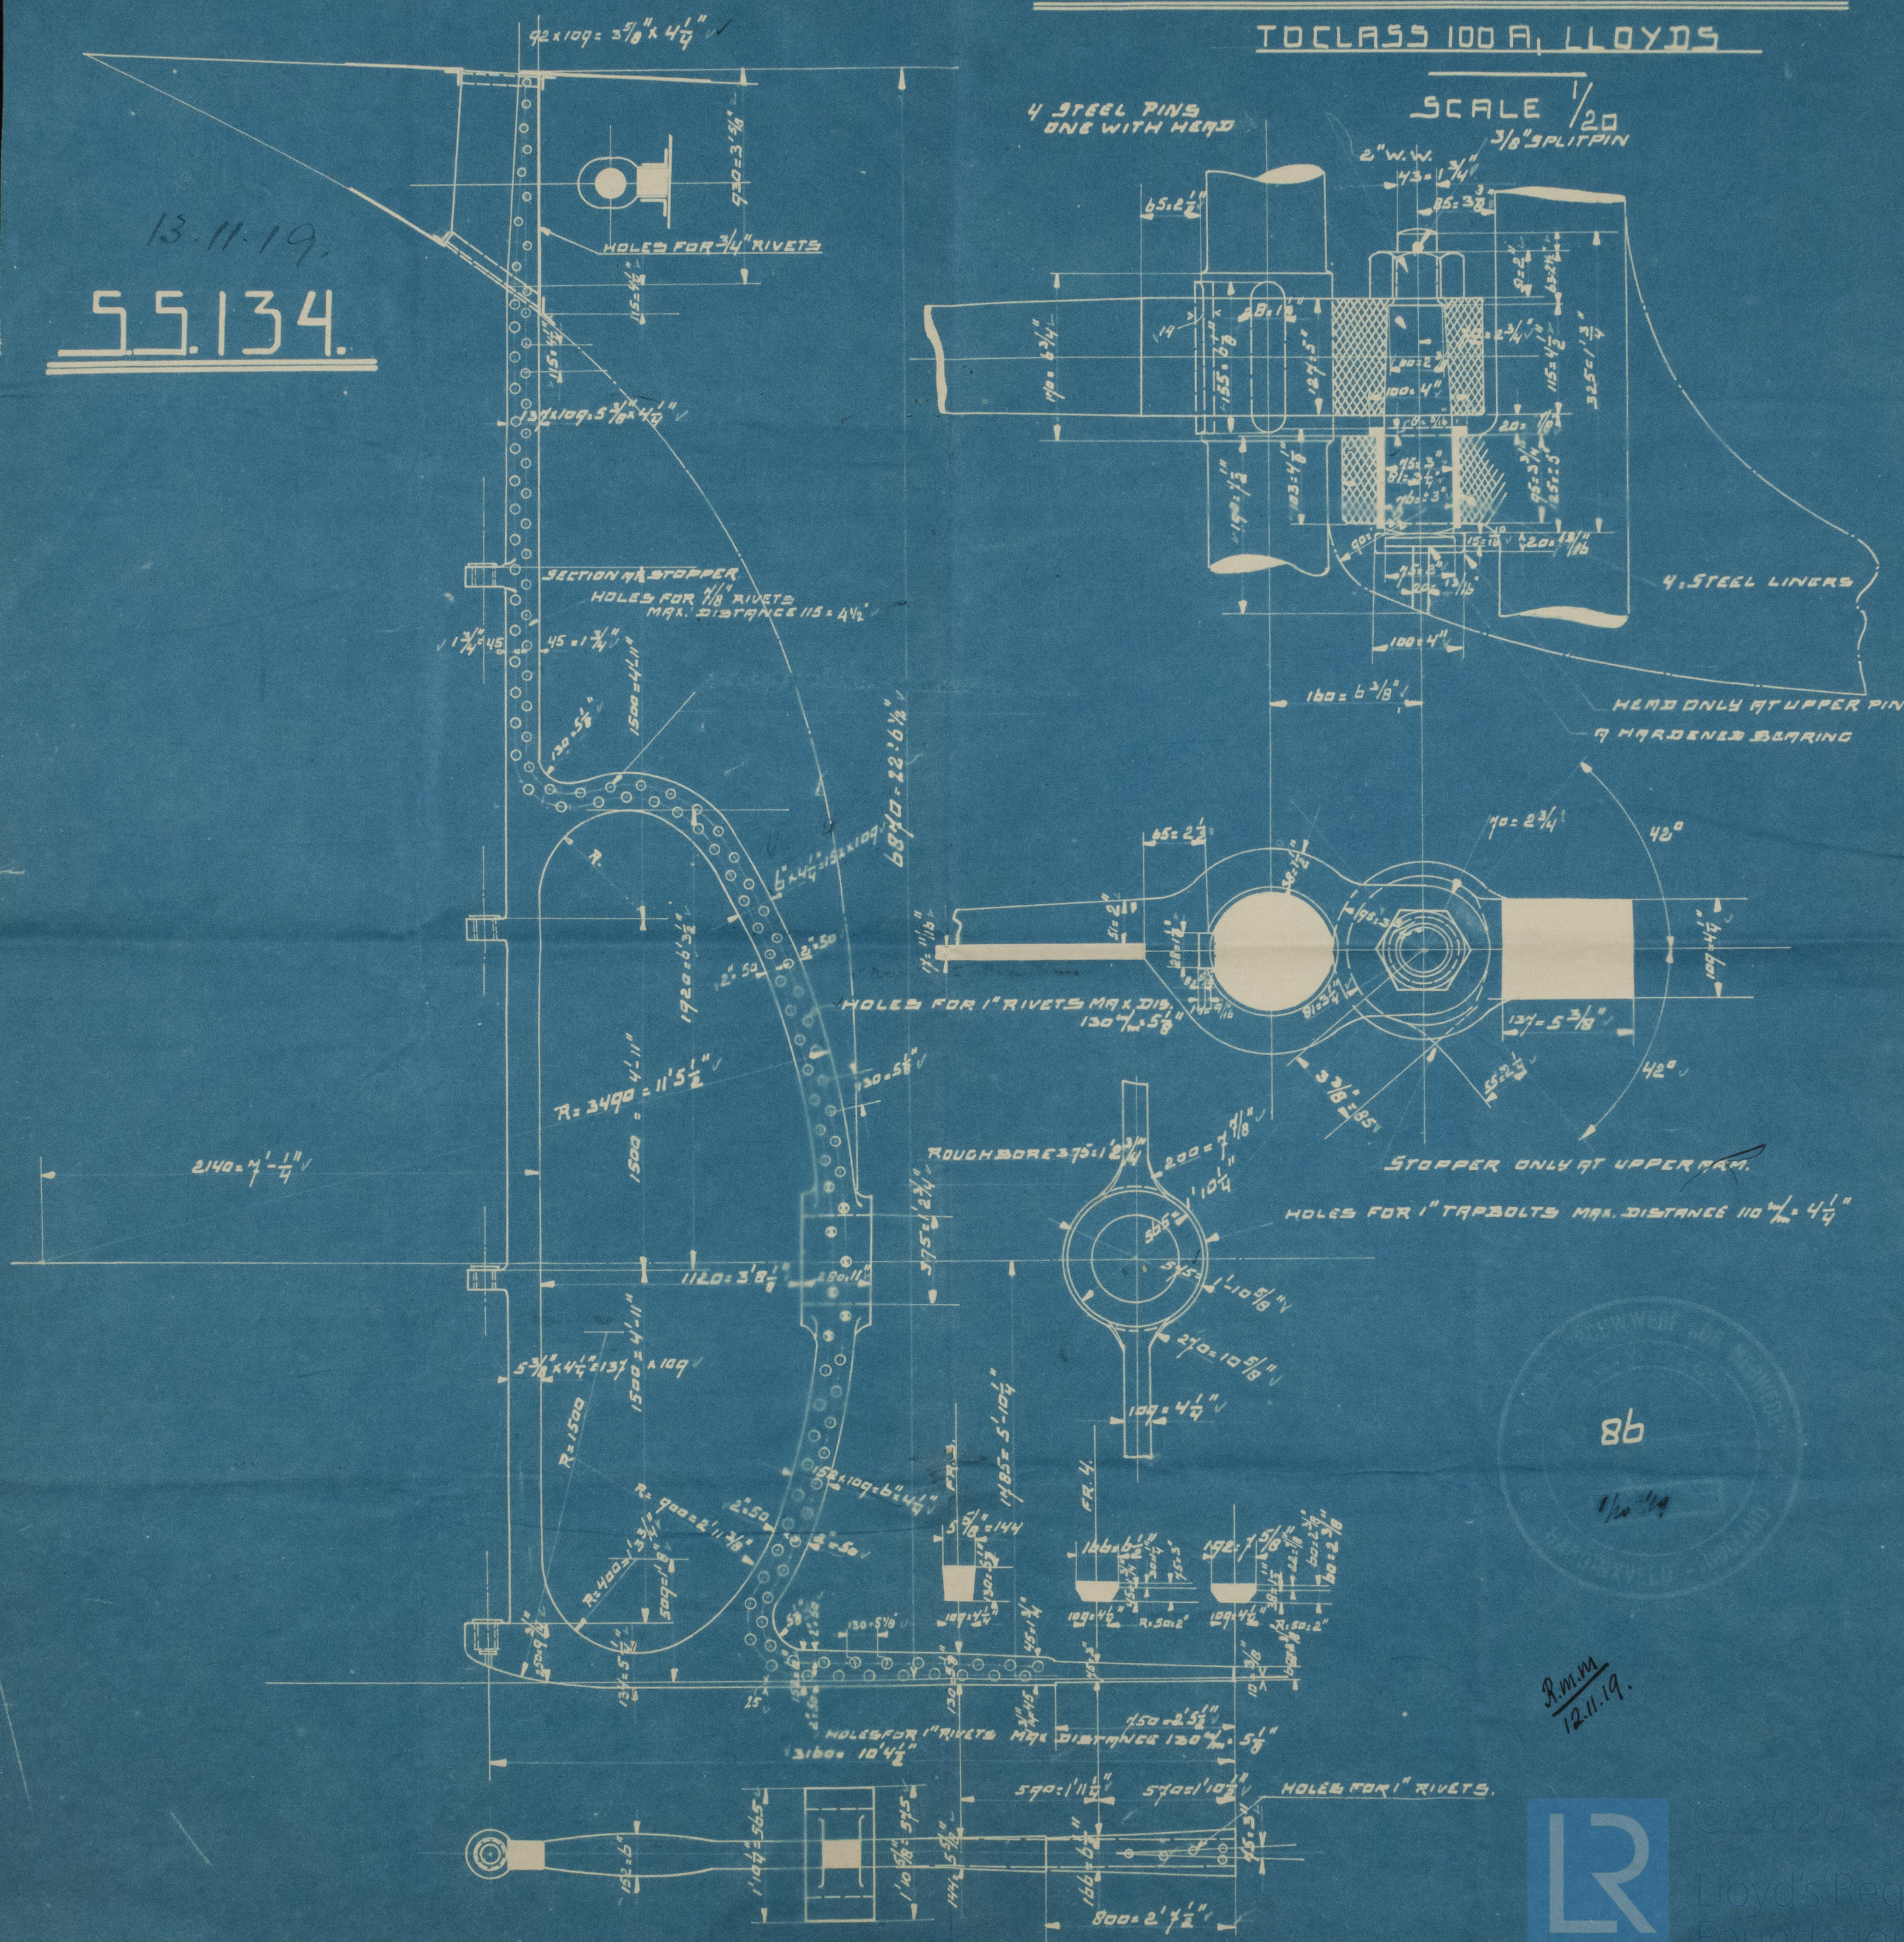

R.m.m.
12.11.19.



© 2020
Lloyd's Register
Foundation

005740-005755-0072

M^h 'ARAGUA'

S/s Abelia

Sturhame

Rotterdam
Report No 11408

005740-005755-0072



© 2020

Lloyd's Register
Foundation