

27/11/19




S.S. No 134

180'-0" x 28'-0" x 14'-6"

LONGITUDINAL SECTION

TO CLASS 100 A LLOYDS

SCALE 1/8" = 1'-0"

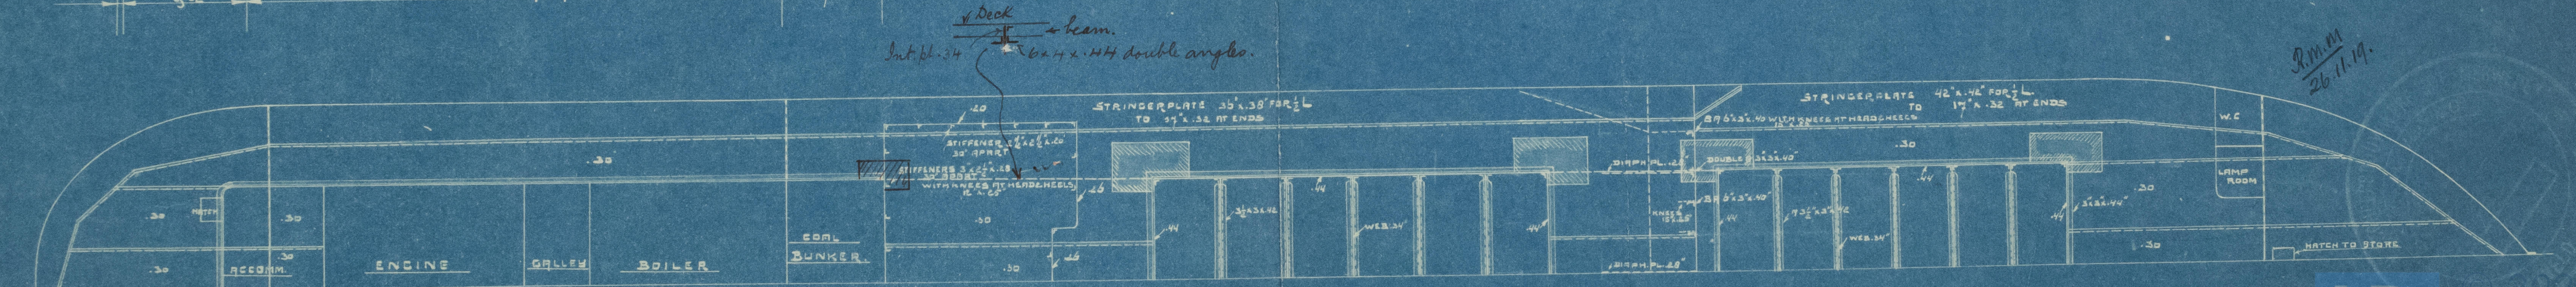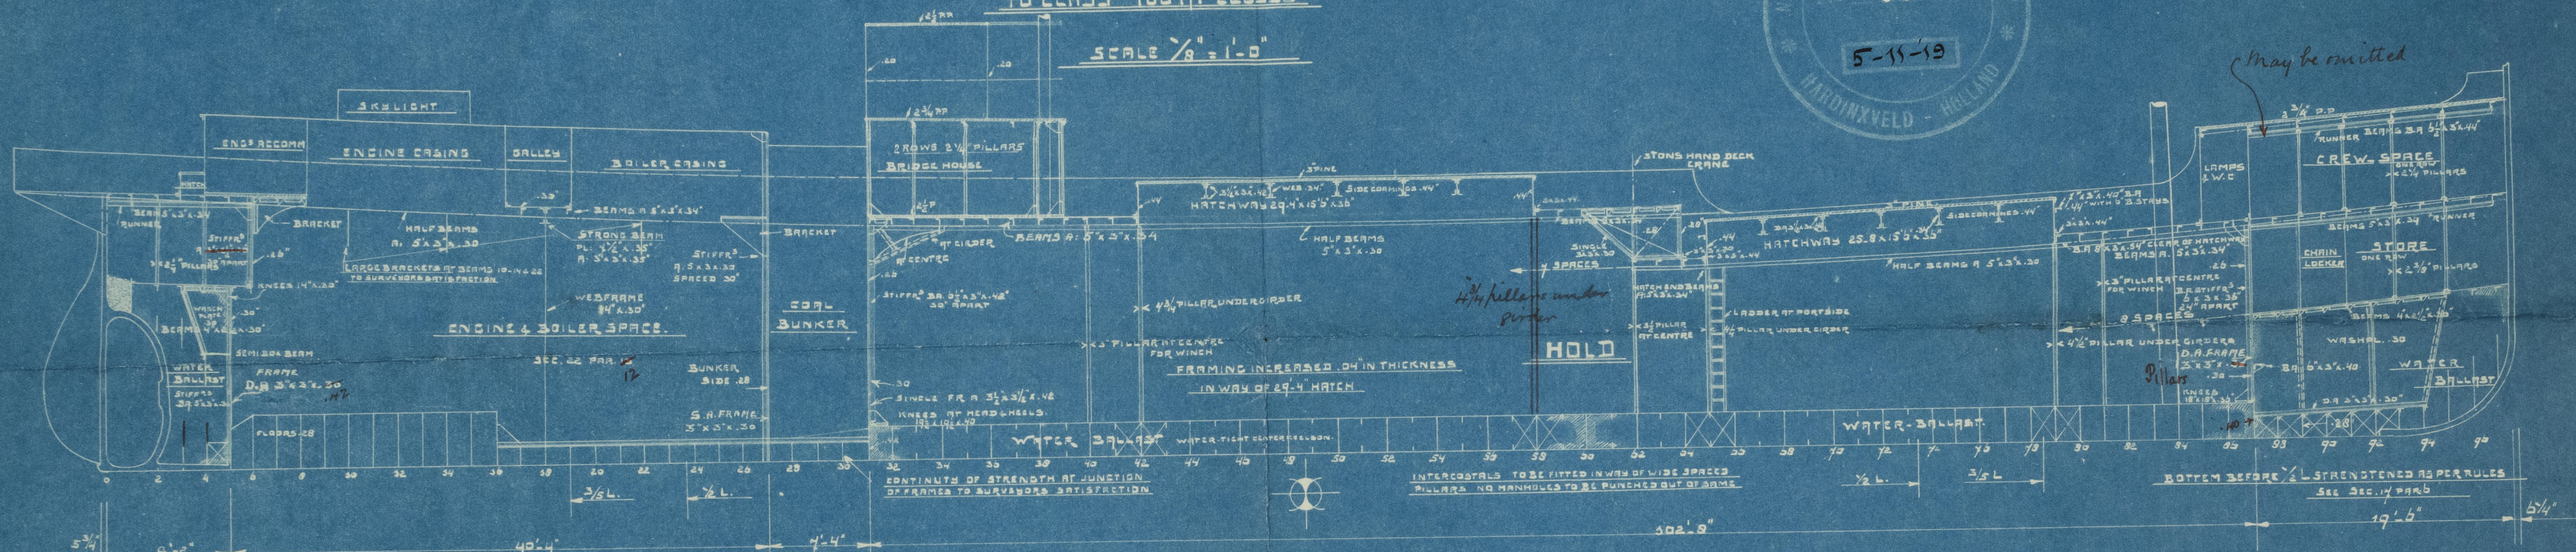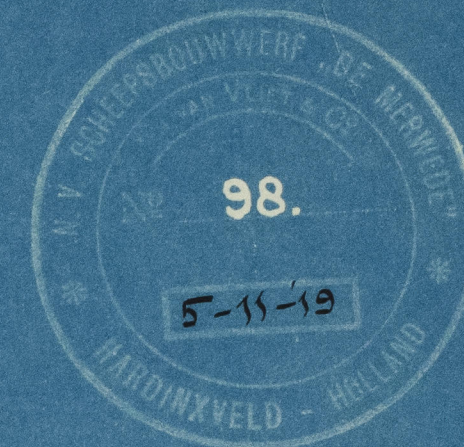


R.M.M.
26.11.19.



Lloyd's Register
Foundation



Now "ARAGUA" 

S/S "Abelia"

Profile & Decks

Rotterdam Report
No 11408



© 2020

Lloyd's Register
Foundation

005740-005755-0075

Purple 134



© 2020

Lloyd's Register
Foundation