



13.11.11



PROFILE & DECK PLAN

Nº 521


DIMS 120'-0" x 21'-6" x 12'-6" DEPTH M^{LD}

SCALE 1/4" = ONE FOOT

PLAN No. 892
FOR ENCLOSURE TO
Messrs Lloyd's Surveyors
Full FROM
COCHRANE & SONS,
SHIPBUILDERS, SELBY
DATE November 3rd 1911 *RL*

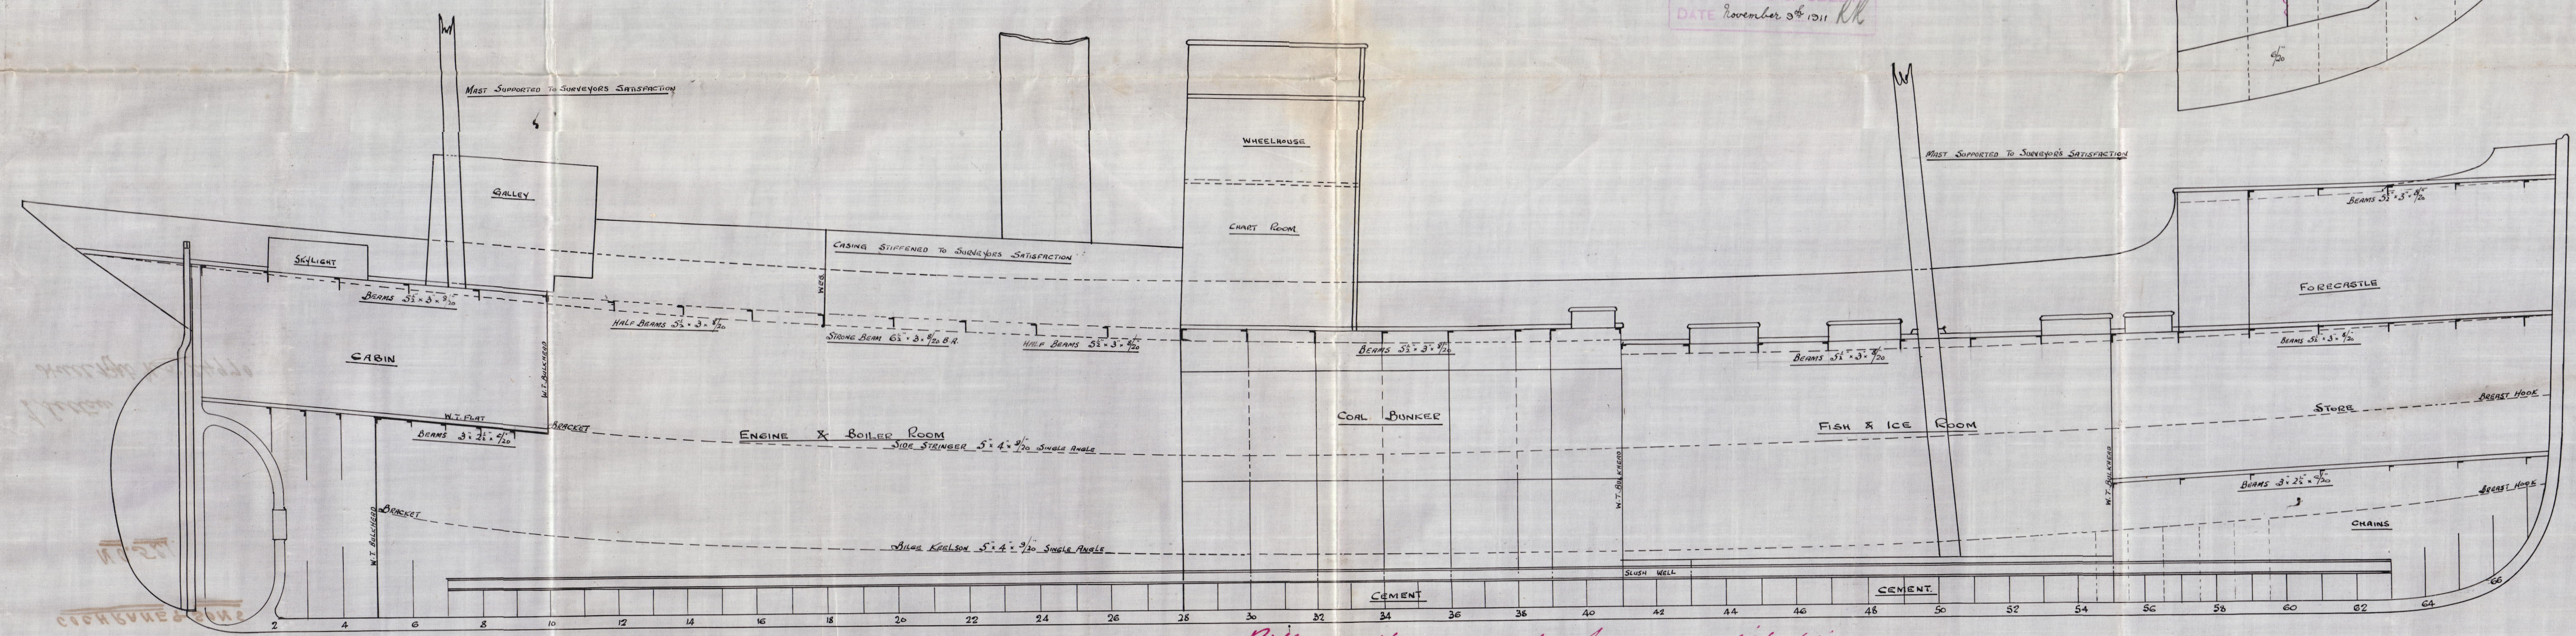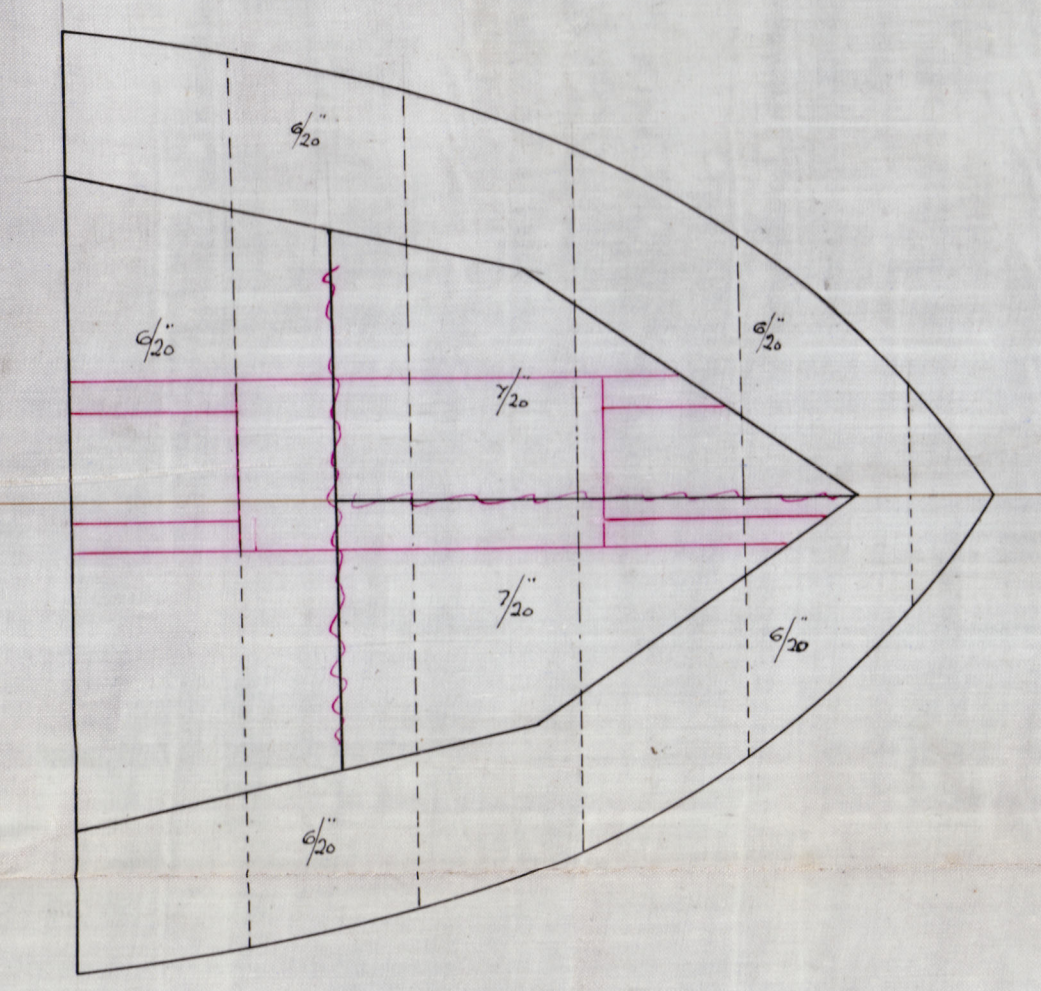

Pillaring throughout to Surveyors satisfaction

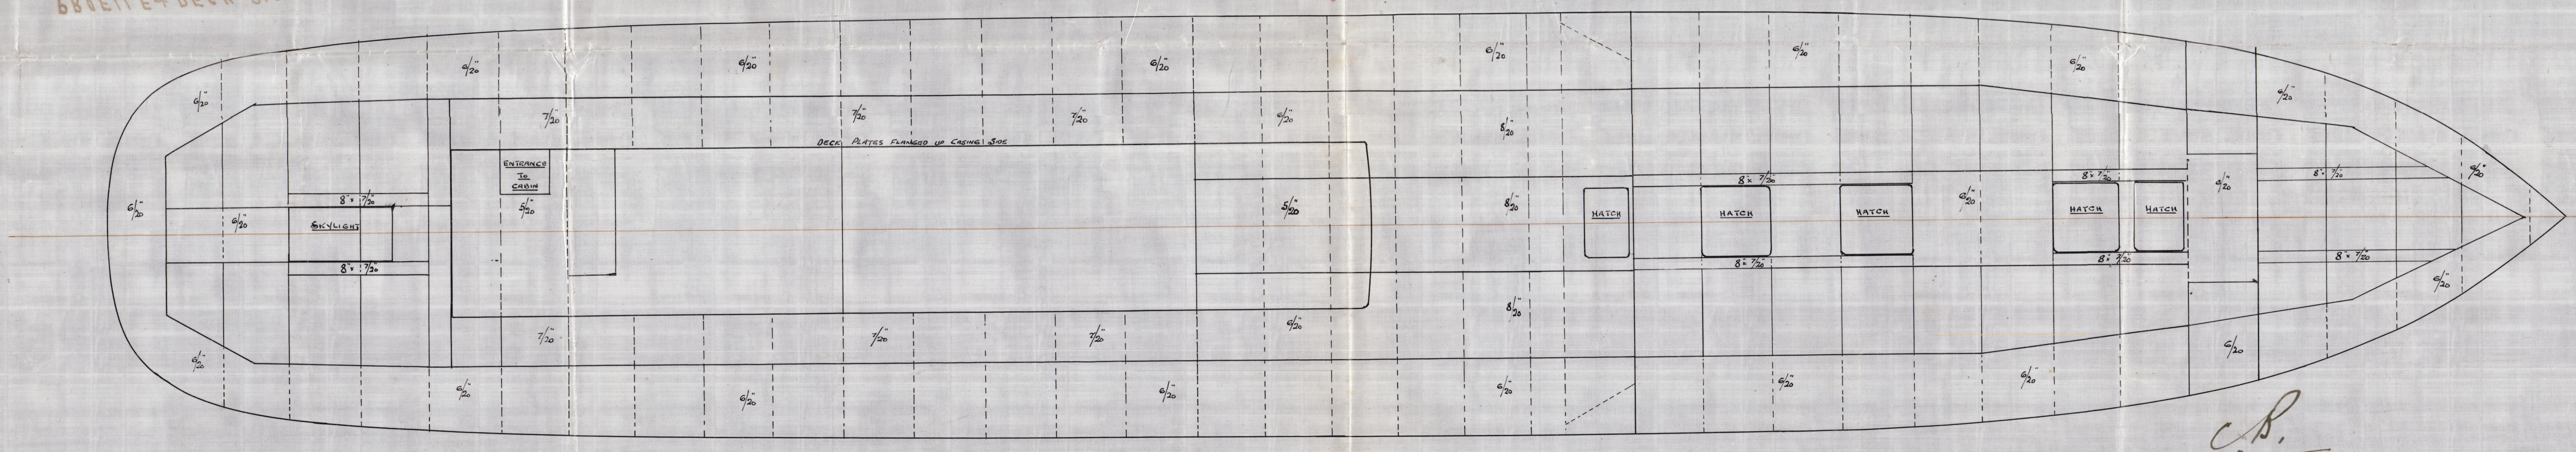

C.B.
13.11.11

No. 521.

1. Lettsu

Hull Rpt No: 24970

