

Earle's S. & C. Ltd.


No 560

Amended

Midship Section As Built

"Bull"

Hull Report No. 21947

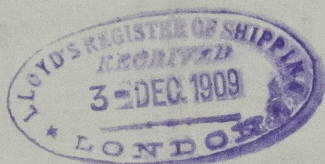

005779-005790-0248



© 2021

Lloyd's Register
Foundation