



5-1-12


SECTIONS OF TANK (F.N. 6-9)
SCALE 1/8" TO 1" FOOT.

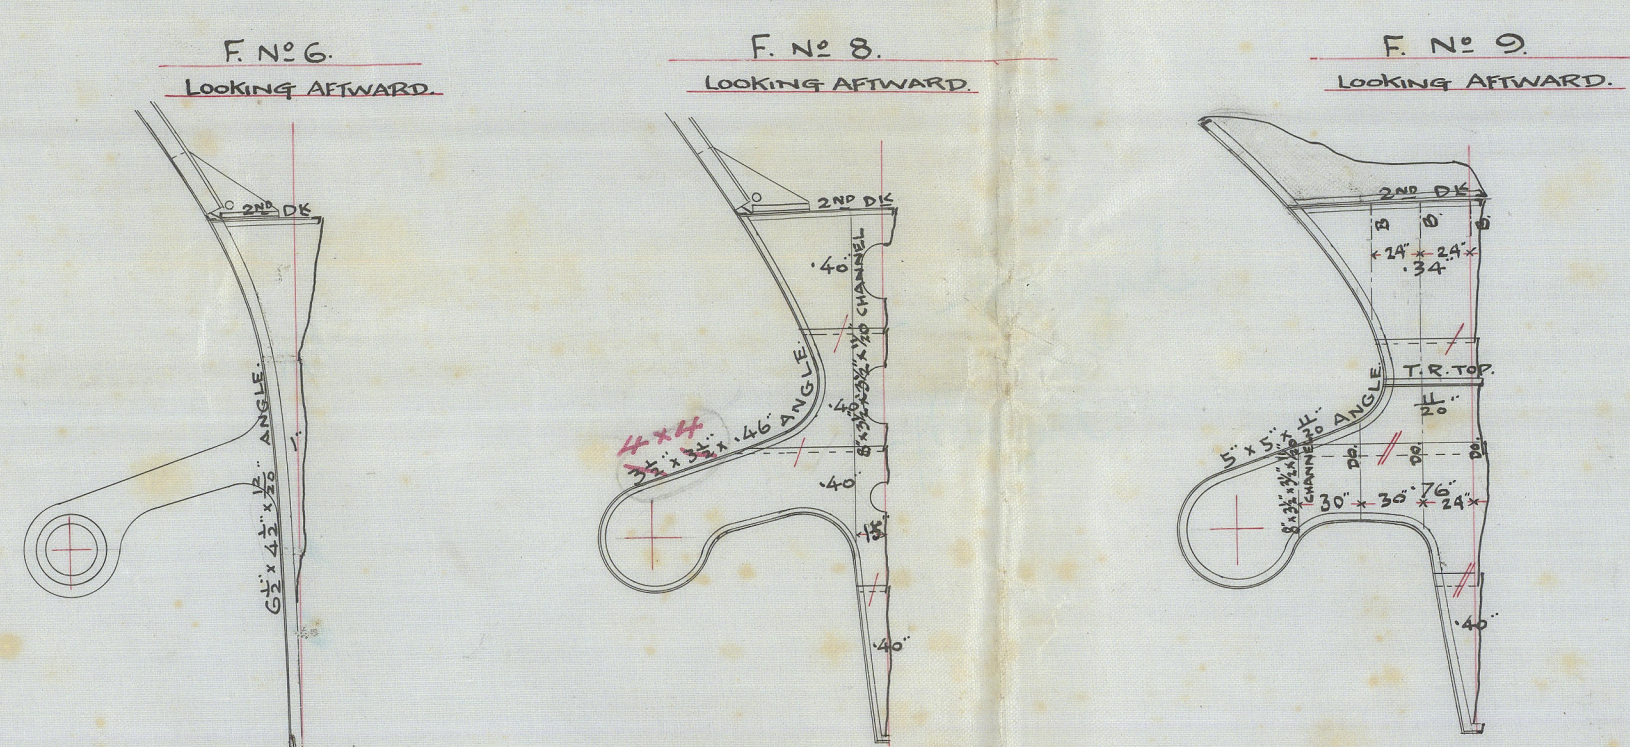

SECTIONS OF TUNNEL RECESS (F.N. 11-20)
SCALE 1/8" TO 1" FOOT.

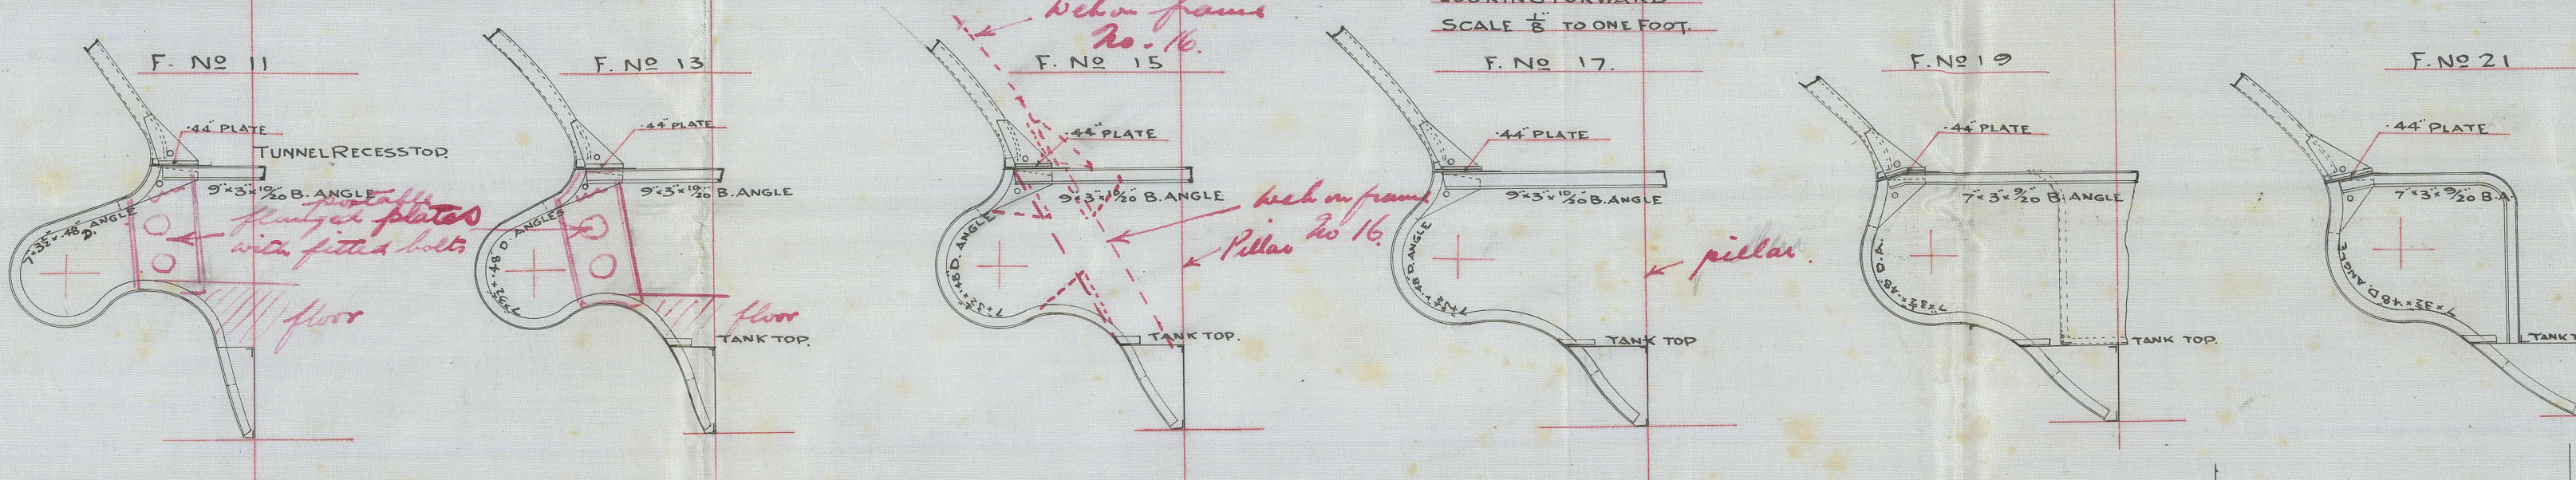

N^o 229.
ALTERATION PLAN
CONSTRUCTION PROFILE & DECK PLANS.
SCALE 1/8" INCH TO ONE FOOT.
NOTICE: - HATCHING DENOTE ALTERATION.

 

REMARK:-
1) MATERIALS IN BOTH OF AN INCH = STOCK MATERIAL.
2) DECIMAL = NEW.

C.F.
4-1-12

N^o 229
Altitude Profile
+
Decks
Nagasaki
J. S. "ANYO MARU"
Rept. N^o 826



© 2021

Lloyd's Register
Foundation

003826-003839-0220