




No 229. S. S. Anyo Maru
 SHELTER DECK STEAMER 460'-0" x 60'-0" x 32'-6" (TO UPPER DECK)
 (Free hand sketch.)

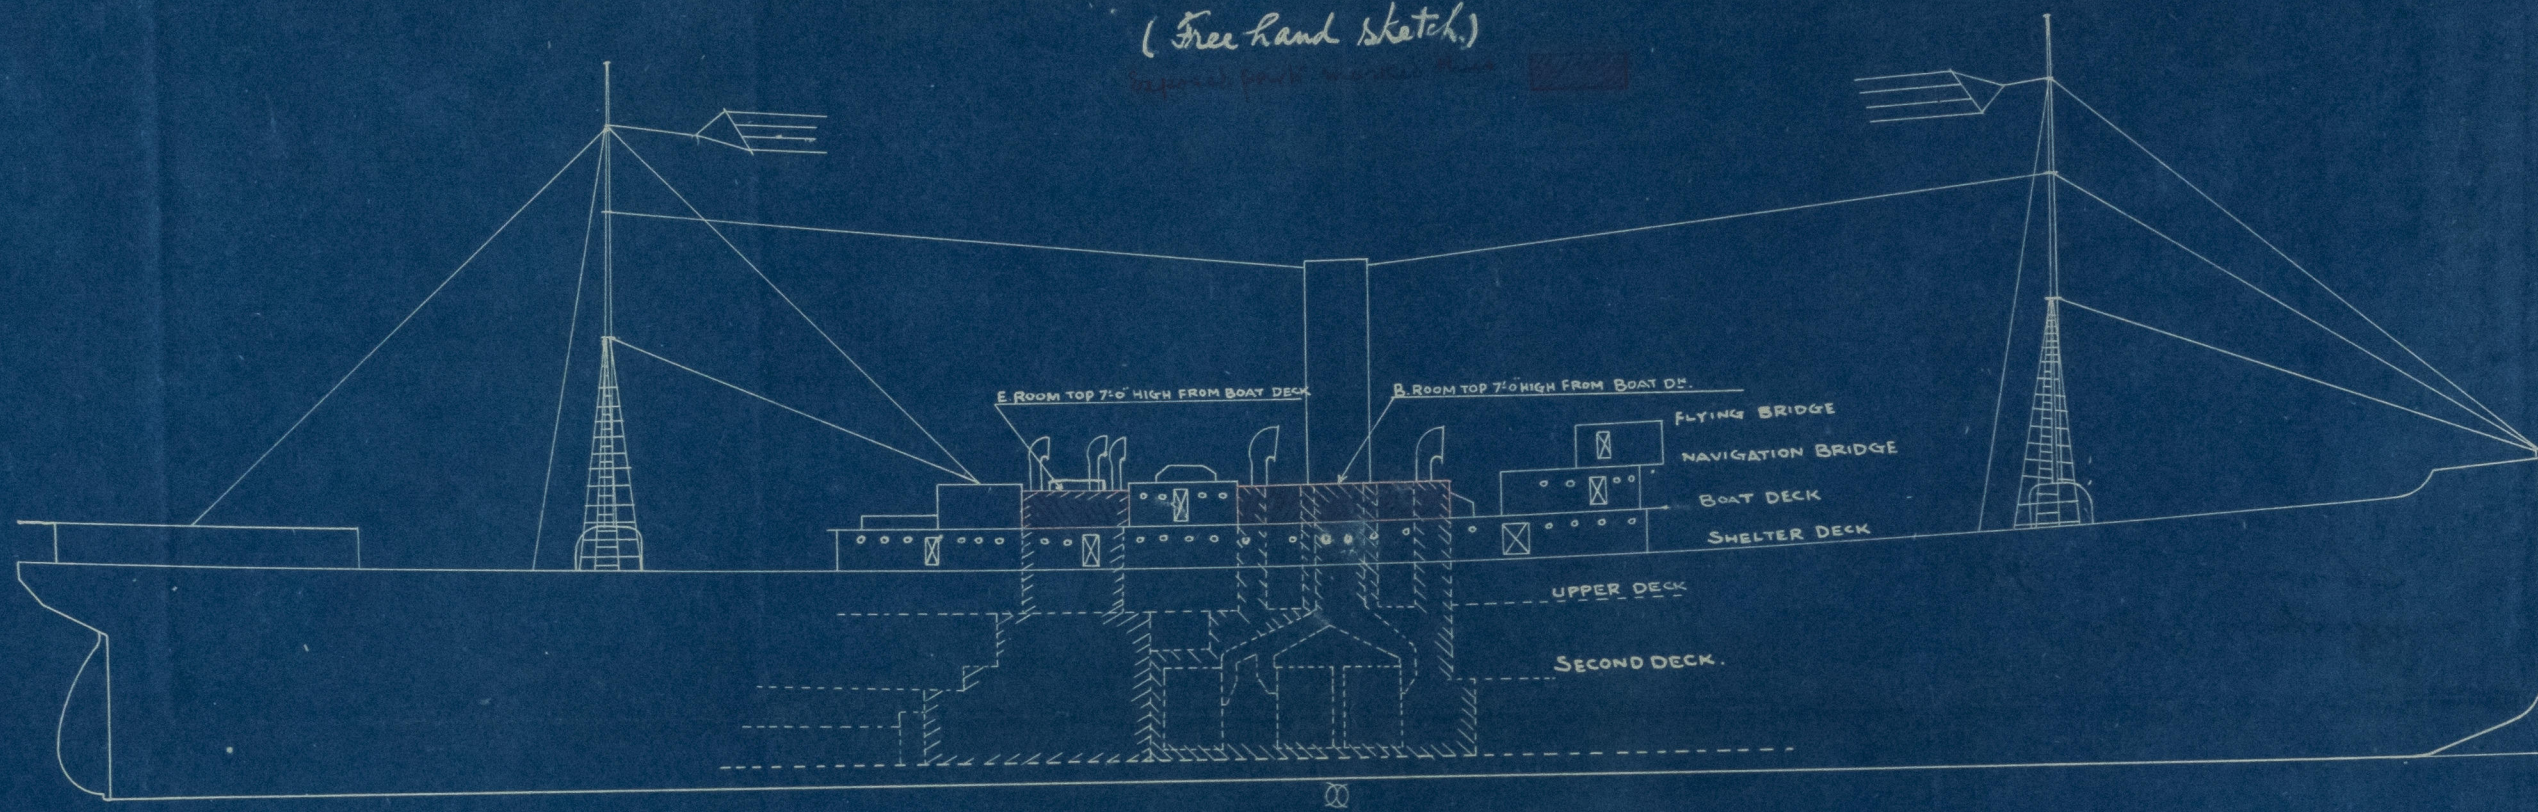

BOAT DECK HEIGHT BEAM TO BEAM 8'-0"
 SHELTER DECK HEIGHT FROM UP. DECK 8'-0"
 UPPER DECK HEIGHT FROM BASE LINE AT $\frac{1}{2}$ AT CENT. LINE 33'-0 $\frac{3}{4}$ "

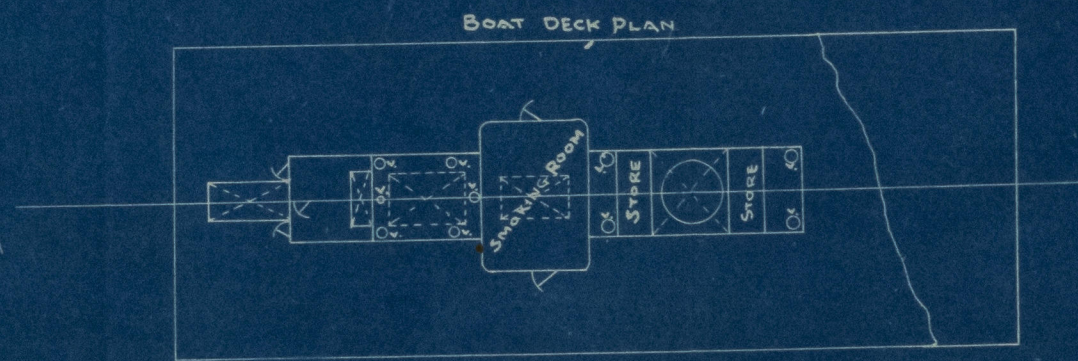


MAKER'S SIGN
 DOCK YARD & ENGINE WORKS
 NAGASAKI
Lloyd's local surveyor
 DRAWN BY
 TRACED BY
 CHECKED *Frank*
 APPROVED
 DRAWING NO. 45088
 DATE MAR 17 1913

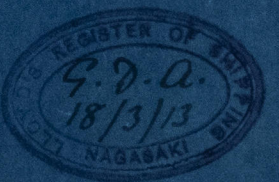

Lloyd's Register
 Foundation

229 Amoy Marine
Sketch of Casings
for Freeboard
Reft-N^o 810
Nagasaki

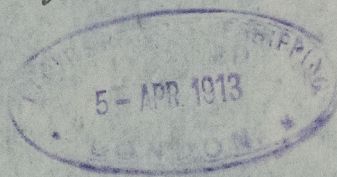

© 2021

Lloyd's Register
Foundation

005826-005839-0245