


M.S. ASUKA MARU.

ALTERATION PLAN OF PUMPING ARRANGI.


SCALE 1/8" TO A FOOT.

ALTERATION SHOWN IN RED


以外二枚所送
PH 7/2 C 2 2

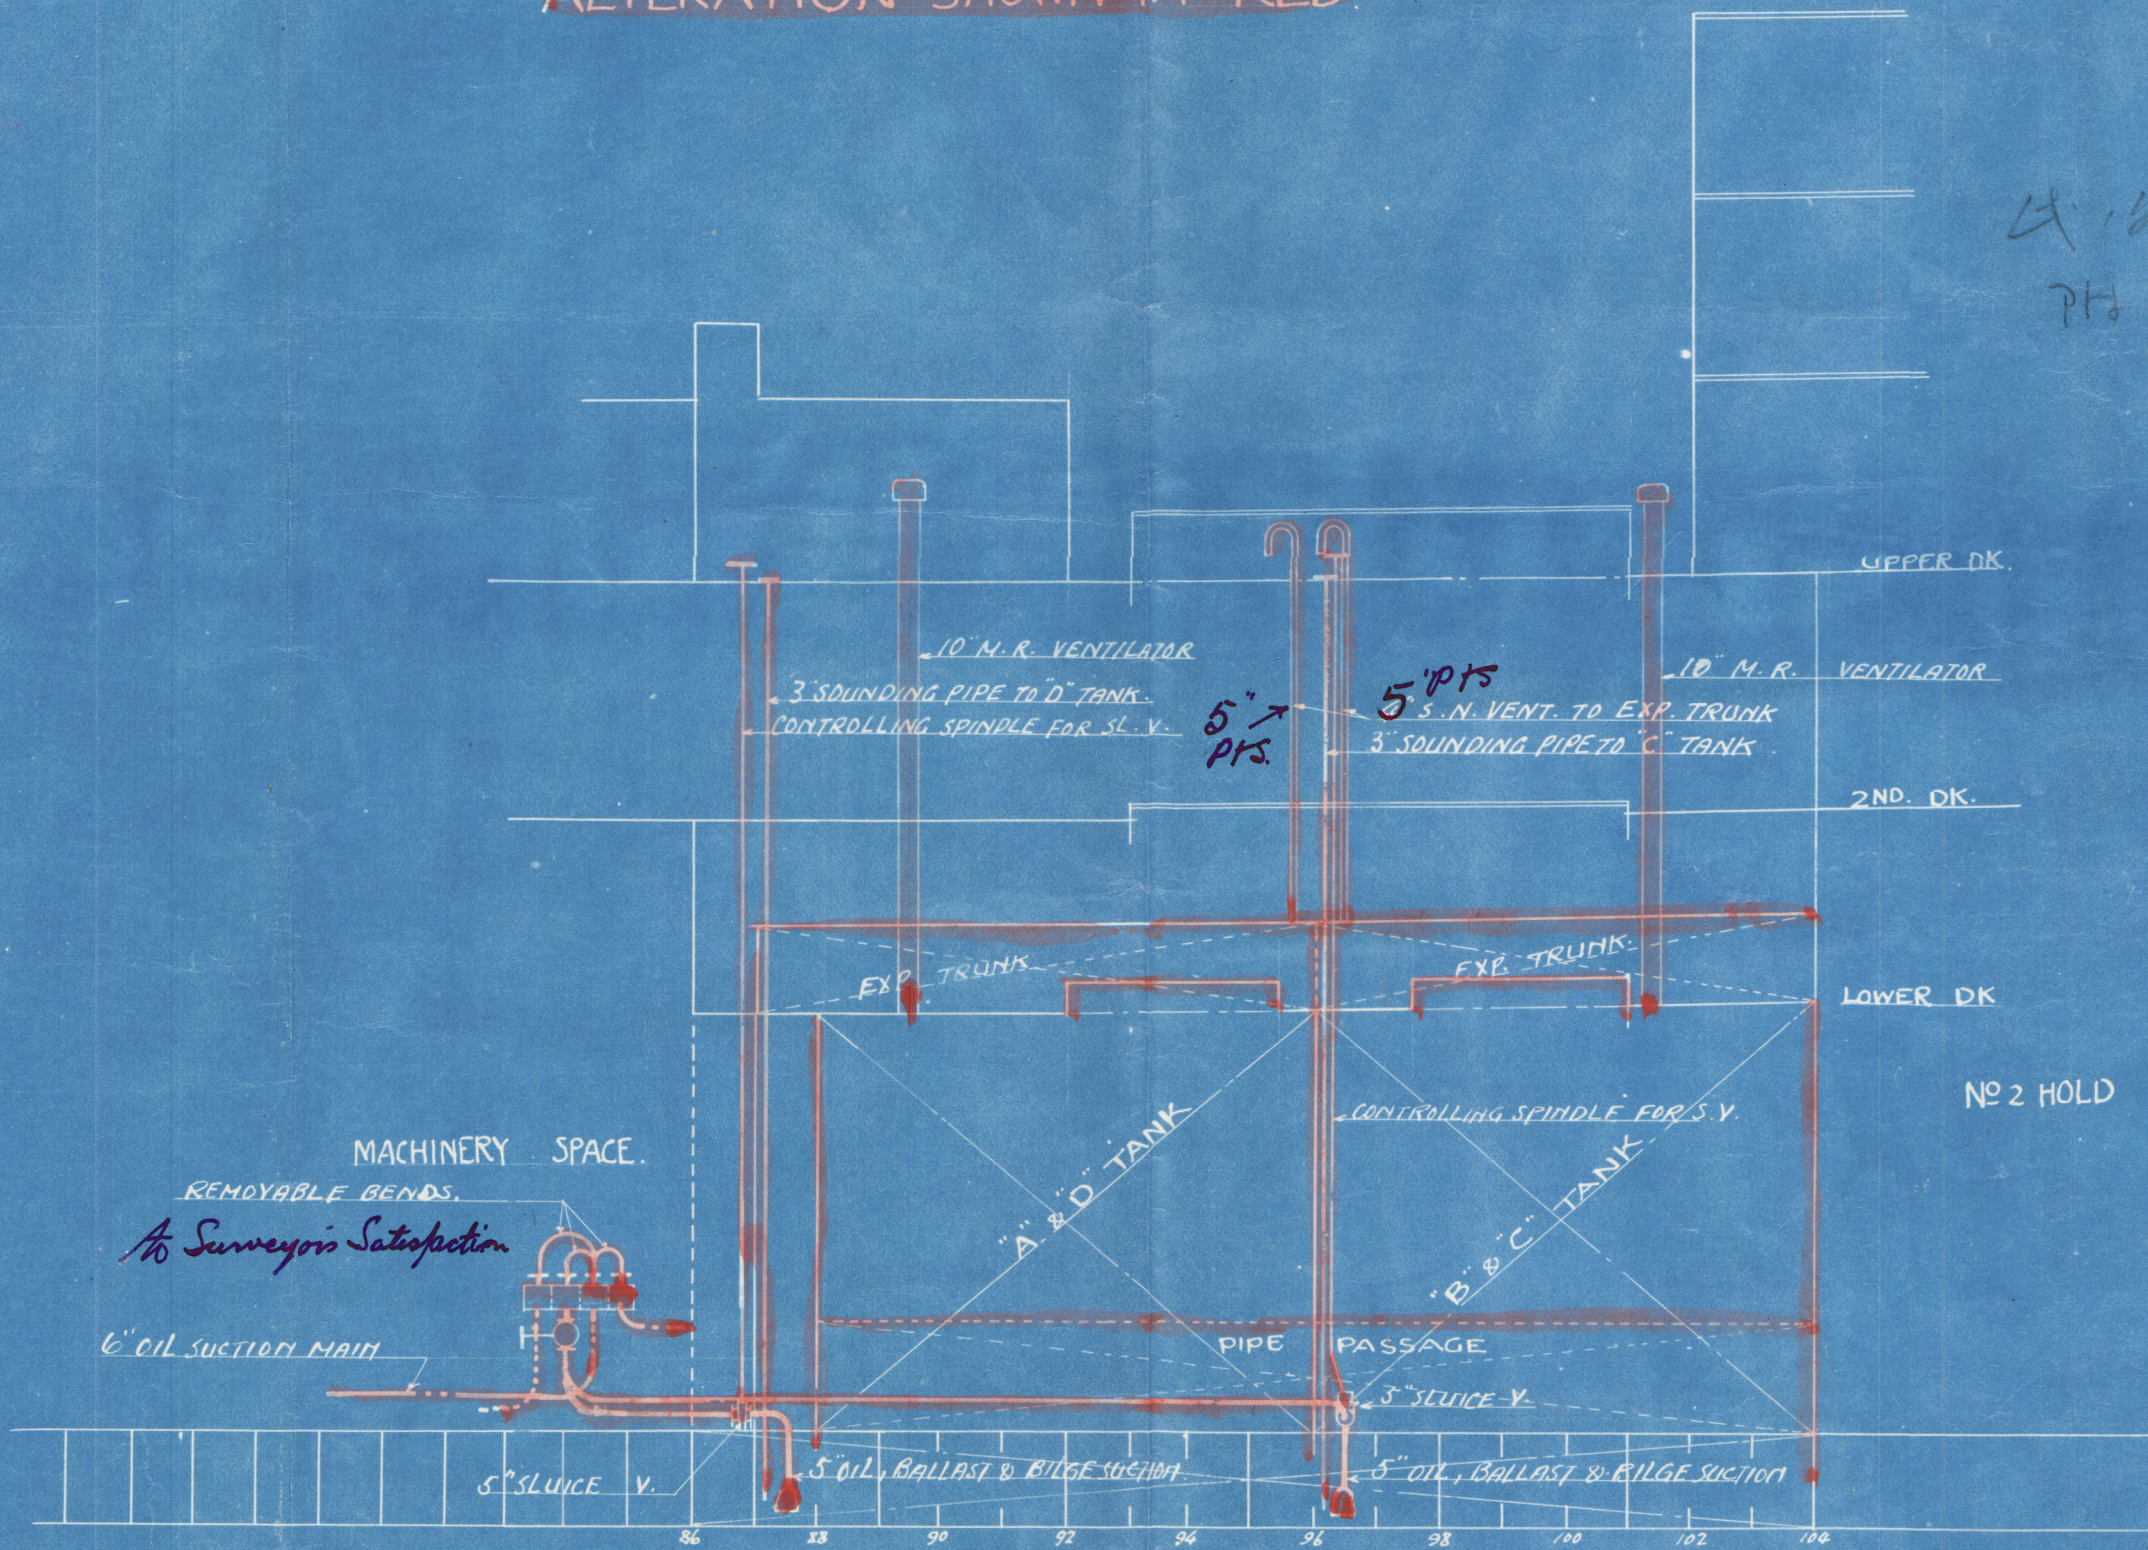

UPPER DECK

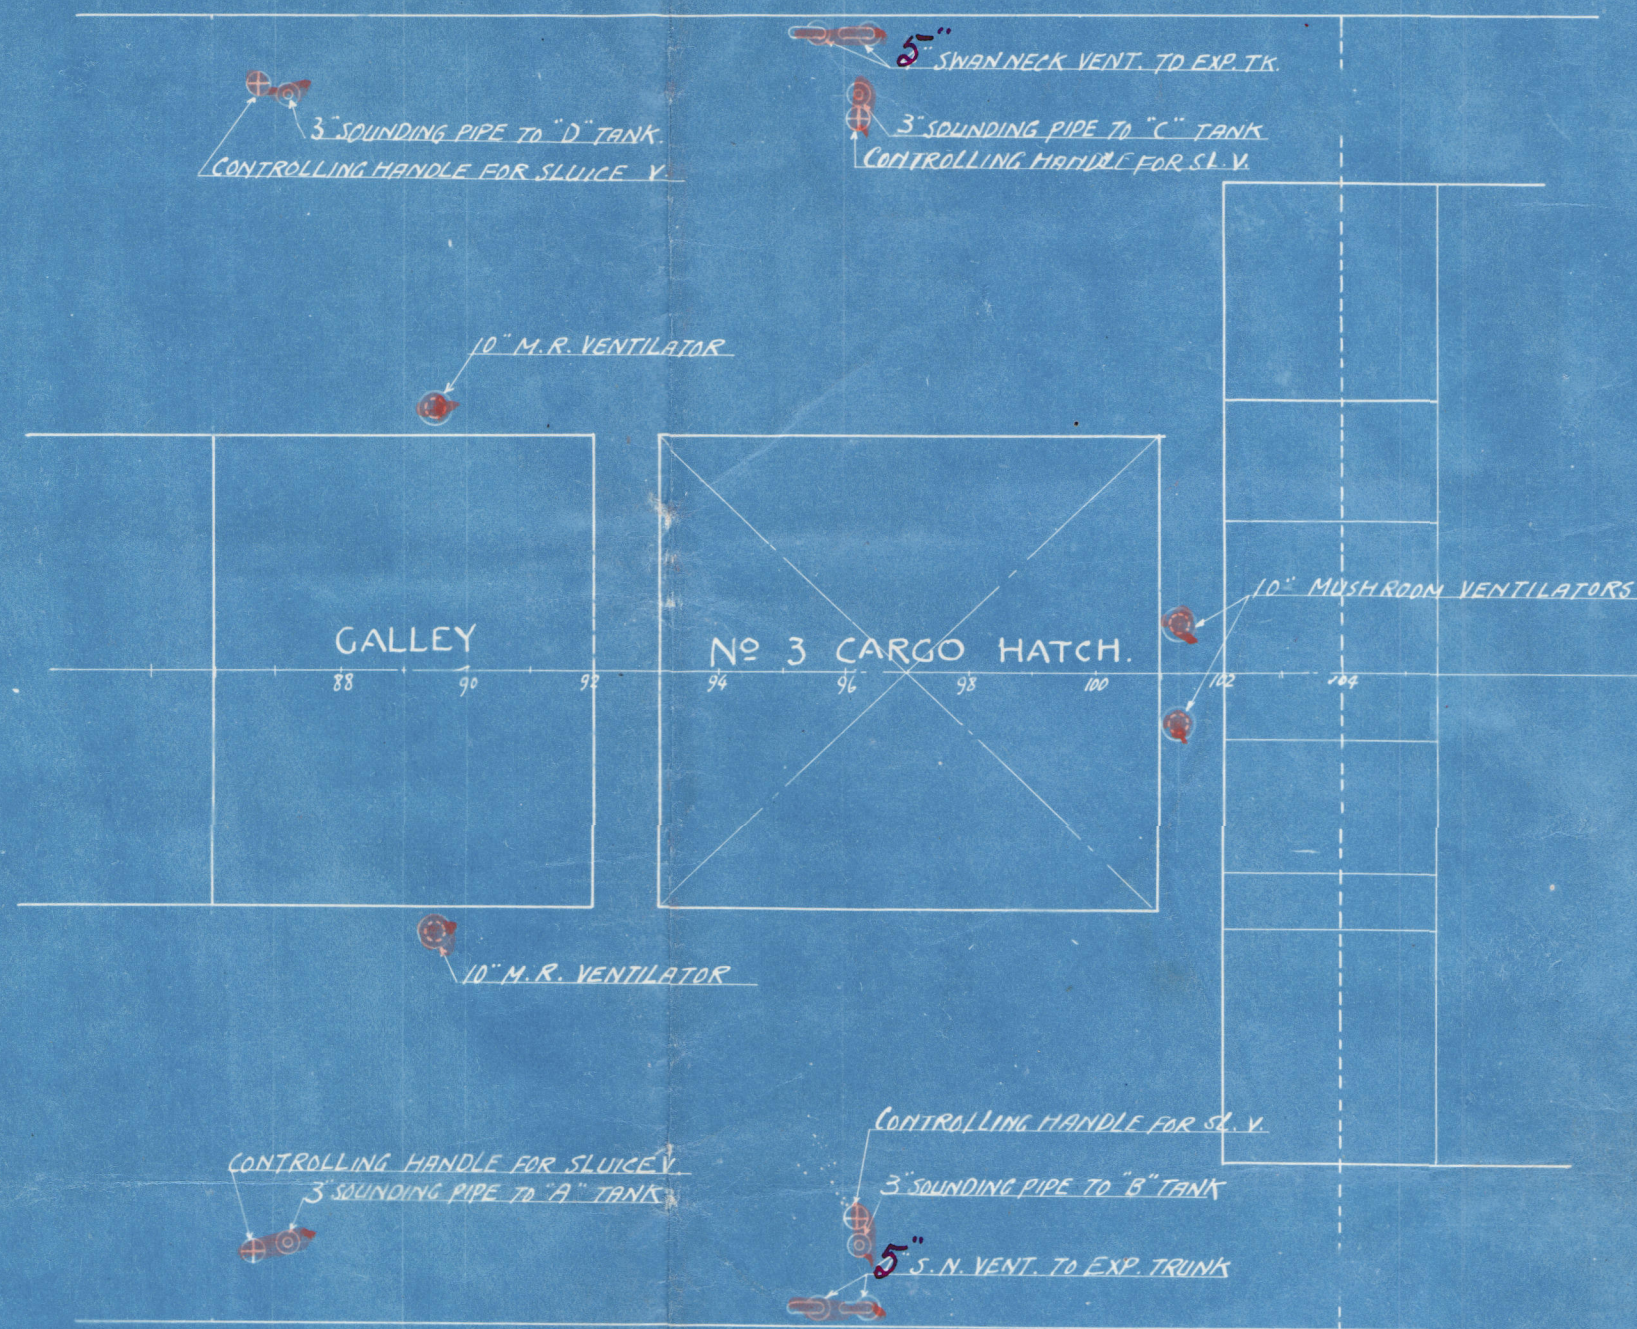

LOWER DECK

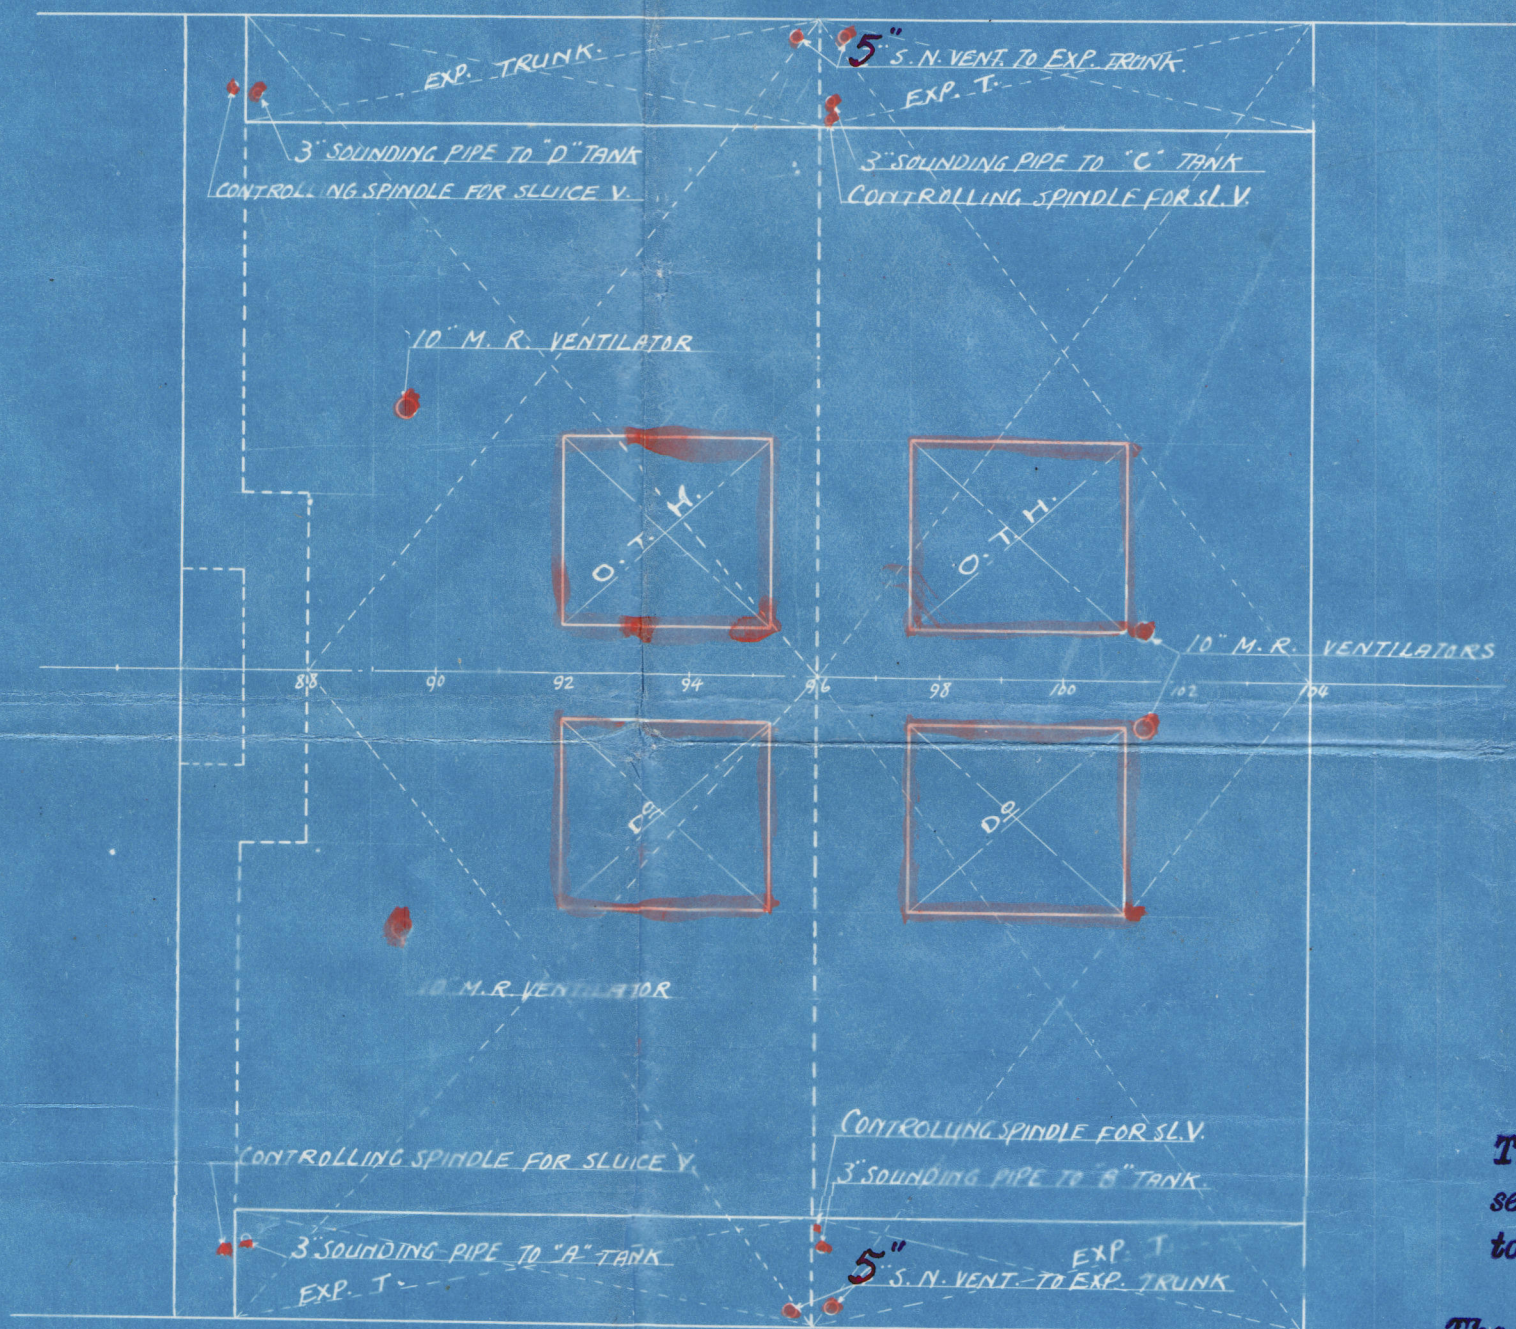

TANK TOP

The remaining requirements of section 34 of the rules to be complied with.

The flash point of the oil fuel to be above 150° F. and those remaining requirements of section 35 of the rules which apply to be complied with.

APPROVED

