
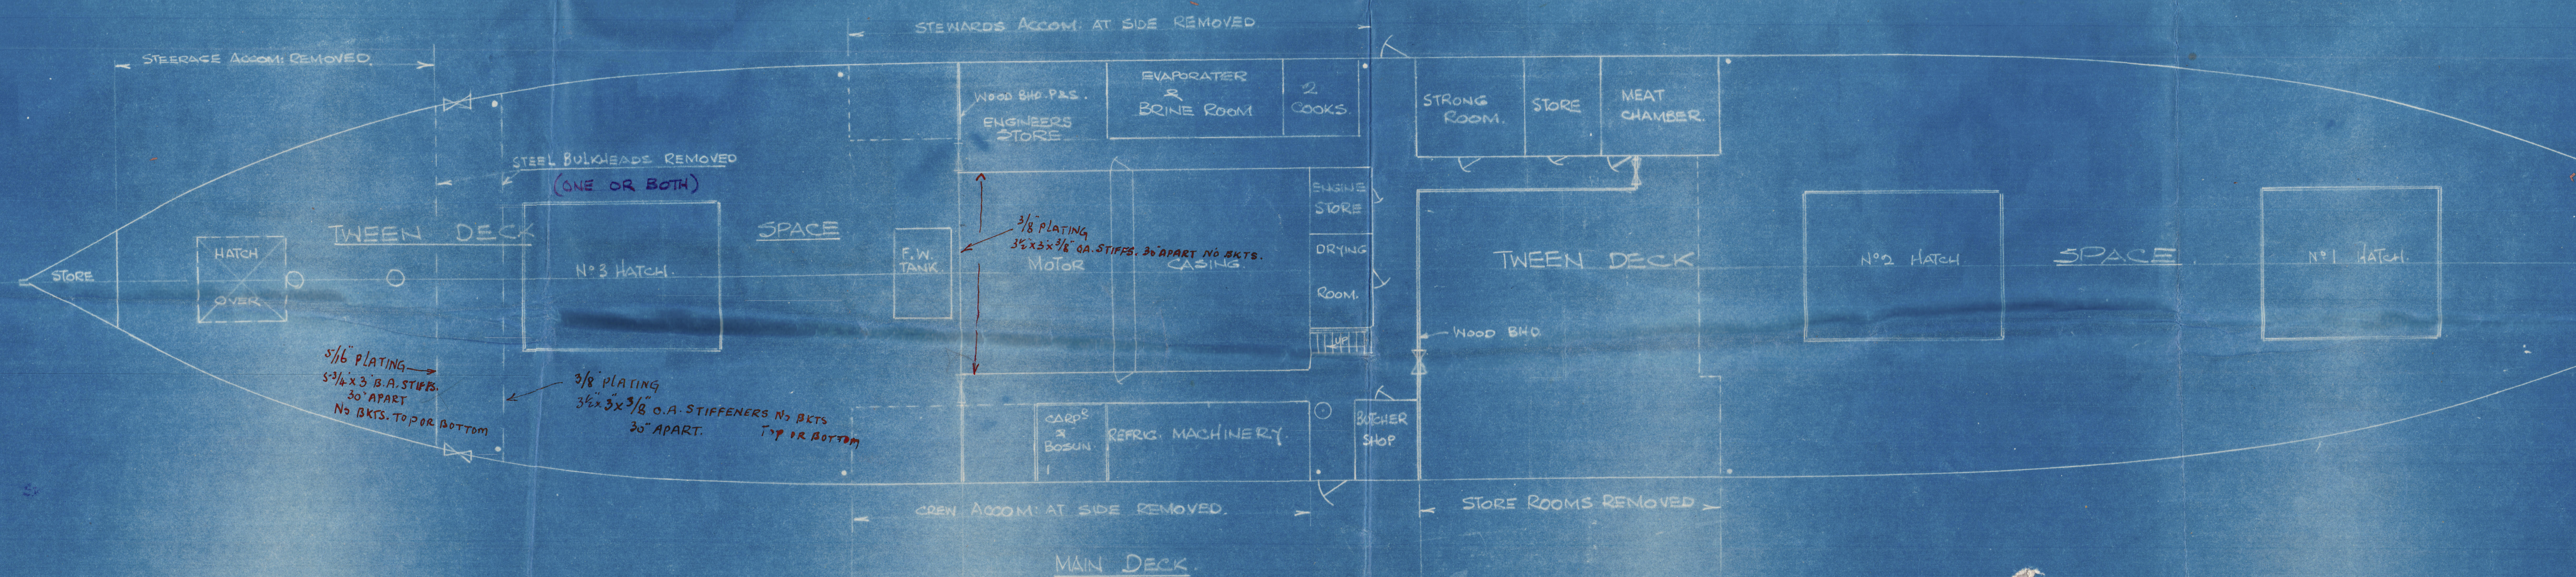
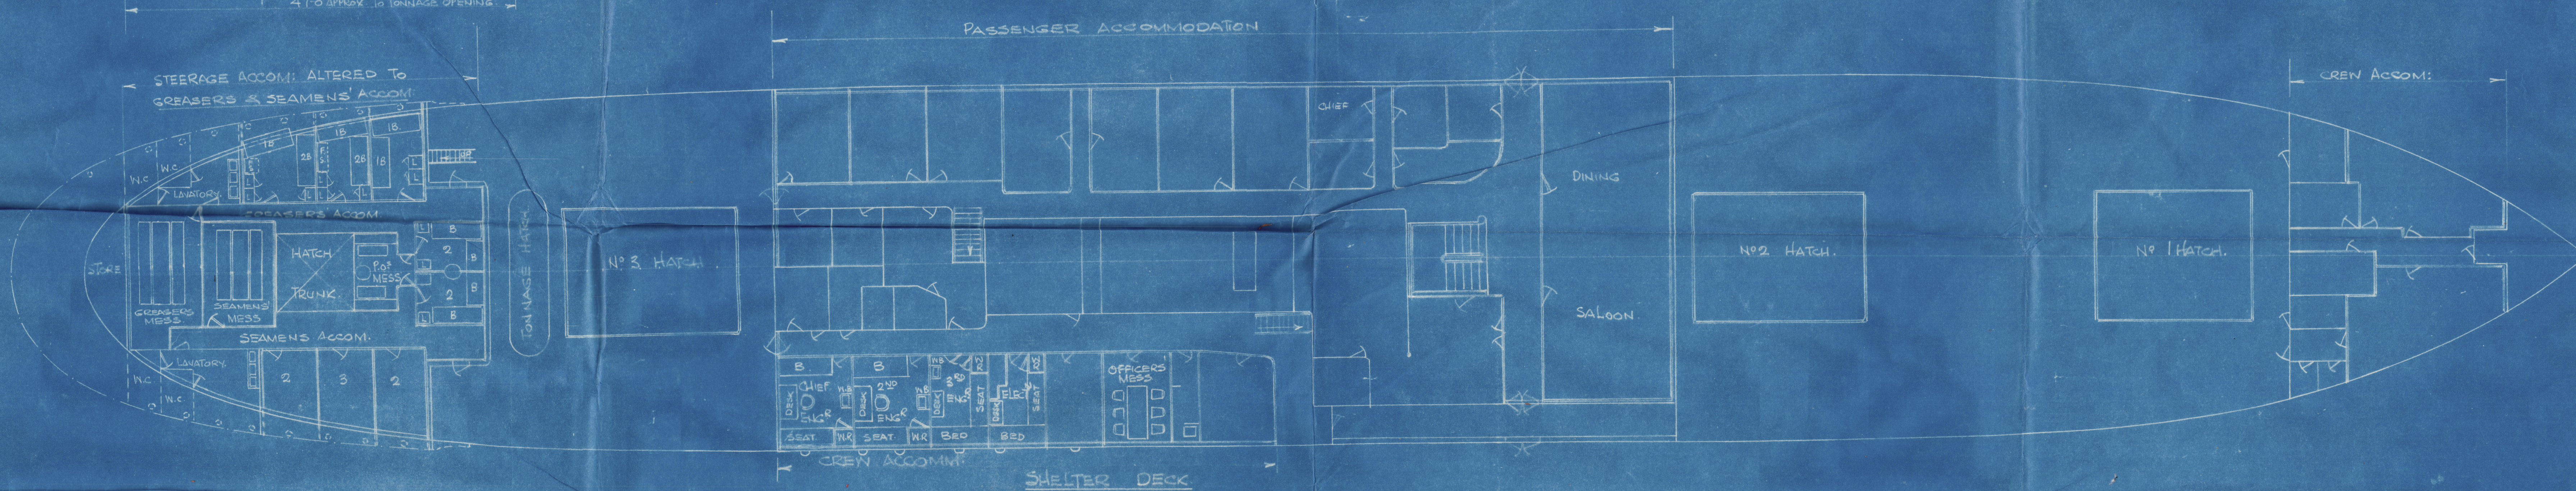


MY "CHIMU" & "CUMBA"

PROPOSED ALTERATIONS IN SHELTER TWEEN DECKS

Scale: - 1/100

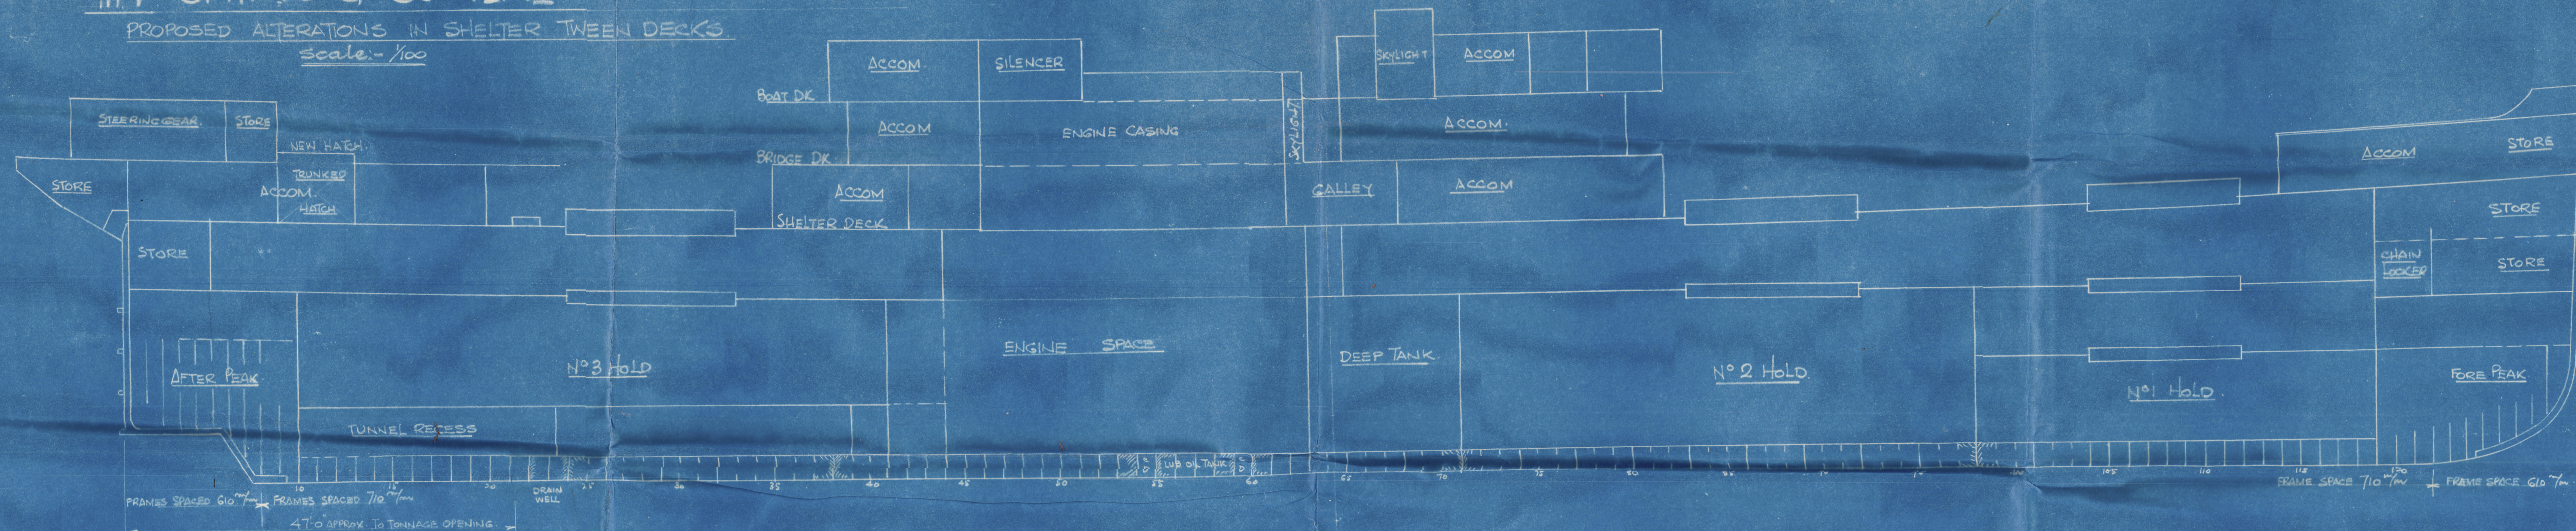

Lloyd's Register Foundation

(712 05 2011)
.....21st October.....19 37
HARLAND AND WOLFF, LIMITED,
LIVERPOOL.

THIS ENCLOSURE IS TO BE SENT TO

.....Messrs. Lloyd's Register of Shipping.....
.....

005840-005848-0064 1/2



© 2021

Lloyd's Register
Foundation