
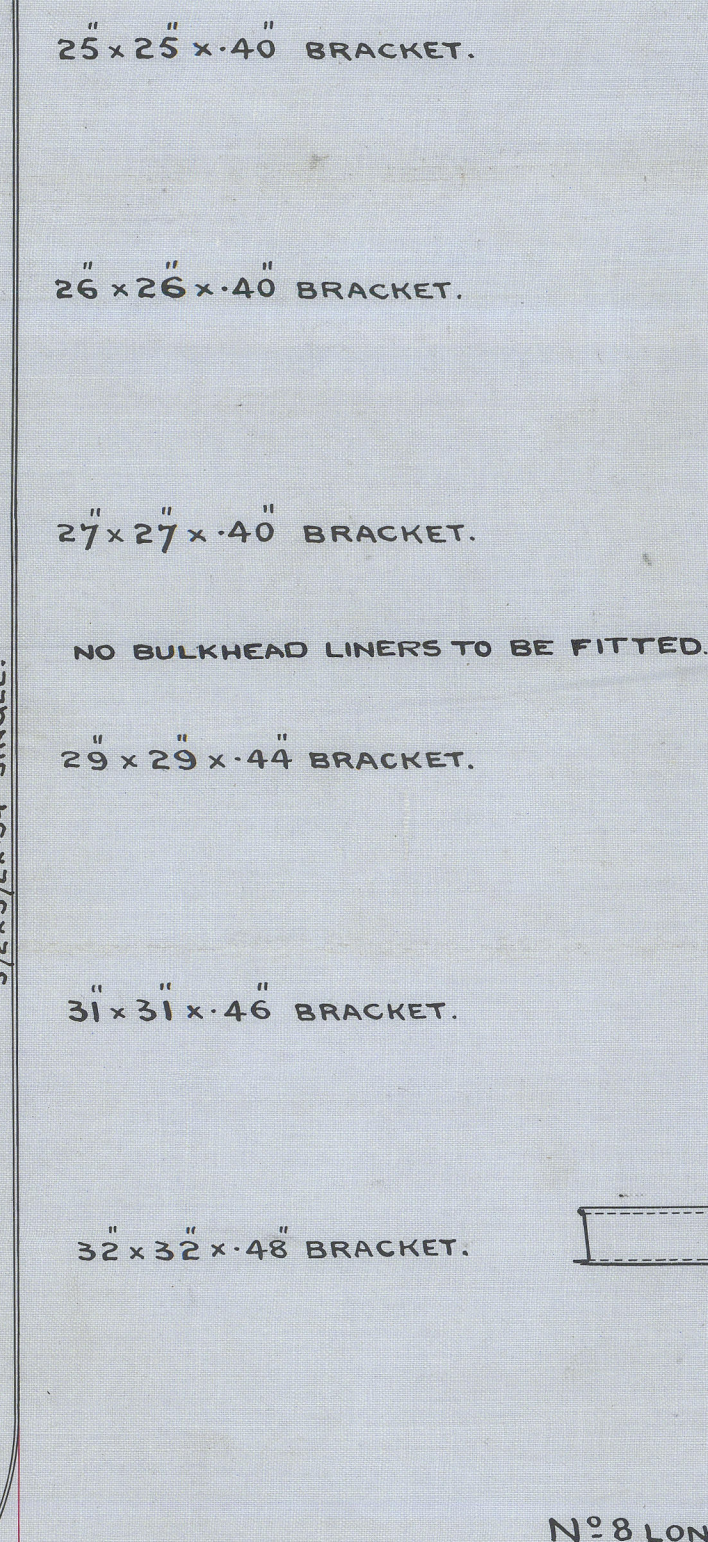
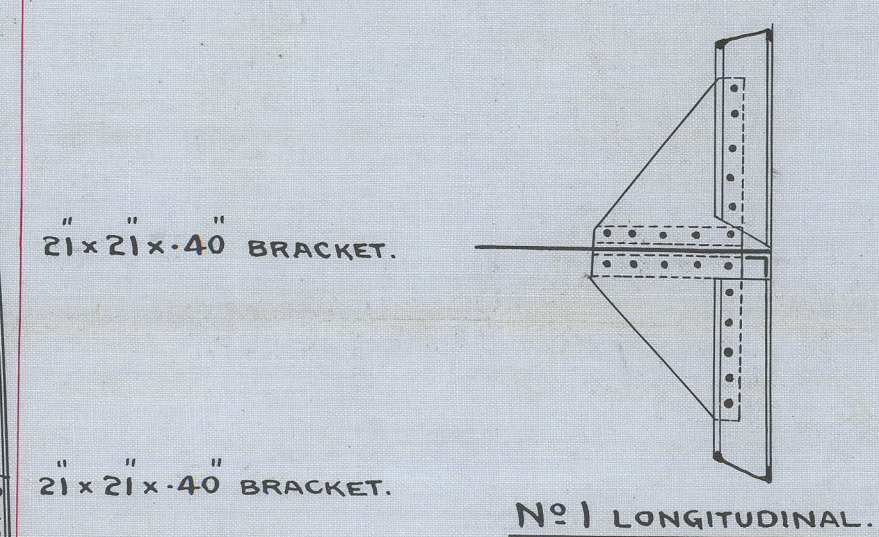
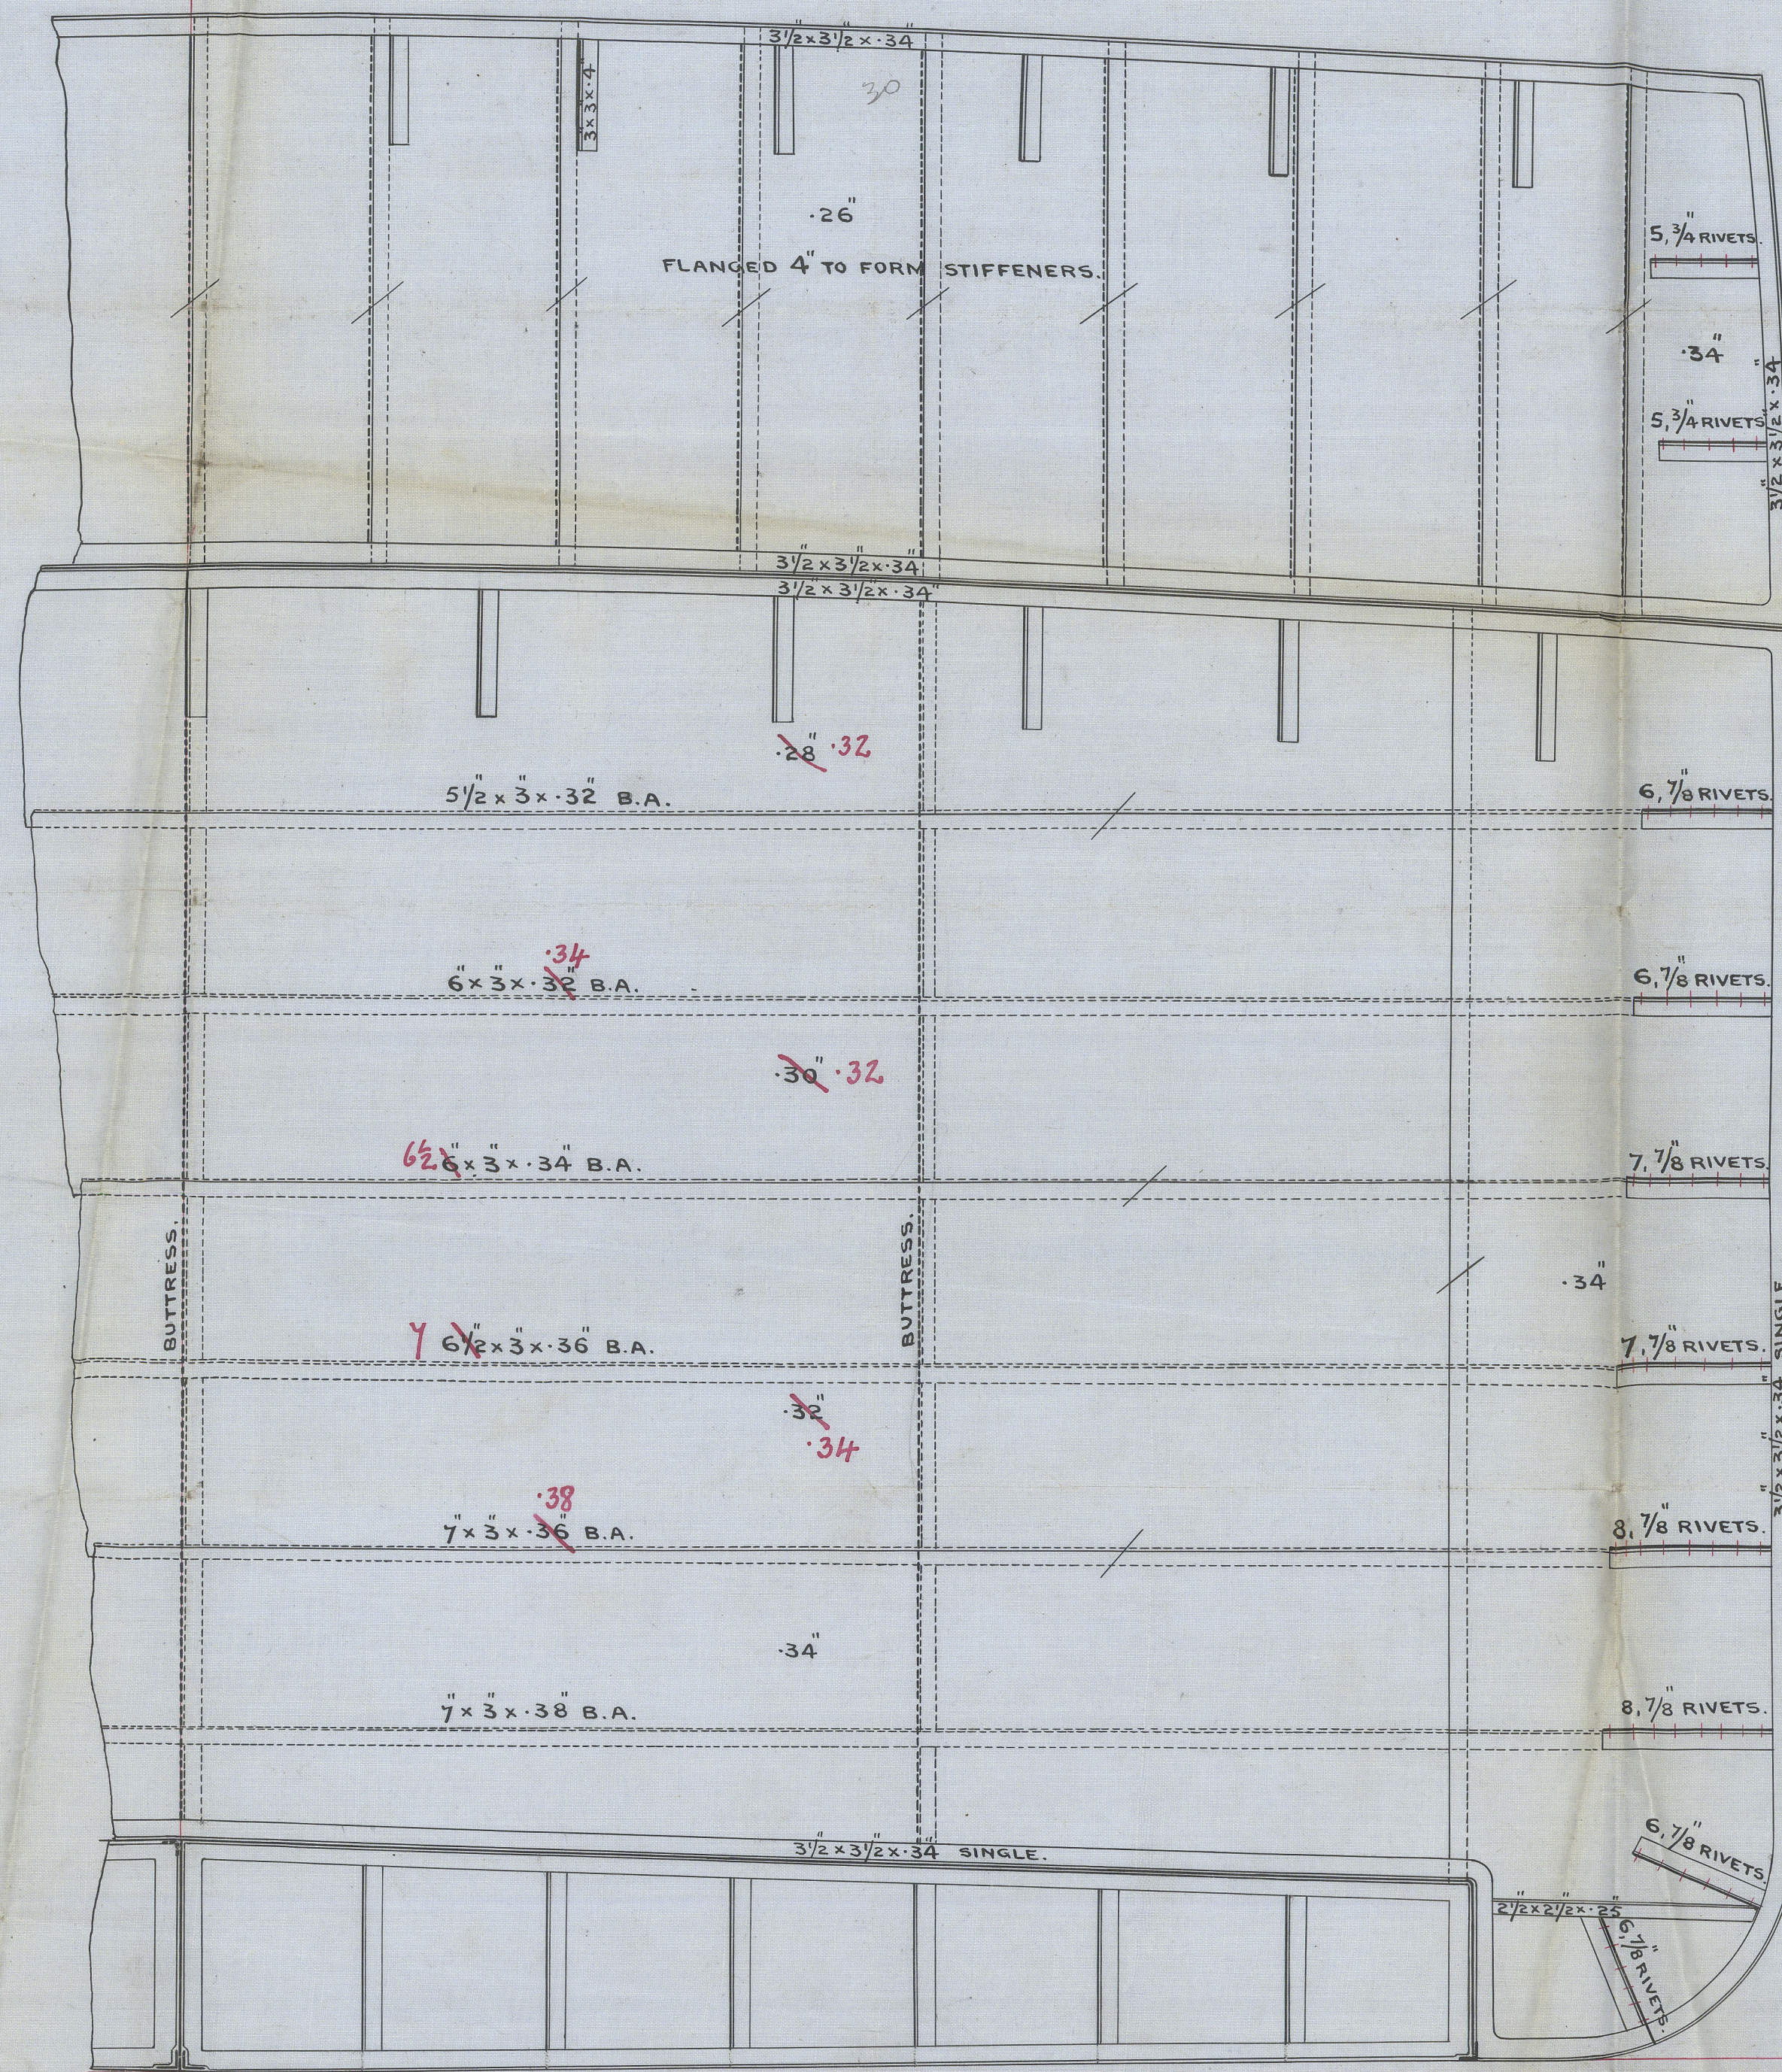


SCALE $\frac{1}{2}" = 1$ FOOT.

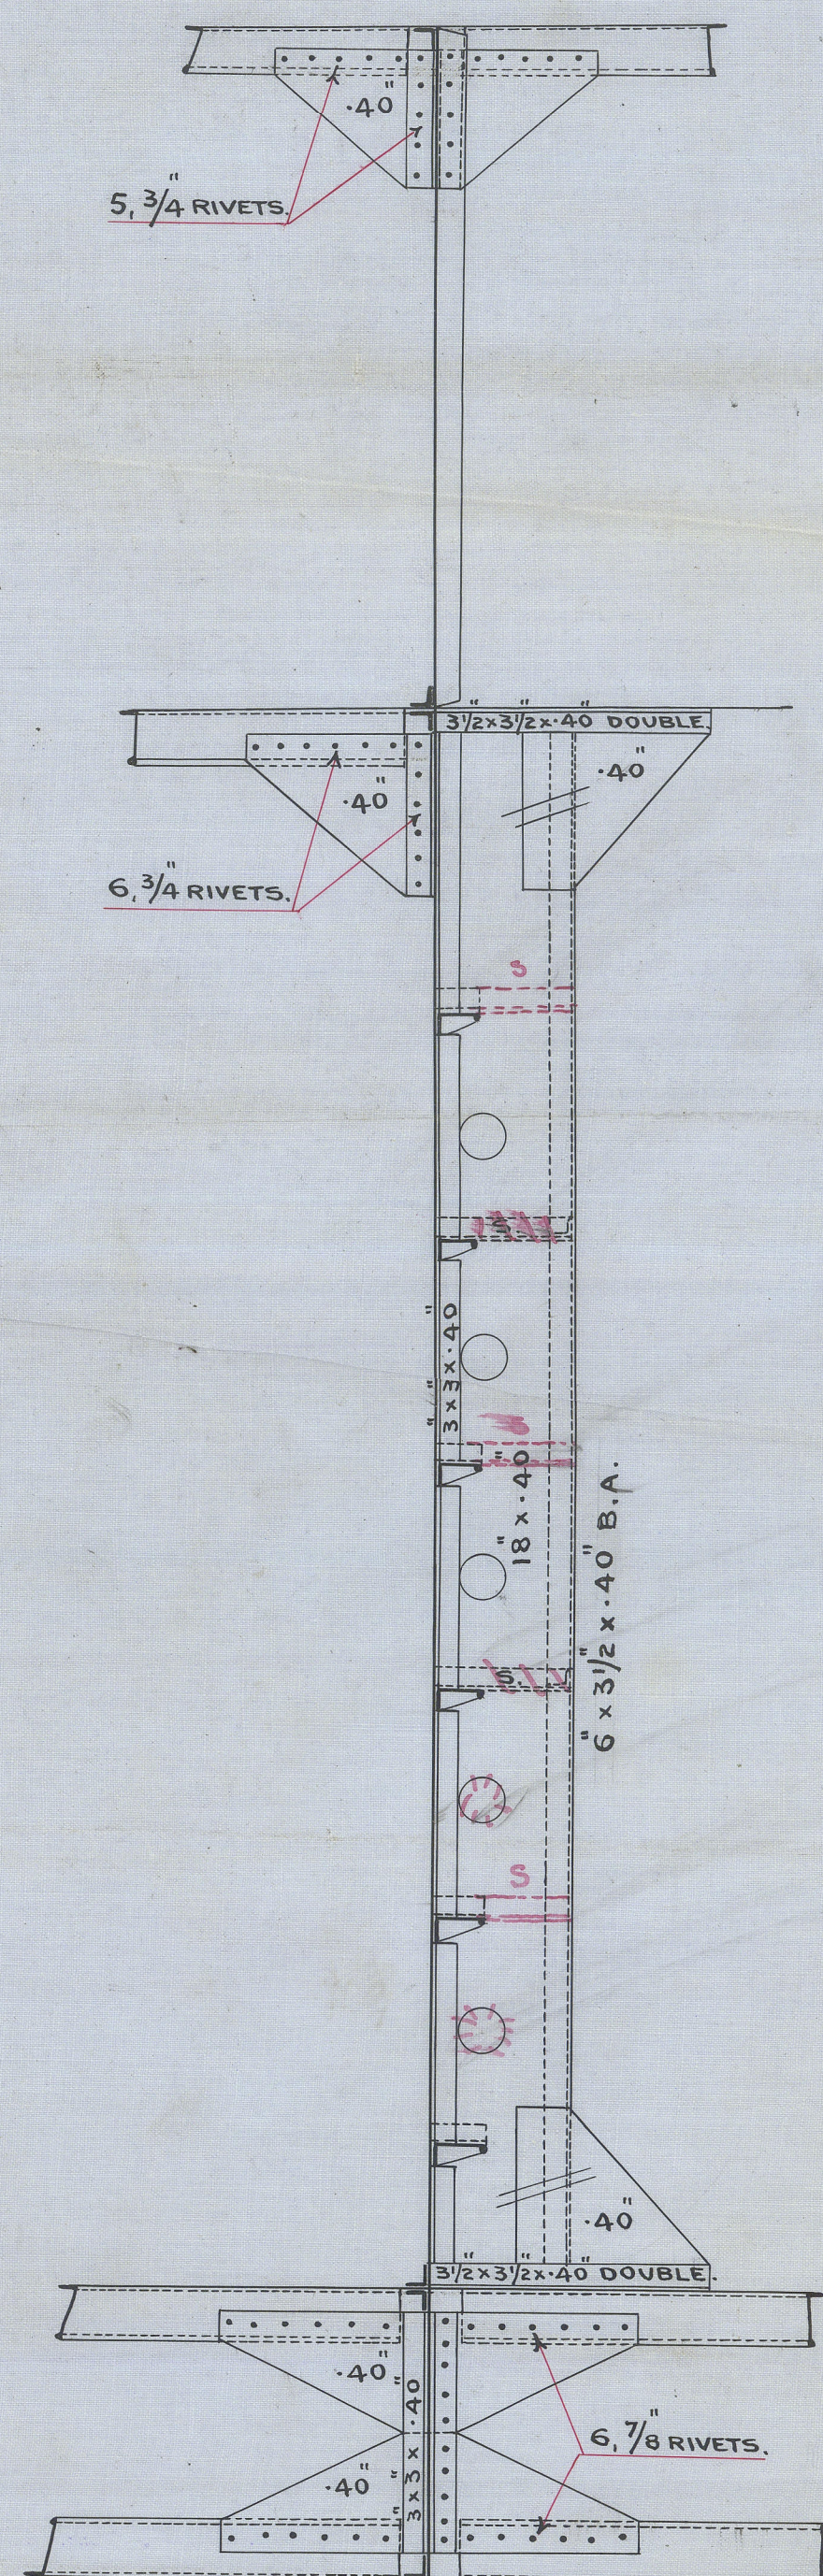

SIR W. G. ARMSTRONG, WHITWORTH & CO LIMITED
NEWCASTLE-UPON-TYNE.
NO 767 DATE 23-2-11
WALKER SHIPYARD.

Sir W. G. Armstrong
Whitworth & Co.

S.S. 839-840

Bulkhead plan


S.S. "CHO-SEN-MARU"
NEWCASTLE-ON-TYNE.

REPORT No 61221

S.S. "ANNAN MARU"
NEWCASTLE-ON-TYNE.

REPORT No 61348

005861-005869-0034

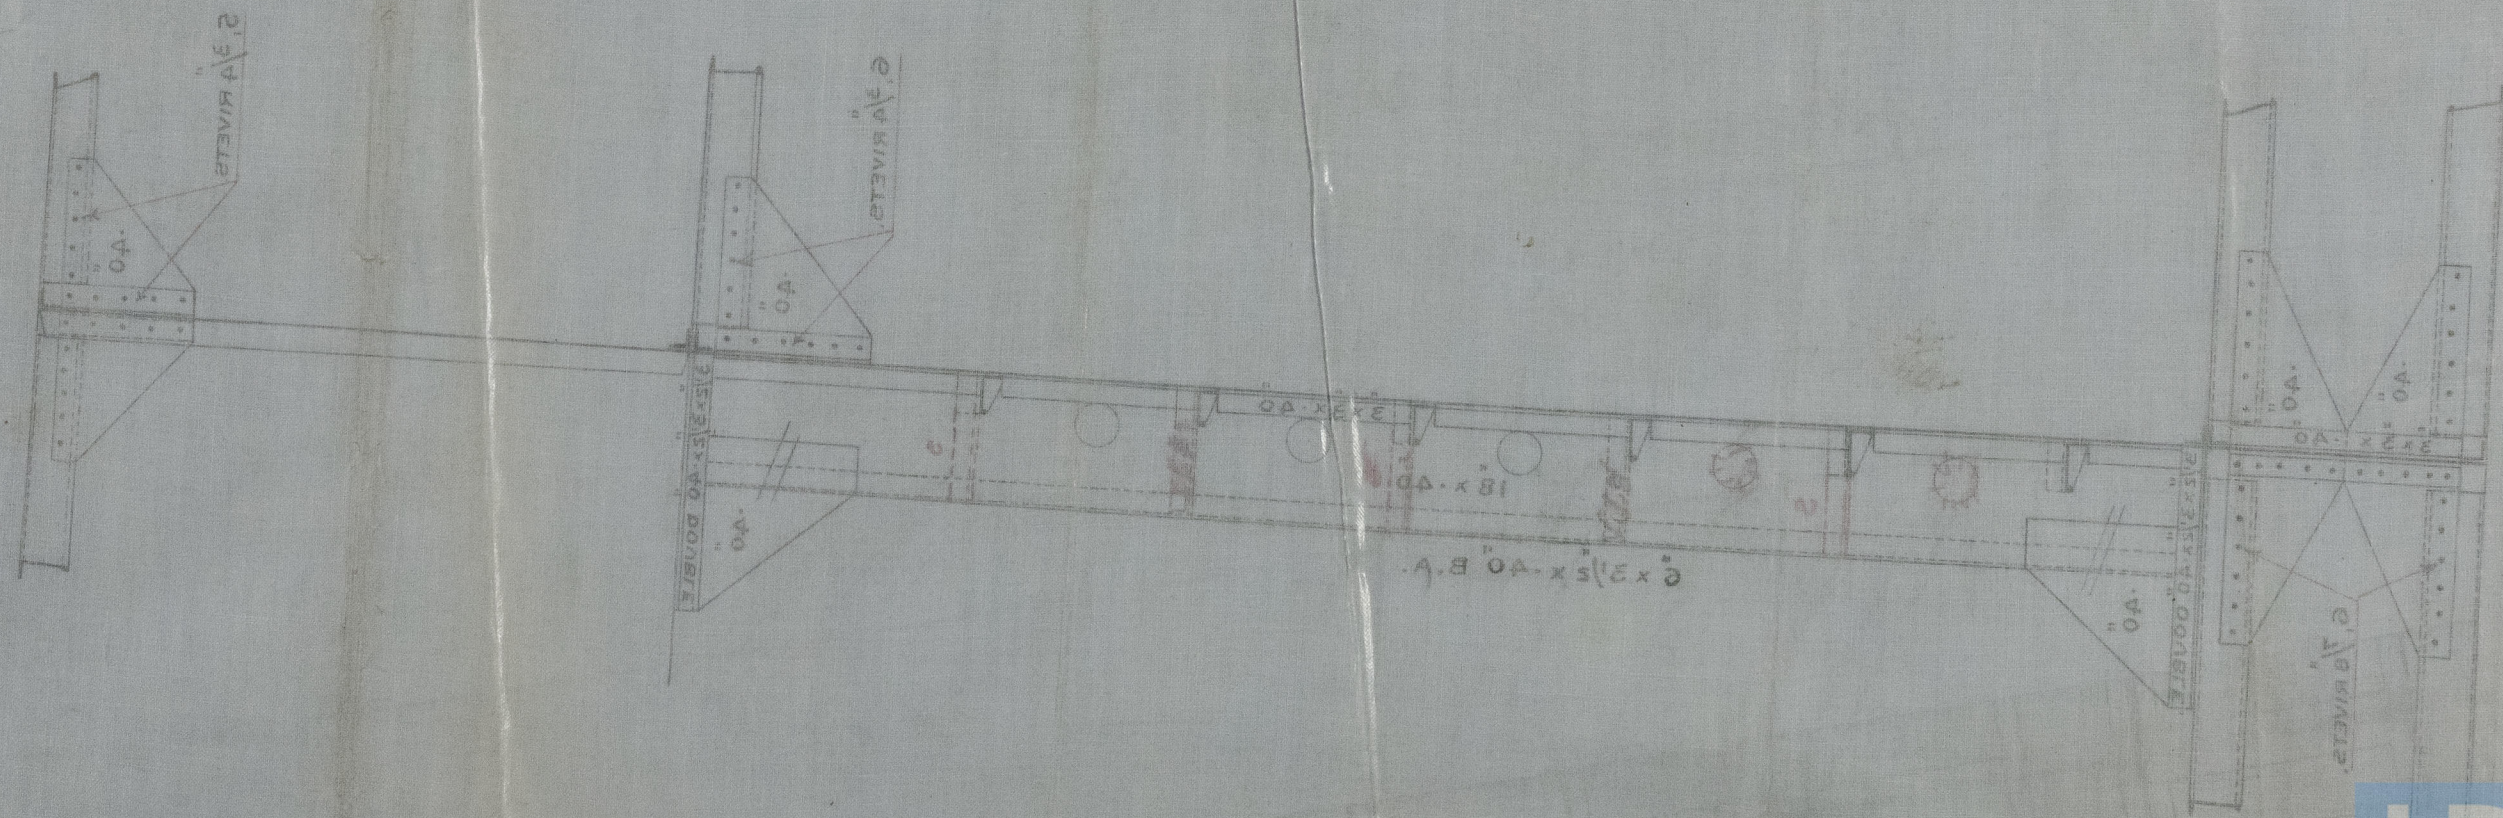

© 2020

Lloyd's Register
Foundation