

27.10.10.
14.11.10

PROFILE & DECK PLAN


STEEL SCREW TRAWLERS

N^{OS}. 480-1


DIM^S - 126'-8" x 22'-0" M^{LD}. x 12'-6" M^{LD}.

SCALE 1/4" = 1 FOOT.

PLAN No 1721
FOR ENCLOSURE OF
Messrs Lloyd's Surveyors
Hull
COCHRANE & SONS
SHIPBUILDERS, Ltd.
DATE 23/10/10 RH

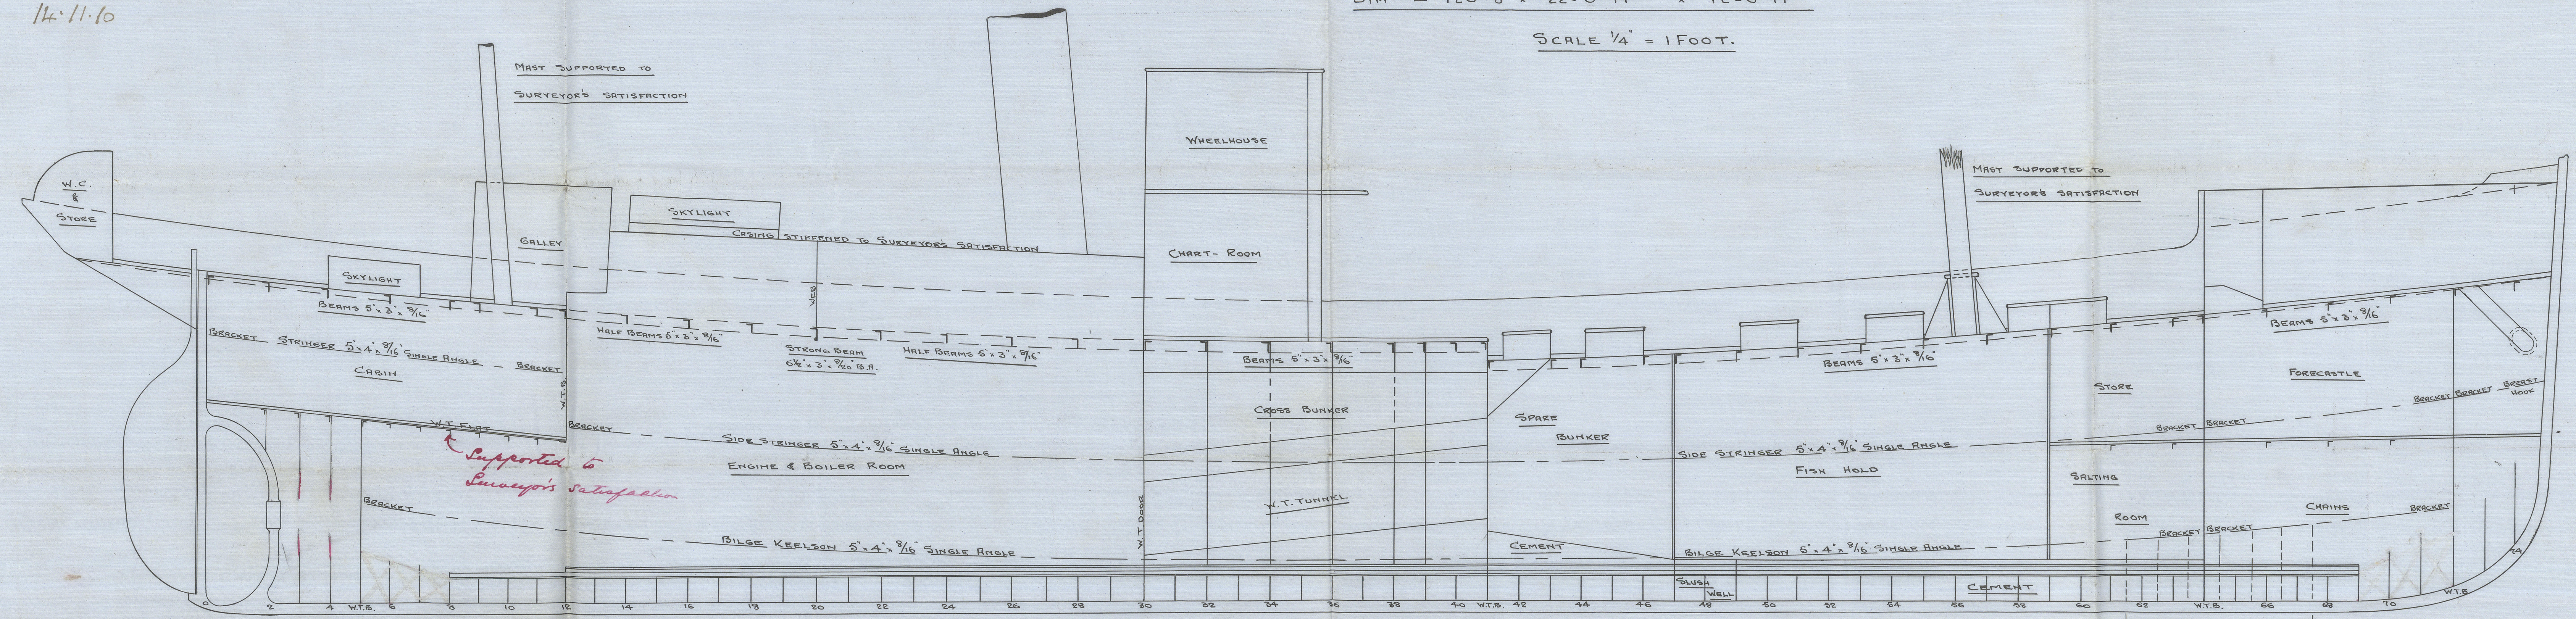

PILLARS THROUGHOUT TO SURVEYOR'S SATISFACTION

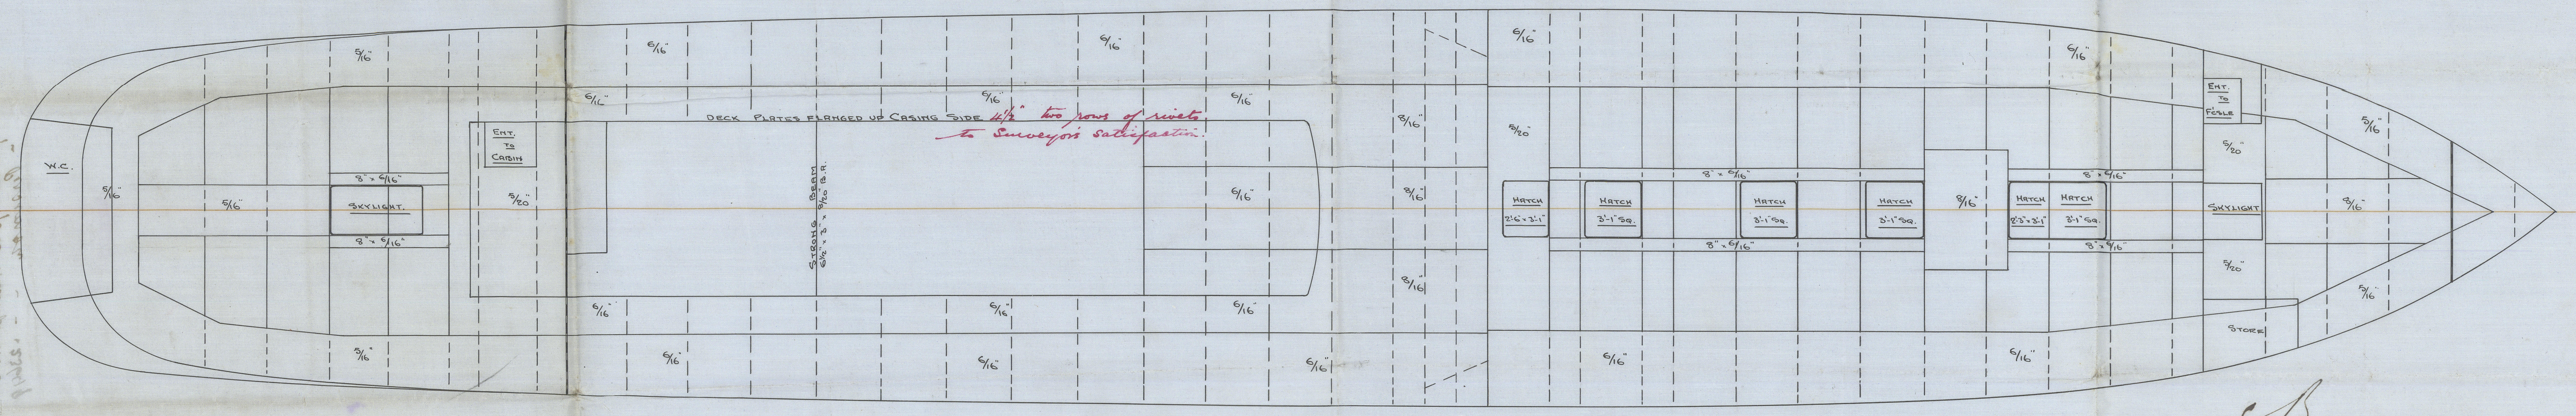


C.B.
27.10.10.

COCHRANE & SONS
SHIPBUILDERS, Ltd.
HULL
27.10.10.

Profile & Deck Plan -
Cochrane & Sons

Nos 480 & 481

Sp. Hull Gow Hull Rpt No. 23600
- Persimon - - 23649

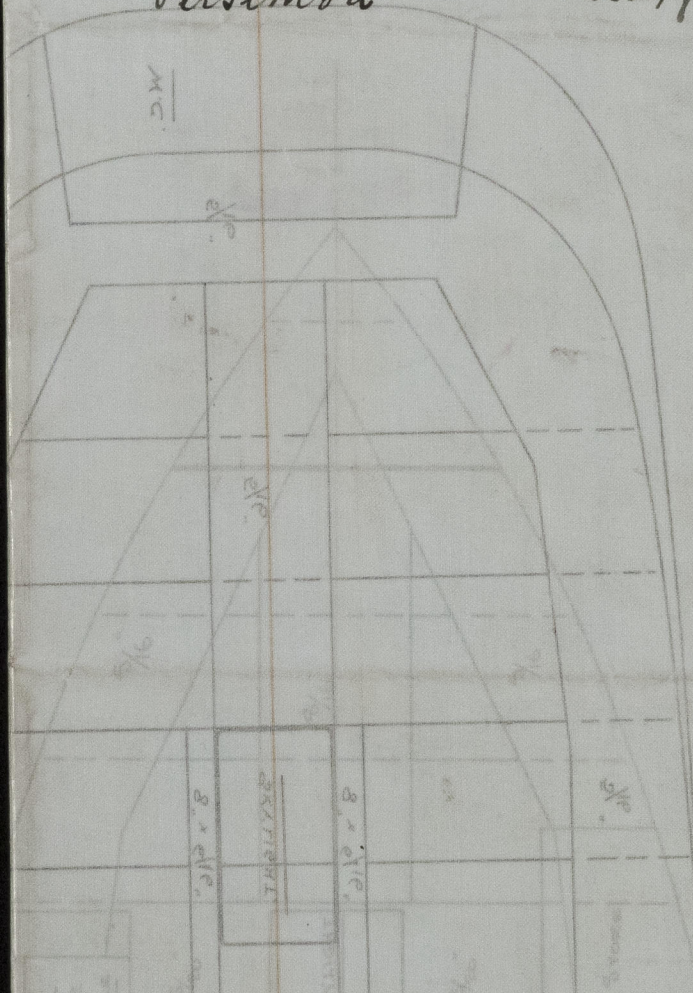

© 2020

Lloyd's Register
Foundation