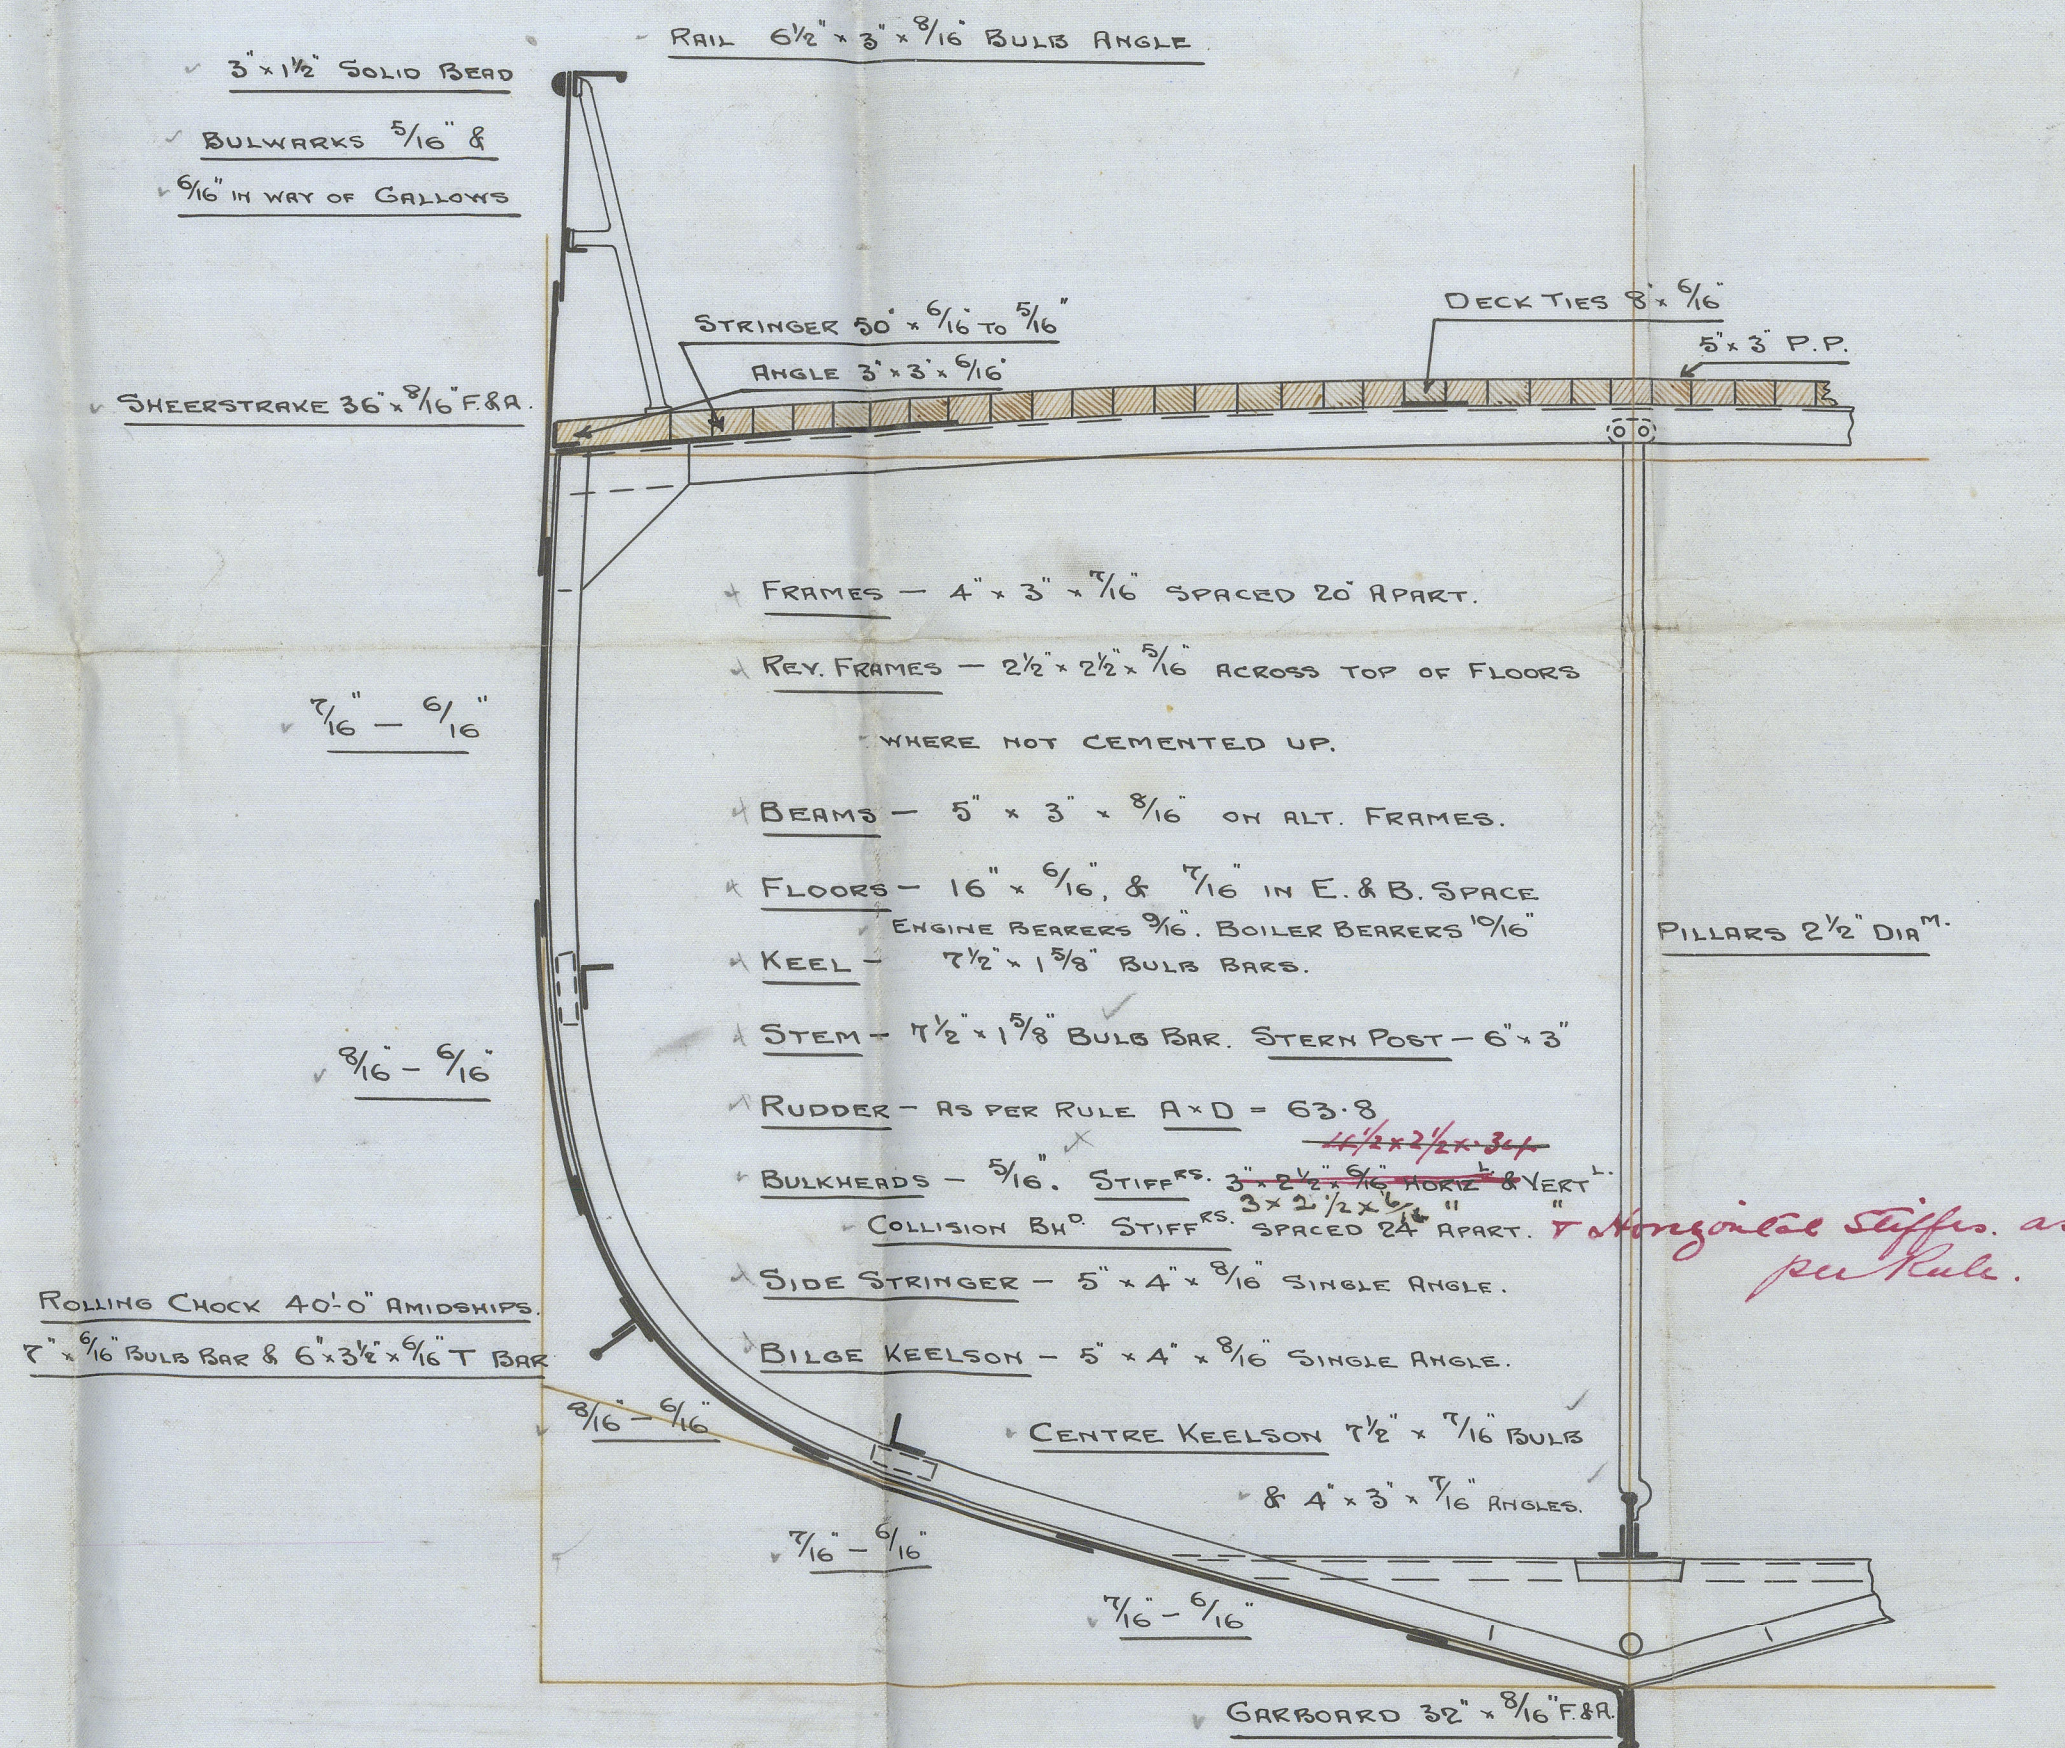


SCALE $\frac{1}{2}" = 1 \text{ FOOT}$

14.11.10

PLAN No. 9920
FOR ENCLOSURE TO
Messrs Lloyd's Surveyors
Hall
OCHOCHRANE & SONS,
SHIPBUILDERS, 85, BY
DATE 22/10/10 R.H.

✓ TO CLASS 100.A.1. FOR FISHING PURPOSES. DECK PLATED OVER
✓ IN WAY OF MACHINERY SPACE. ENGINE & BOILER CASING AS
✓ PREVIOUSLY APPROVED.


$$B + D = 34.5$$
$$L \times (B + D) = 4369.77$$
$$\sqrt{\frac{L}{D}} = 10.04$$
$$\sqrt{\frac{L}{B}} = 5.75$$

✓ 1ST. BOWER ANCHOR	5½ CWTSEX	STOCK OR 7 CWTSEX	STOCKLESS
✓ 2ND " "	5	" "	6¼" "
✓ KEDGE ANCHOR	2¾	" "	"
✓ 105 FATHOMS	1¼"	CABLE	
✓ 60 "	6"	HAWSER	
✓ 60 "	4½"	WARP	

- ✓ BUTTS OF SHELL PLATING LAPPED & DOUBLE RIVETED
- ✓ EXCEPT GARBOARD, SHEERSTRAKE & STRAKE NEXT TO
- ✓ SHEERSTRAKE, WHICH ARE TO BE STRAPPED AND DOUBLE
- ✓ RIVETED. LANDINGS DOUBLE RIVETED EXCEPT TOP EDGE
- ✓ OF SHEERSTRAKE, WHICH IS TO BE SINGLE RIVETED.
- ✓ BUTTS OF STRINGER PLATE OVERLAPPED & DOUBLE RIVETED.

C.B.
27.10.10.

1891 x 084 001
005861-005869-0112

- Midship Section -
Cochrane & Sons

Nos 480 & 481

1/2 Neil Gow Hull Rpt 2 23600
- Person . . . 23649

005861-005869-0112

4X MVB
2 NMBK
1X CMT
2X
2X CMT 2X STOCK

EQUIPMENT



© 2020

Lloyd's Register
Foundation

PROPORTIONS