

100-100-205
100-100-205

324

Messrs Lloyds Surveyors
Hall



12/5/11

RR

Nos 505-6-7

SCALE $\frac{1}{4}" = 1 \text{ FOOT}$

PILLARS TO SURVEYOR'S SATISFACTION

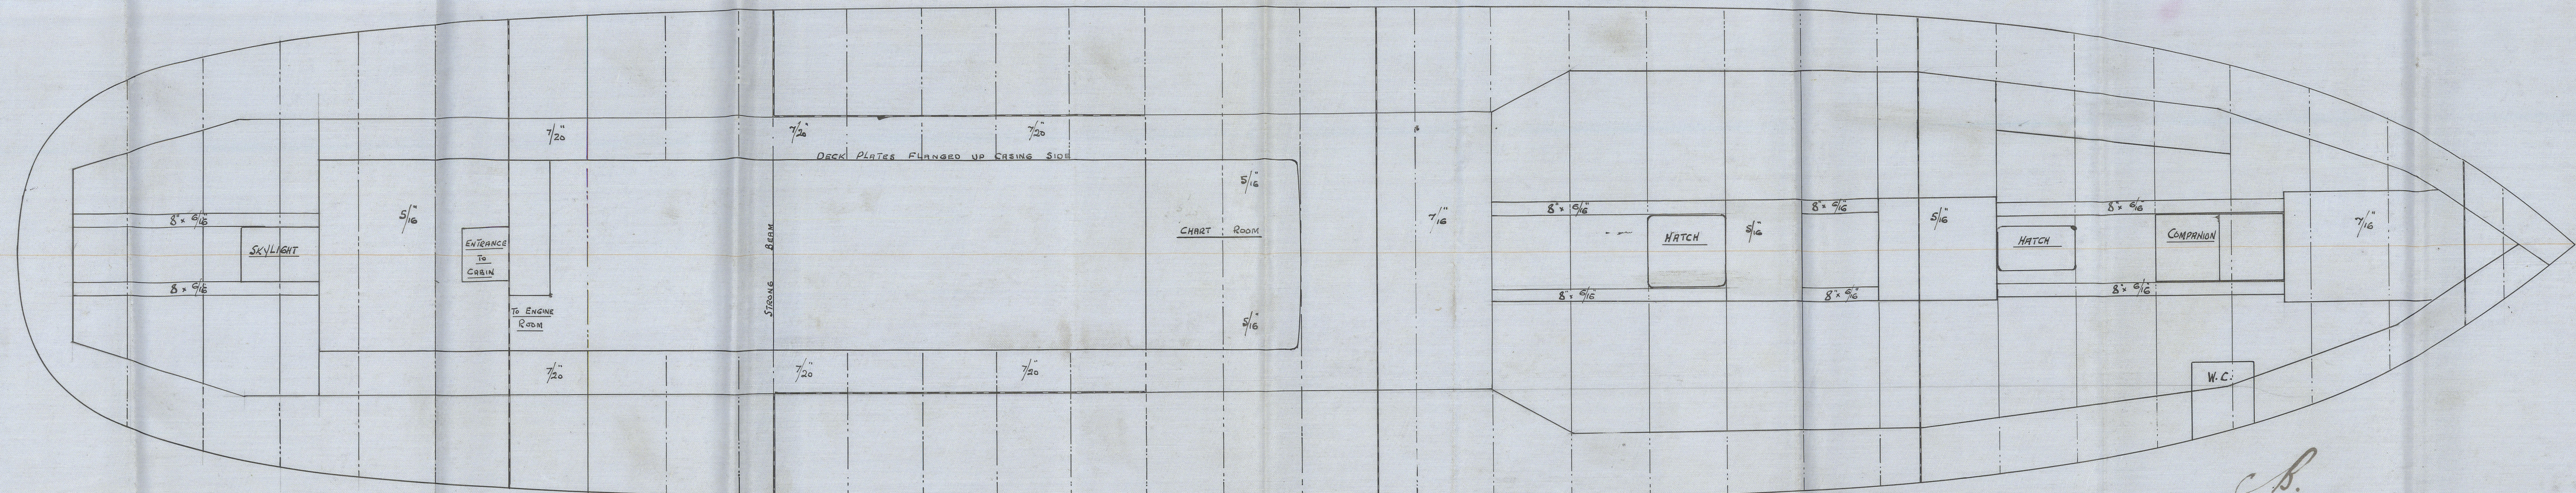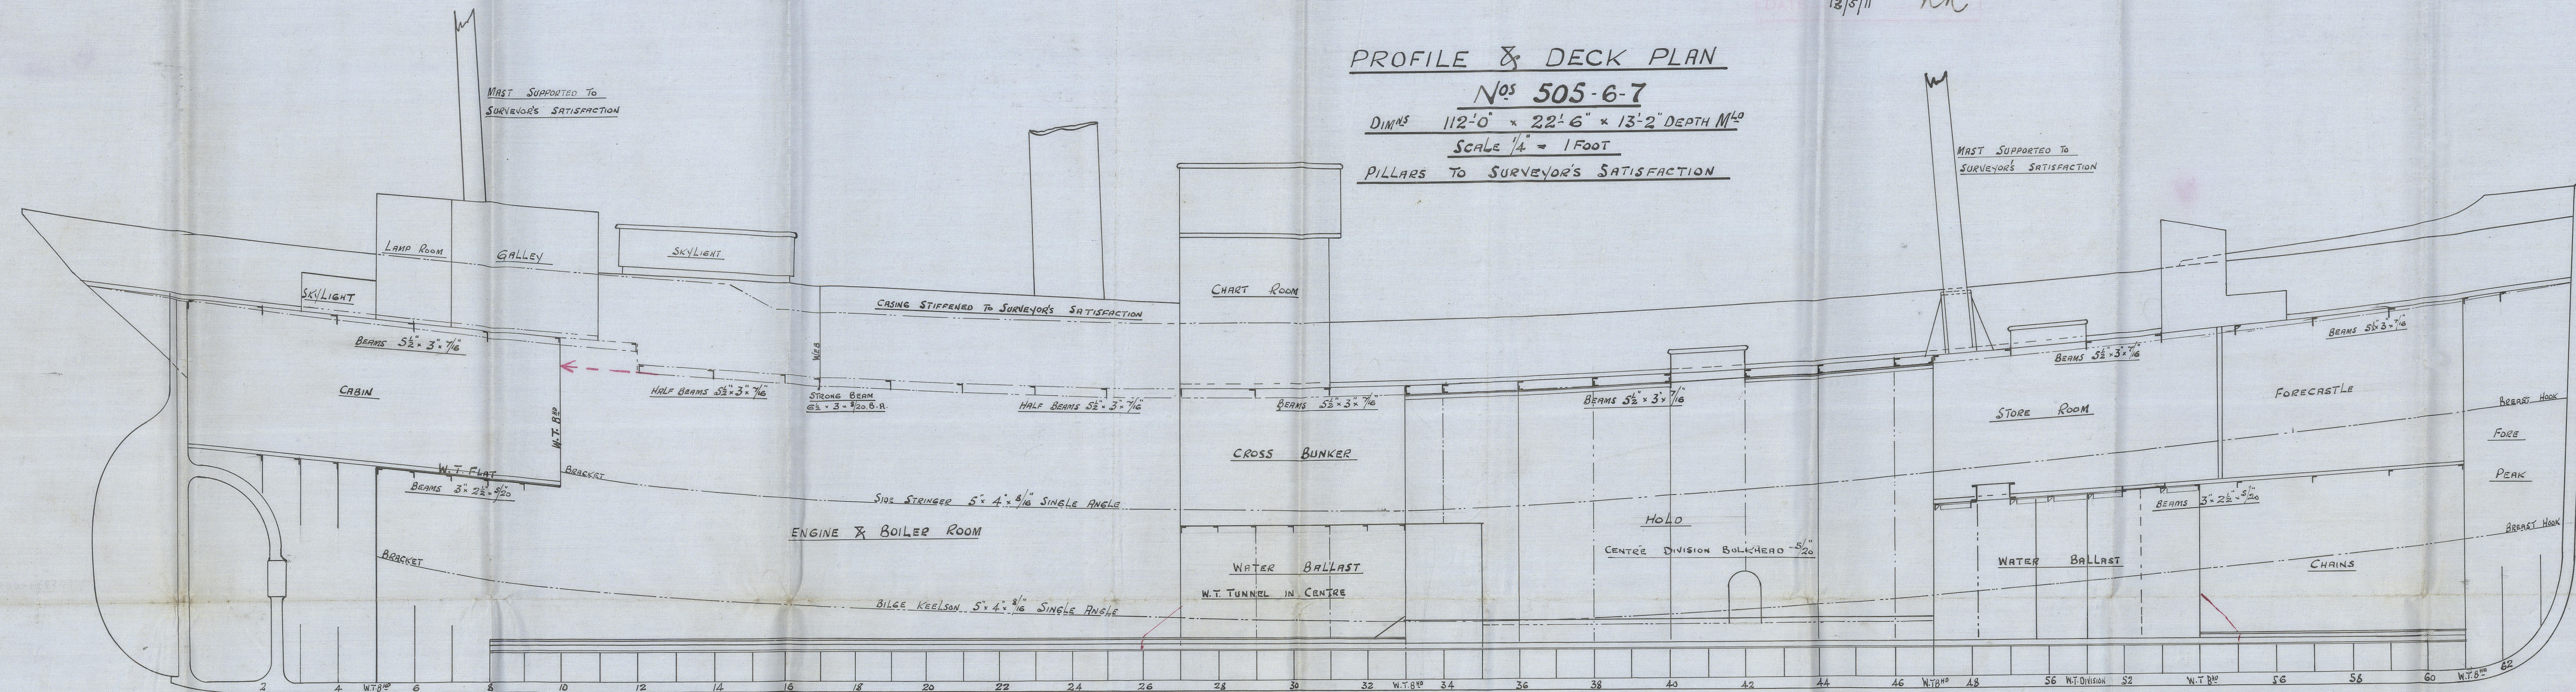

C.B.
19.5.11.

Cochran & Sons

No 505-506-507

Profile & Deck

1/2 Bealeshill Hull Rpt No! 24521

• Emley " " "

• Epworth " " "

11.3.91



© 2020

Lloyd's Register
Foundation