

19.5.11
27.5.11

505-6-7

Midship Section

MIDSHIP SECTION

STEEL SCREW FLEETERS


N^{OS} 505-6-7

DIMNS 112'-0" x 22'-6" EX. x 13'-2" DEPTH M^{LO}
SCALE 1/2" = 1 FOOT

TO CLASS 100.A.1. LLOYDS

DECK PLATED OVER IN WAY OF MACHINERY SPACE
ENGINE & BOILER CASING AS PREVIOUSLY APPROVED

323
Messrs Lloyds Surveyors
Hull
13/5/11 RK

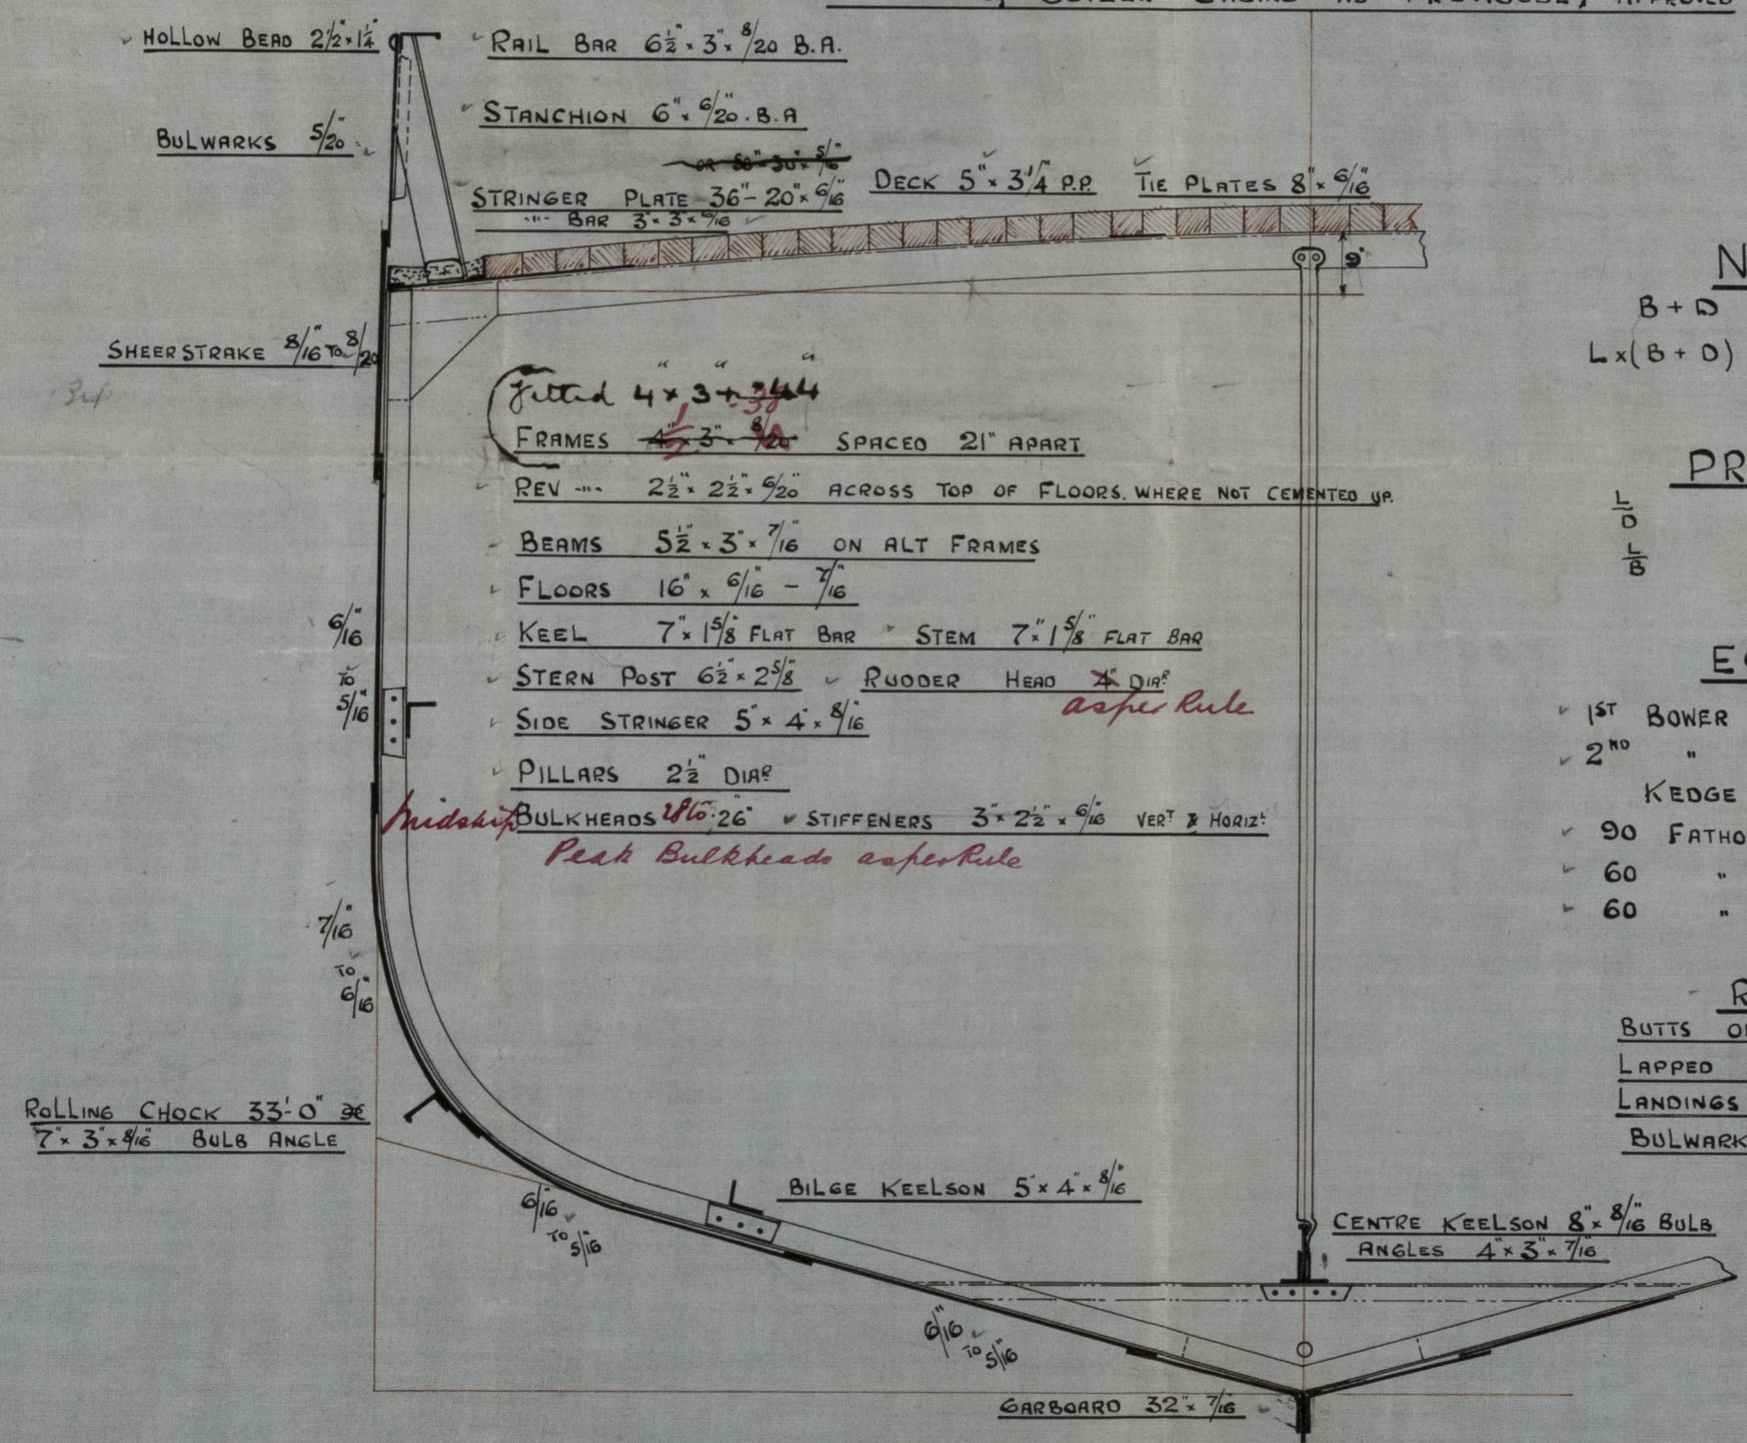

NUMERALS

B + D 35.52 ✓
L x (B + D) 3978.24 ✓

PROPORTIONS

L/D - 8.35 ✓
L/B - 5.0 ✓

EQUIPMENT

1ST BOWER ANCHOR = 5 CWTs EX STOCK OR 6 1/4 CWTs STOCKLESS
2ND " " = 4 1/2 " " " 5 1/2 " " "
KEDGE " = 2 1/2 " " "
90 FATHOMS " 1" CABLE
60 " 5 1/2" HAWSER
60 " 4 WARP

RIVETING

BUTTS OF SHELL PLATING
LAPPED & DOUBLE RIVETED
LANDINGS DOUBLE RIVETED
BULWARKS SINGLE RIVETED

C.B.
19.5.11.

32

Cochran & Sons.

Nos 505-506-507.

Midship Section.

1/2 Eccleshill Hull Rpt No: 24521

• Emley

• Epworth

323

11.2.11

11.2.11


















© 2020

Lloyd's Register
Foundation

8500-188500-LE8500