


6. 11. 01

Sailing Ship N^o 192


Rudder


Scale 1/10

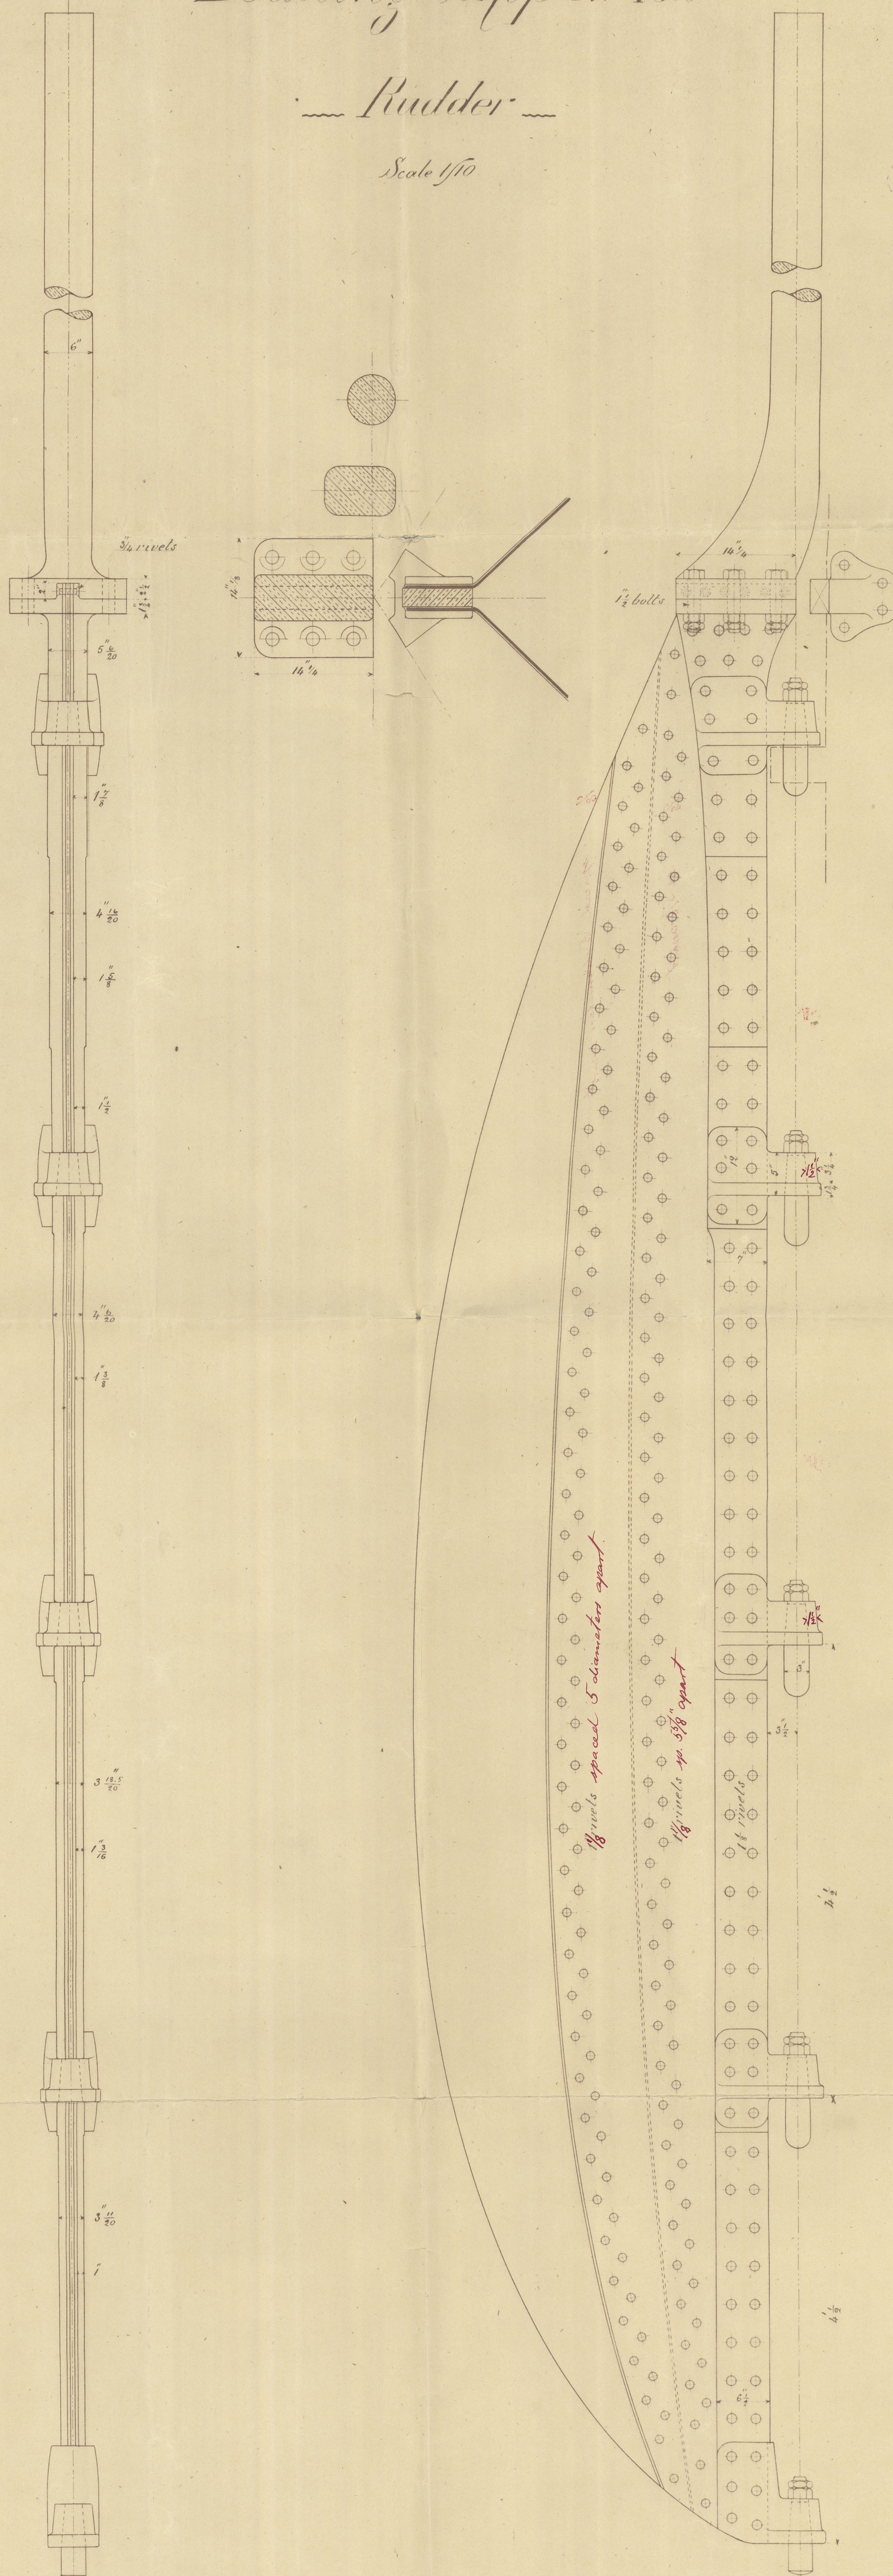

18479
30-X-901


J.P.
6/11/01

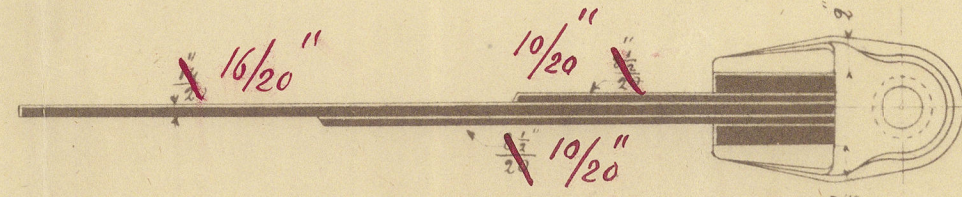

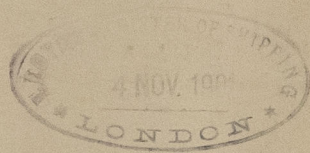

Paid for orders
ship to 19.2
Genoa

11/10/01

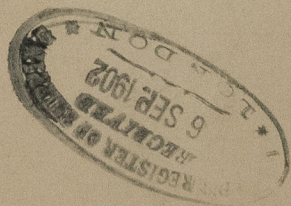

005877-005889-0219

Budder Meer.
"Antonio Padre"
Gen. No 2639.



© 2020

Lloyd's Register
Foundation