
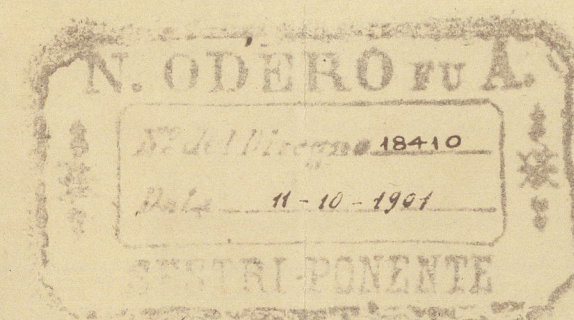
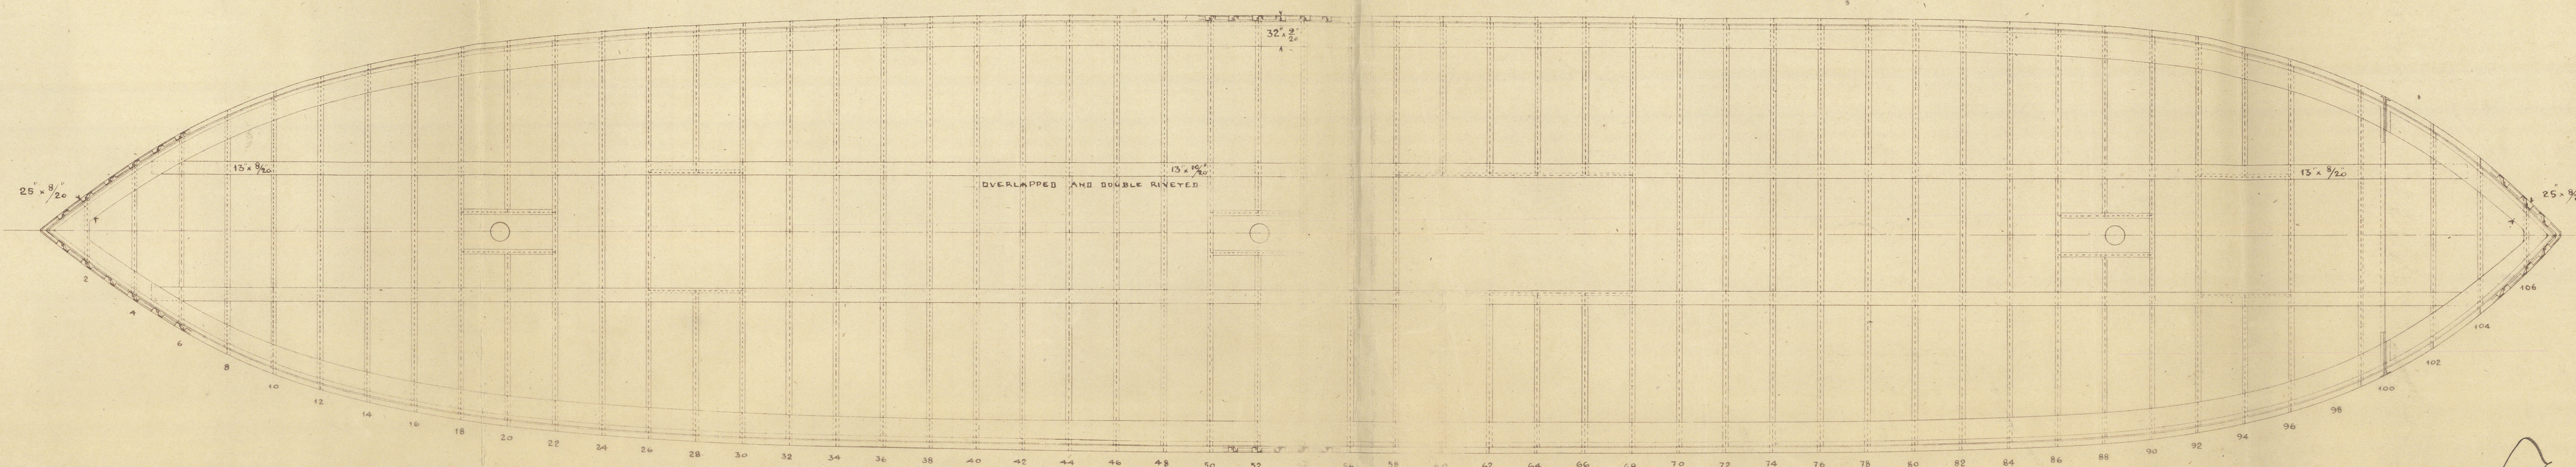
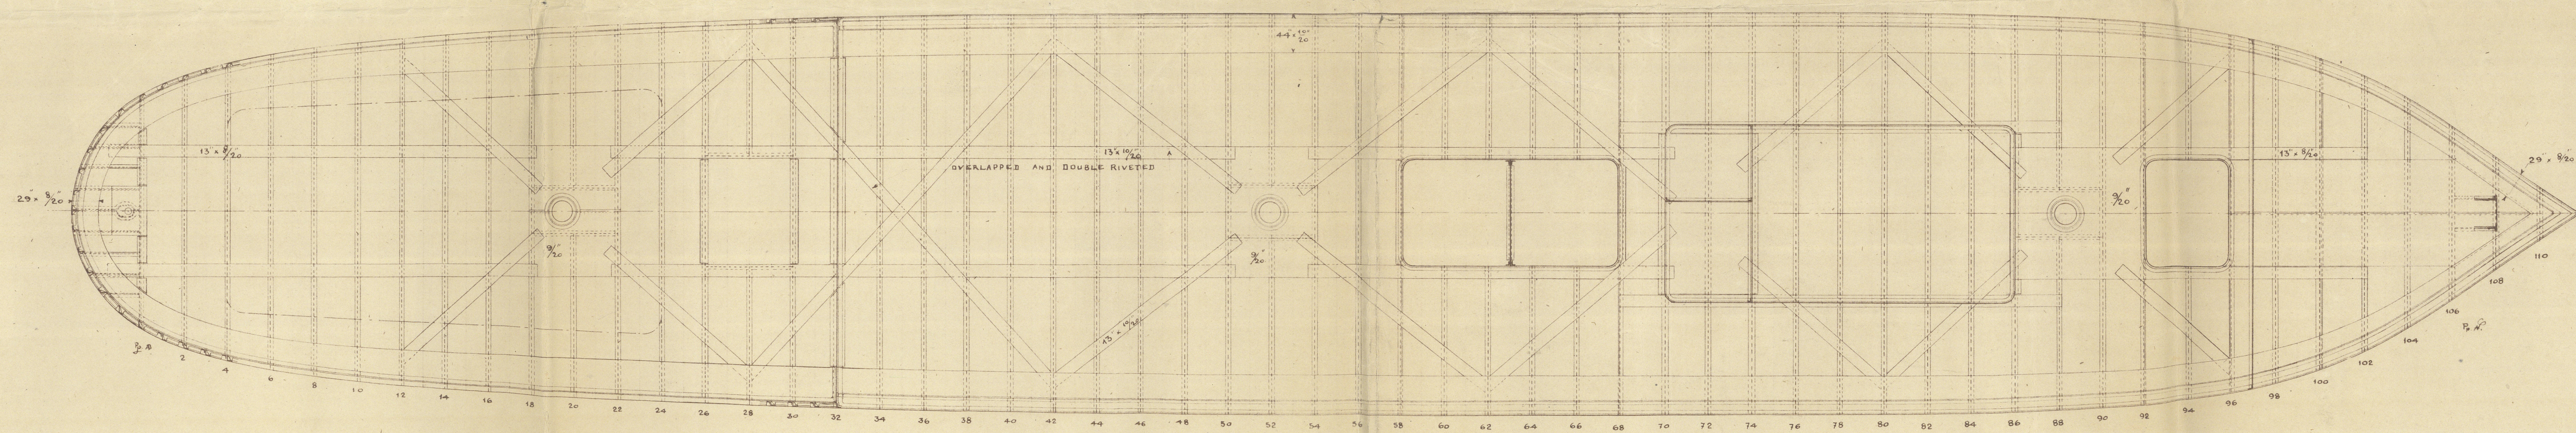
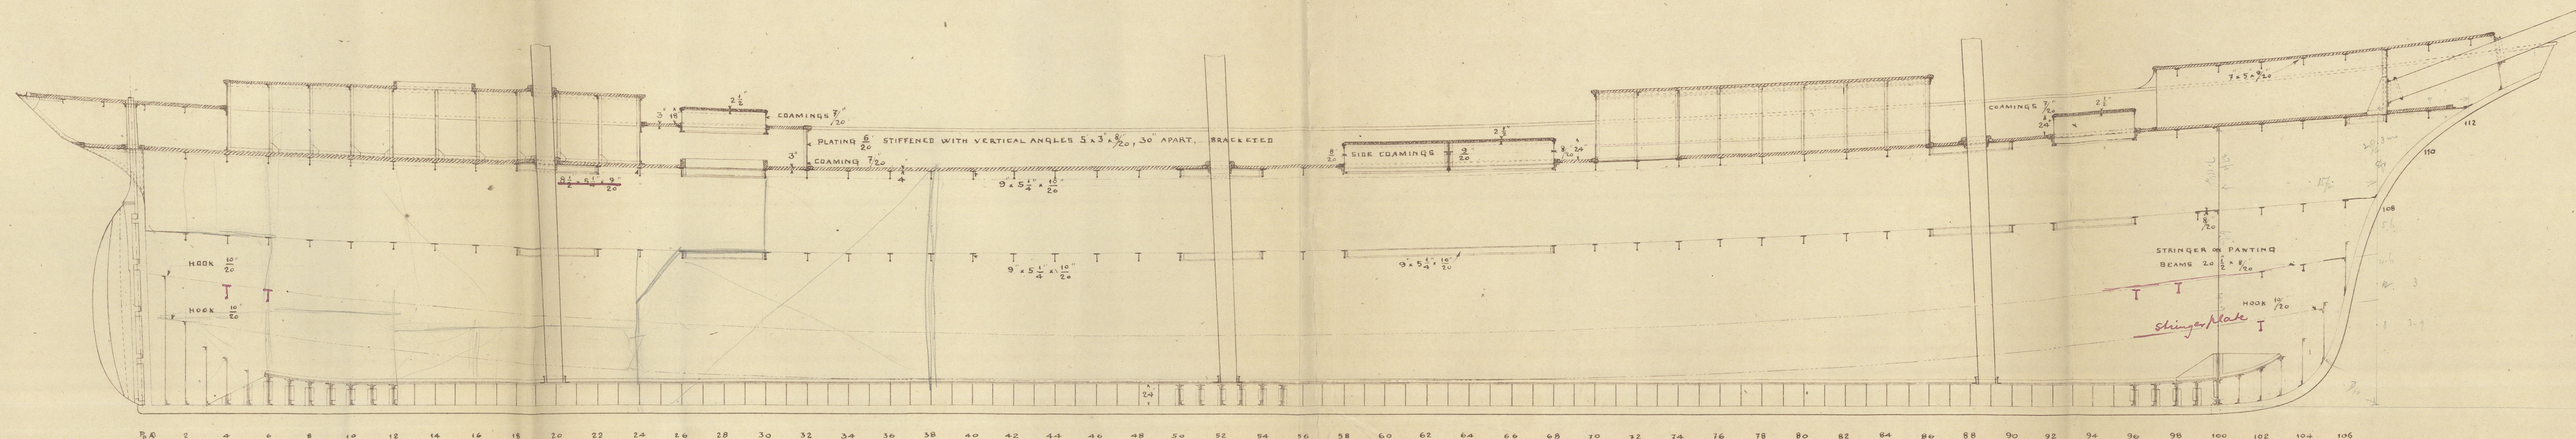
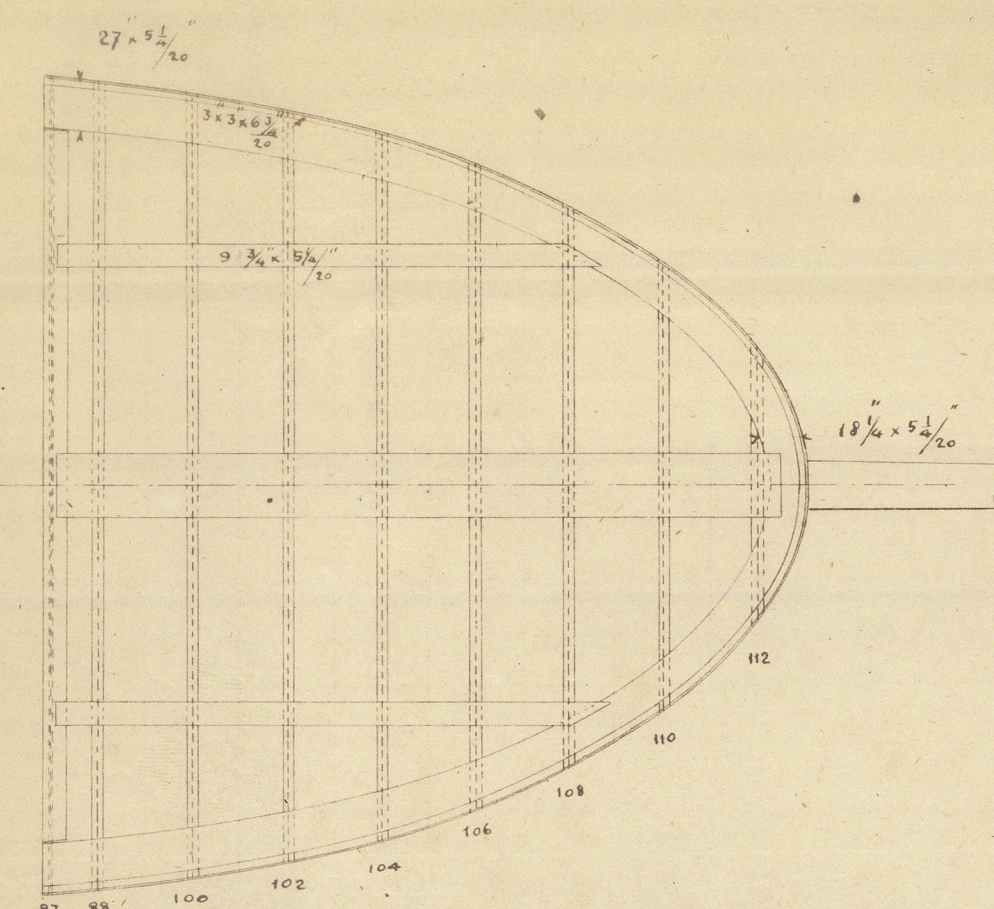


15-10-01

# Sailing Ship 192.

218',96 x 37',83 x 22',11 M<sup>ld</sup>

Scale  $\frac{1}{100}$

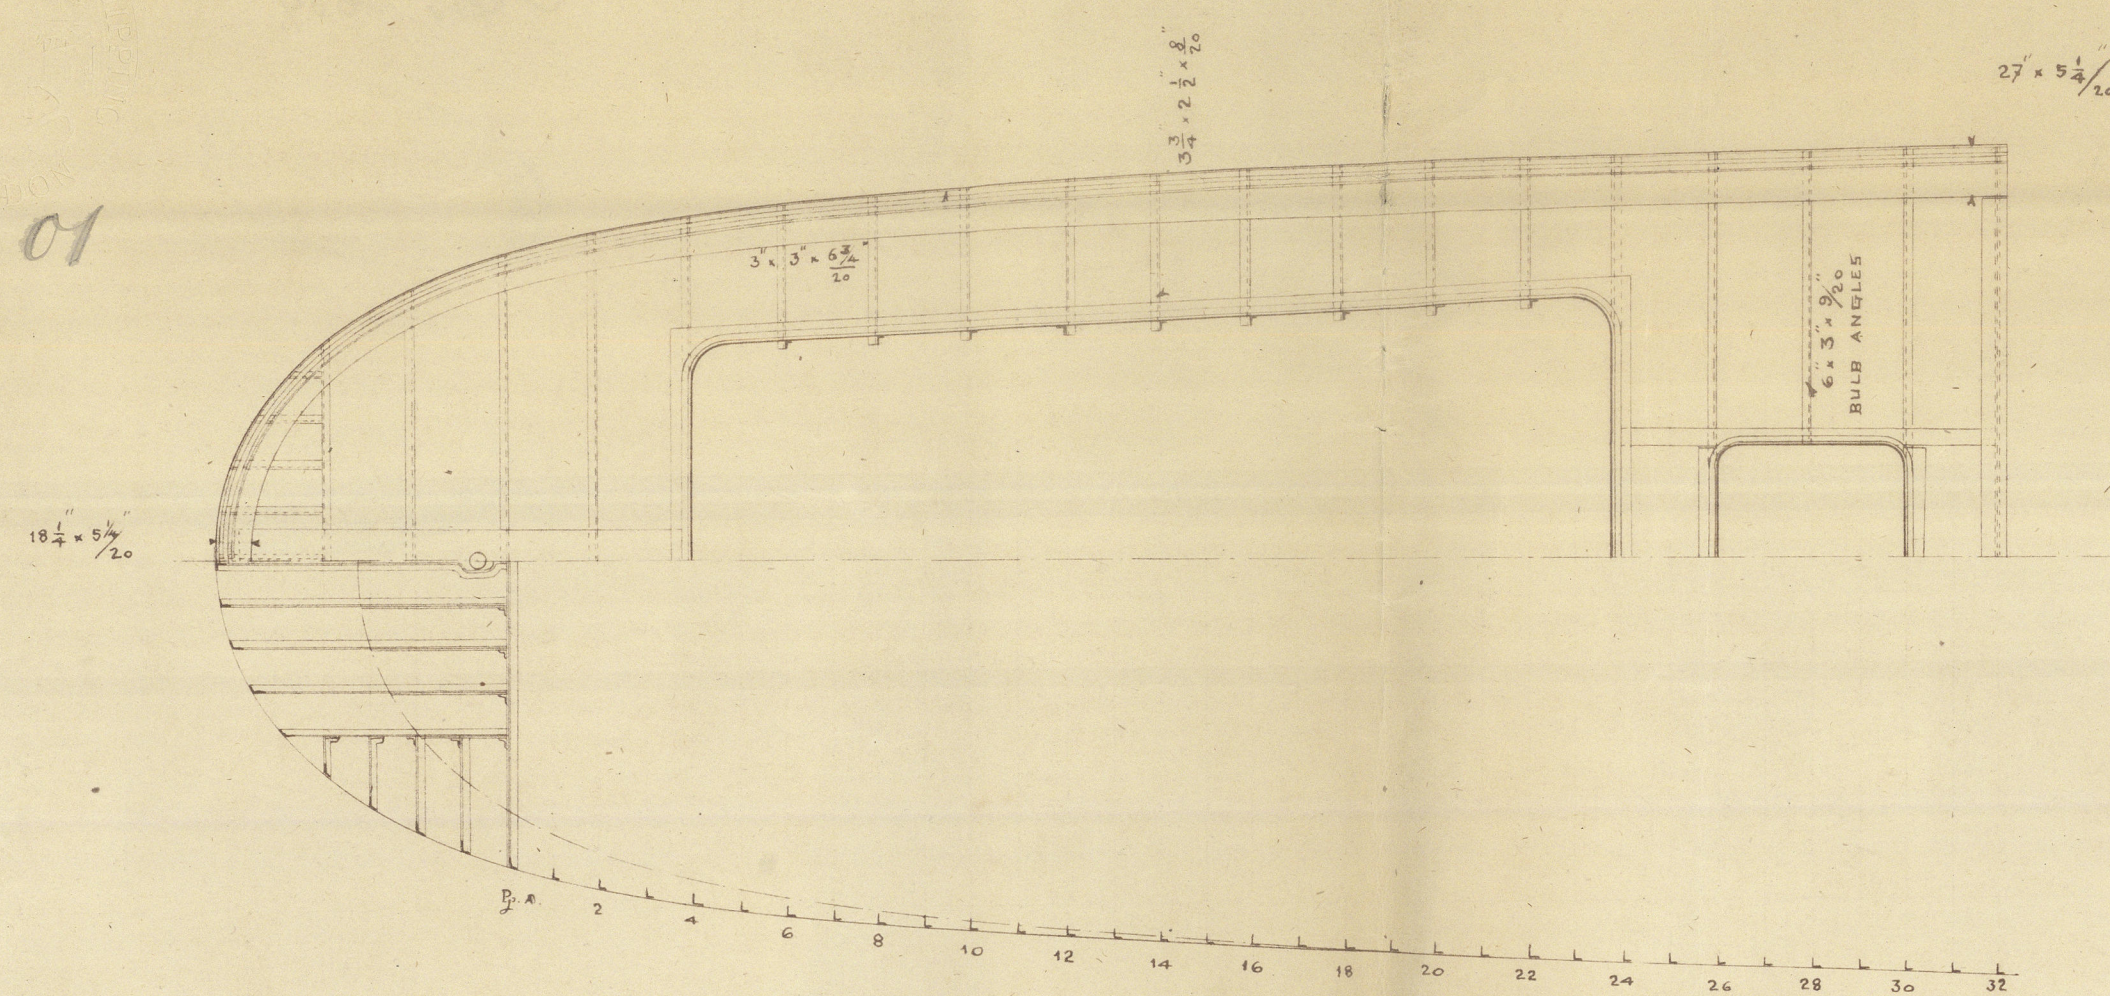


25/10/01



Profile & Deck plan

Antonio Padre

Gen 2639.

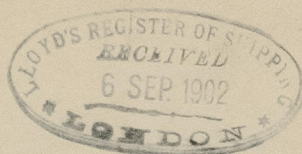

© 2020

Lloyd's Register  
Foundation

005877-005889-0221