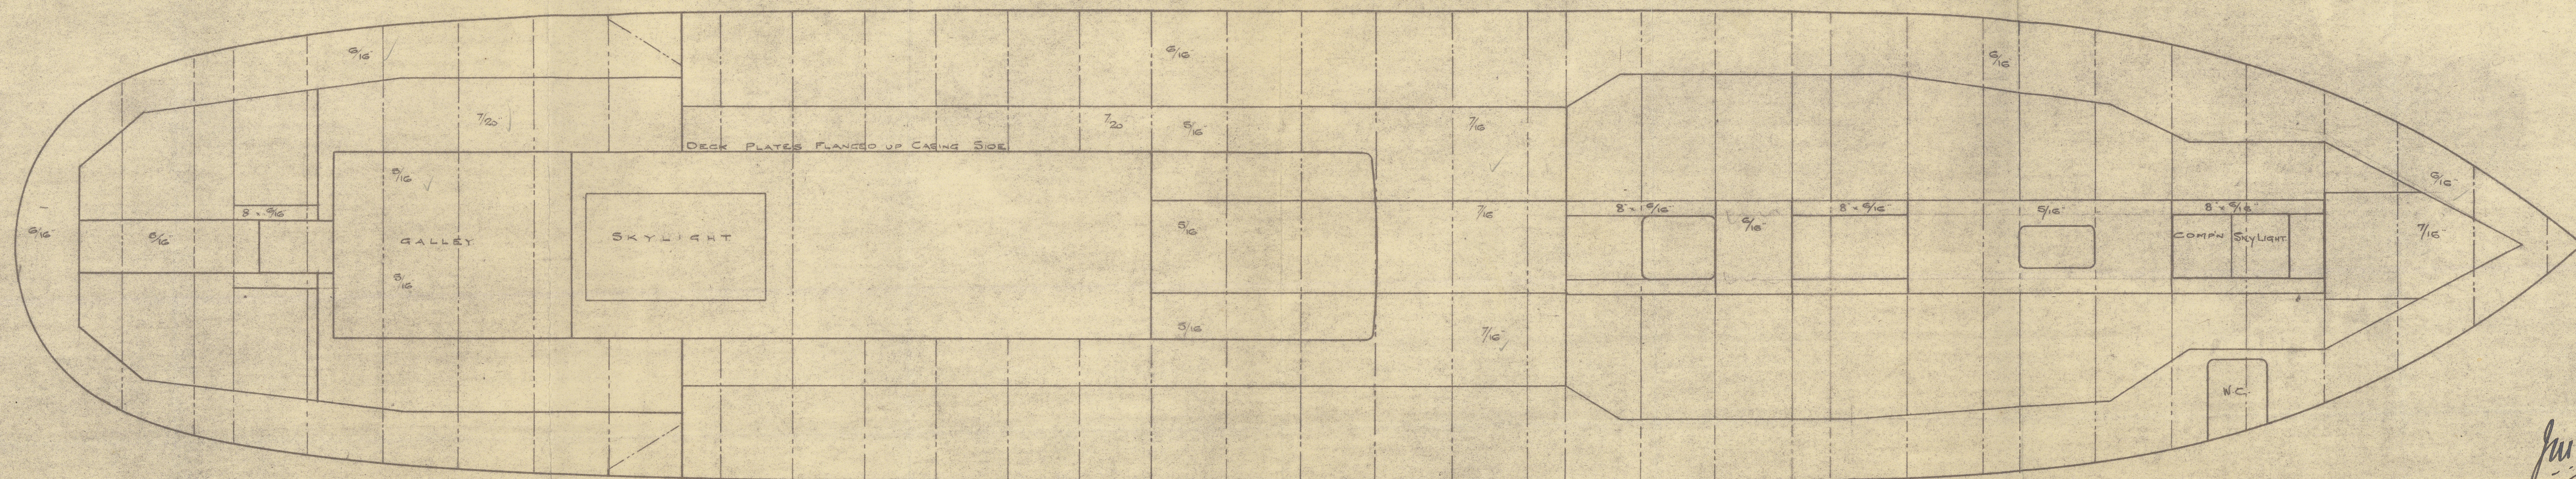


—N^{OS} 625-6—
—PROFILE & DECK PLAN—
DIMS 115'-6" B.P. × 22'-6" EX. × 13'-2" MLD.

[illegible]


Ju
 20.7.14

Cochrane 625-6

Profile & Deck

S.S. "Everton Hull Kpt No. 28625.

" " " " " 28647

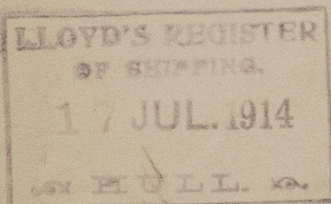

© 2020

Lloyd's Register
Foundation

005901-005913-0218