

PLAN No. 4539

FOR ENCLOSURE TO
MESSRS LLOYDS SURVEYOR.

HULL FROM
COCHRANE & SONS, LTD.
SHIPBUILDERS, SELBY
DATE 14/7/14

-MIDSHIP SECTION-

-STEEL SCREW FLEETERS-

-N^{OS} 625-6-


-DIMS 115'-6" B P x 22'-6" EX x 13'-2" MLD -

SCALE 1/2"

TO CLASS 100 A1 LLOYDS STEAM TRAWLER.

DECK PLATED OVER IN WAY OF MACHINERY.

ENGINE & BOILER CASING AS PREVIOUSLY APPROVED.

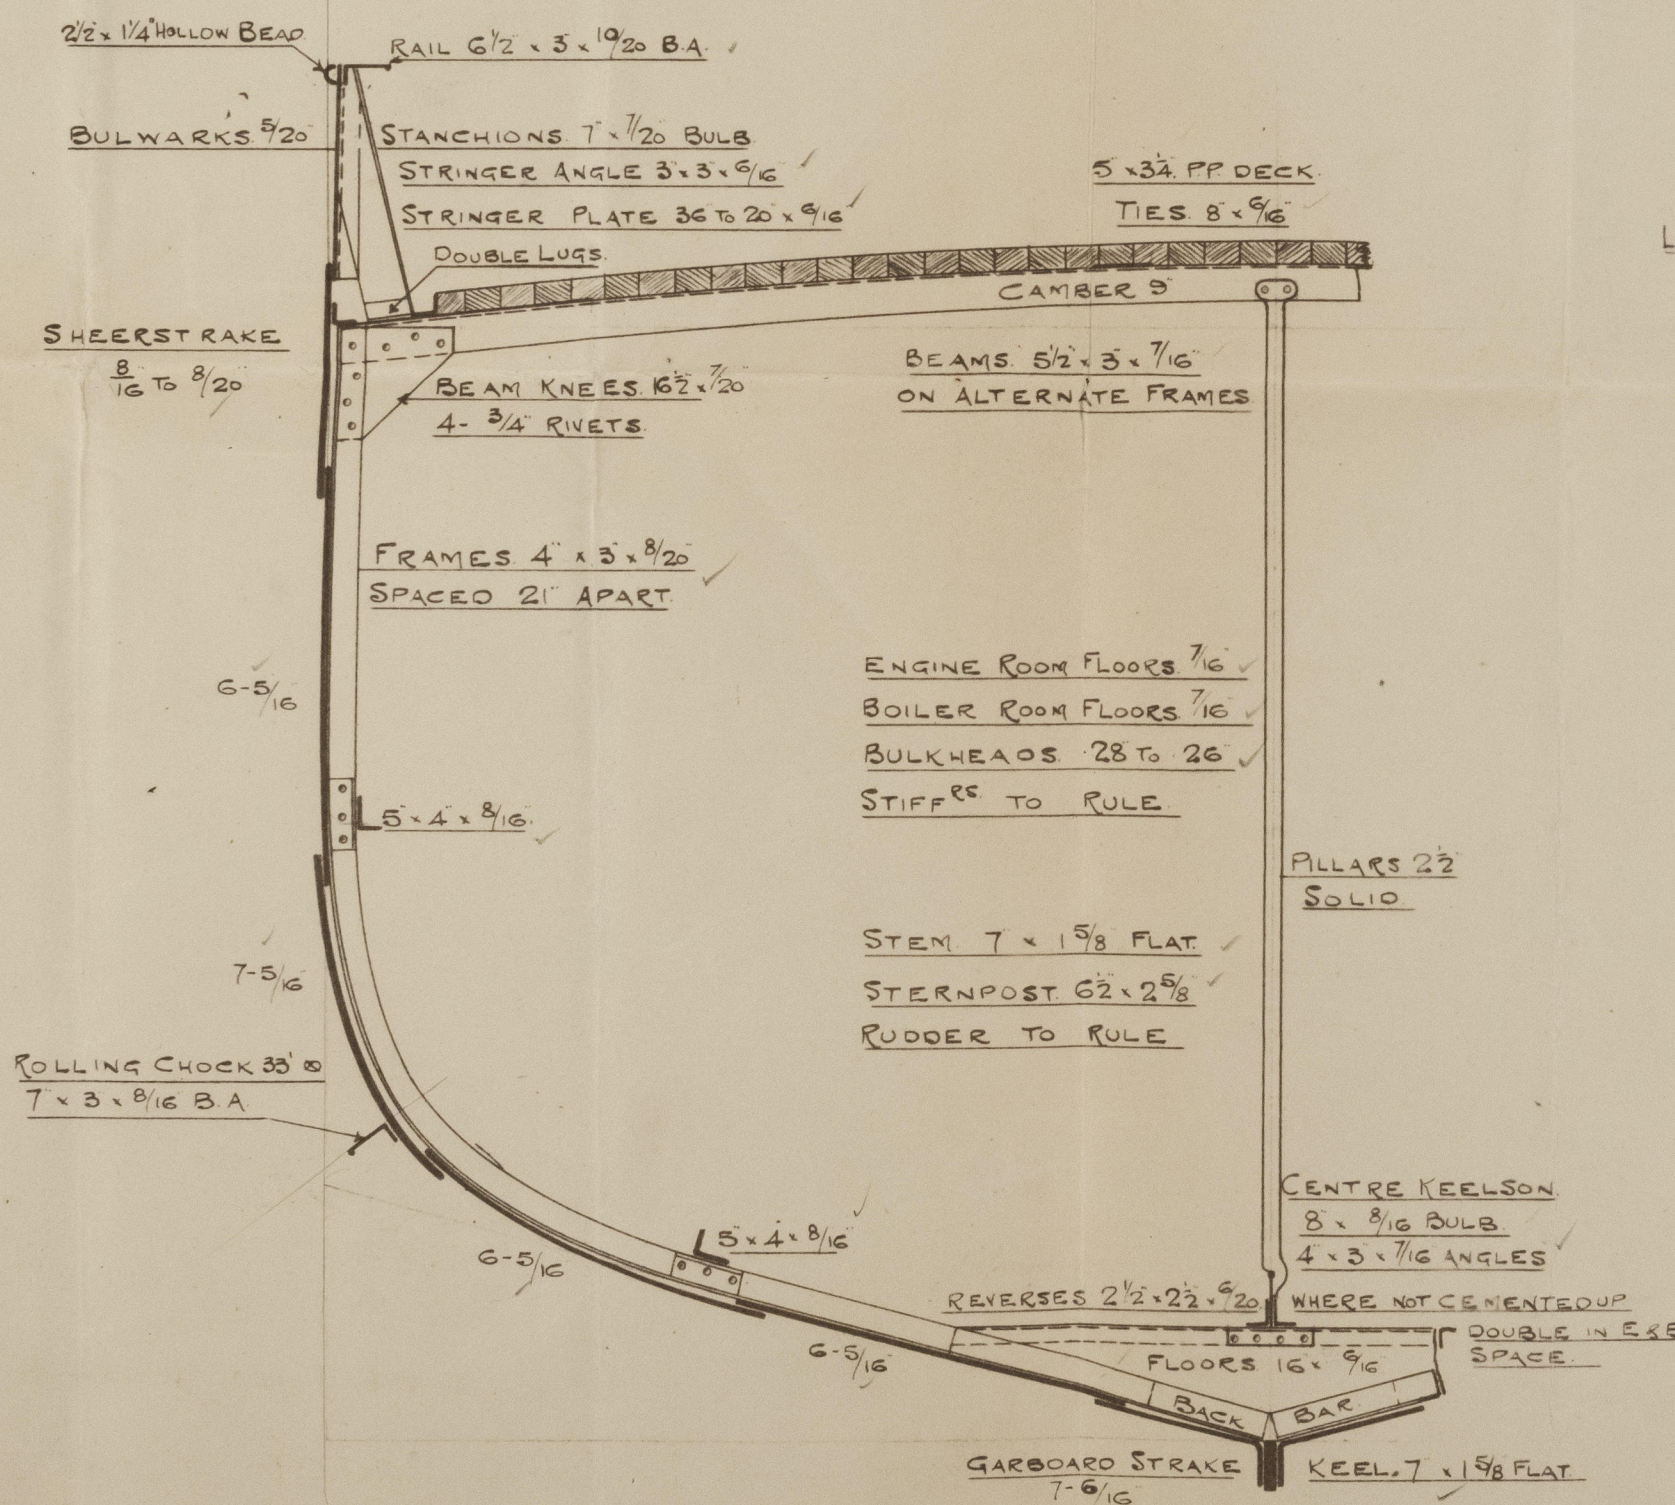

NUMERALS.

B + D ----- 35.53
L B + D ----- 4103.71

PROPORTIONS.

L ----- 5.16
B ----- 8.77
D -----

EQUIPMENT

1ST BOWER ANCHOR 5 1/2 CWTs EX STOCK 6 1/2 STOCKS ✓
2ND " 4 1/4 " " " 6 " ✓
KEGGE ANCHOR 2 1/2 " " " " ✓
90 FATHOMS 1" STEEL LINK CABLE ✓
60 " 6 HAWSER ✓
60 " 4 1/2 WARP ✓

RIVETING.

BUTTS OF SHELL PLATING TO BE LAPPED
AND DOUBLE RIVETTED EXCEPT GARBOARD
AND SHEERSTRAKE WHICH ARE TO BE
STRAPPED.
SHELL SEAMS DOUBLE RIVETED. ✓
BULWARK SEAM SINGLE RIVETED
RIVETS IN KEEL STEM & STERNFRAME 1" DIAM
SHELL RIVETS 3/4" DIAM.

Jul
20.7.14



© 2020

Lloyd's Register
Foundation

605901 005913-0 219


Colchrae's brs 76

Midship Section



S.S. Everton Hull Rpt No.
28625.

S.S. "Evesham" Hull Rpt
No 28647.

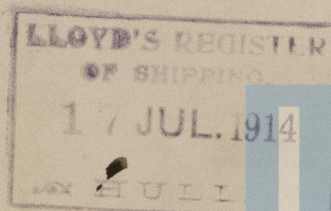

© 2020

Lloyd's Register
Foundation

005961-005913-0219